


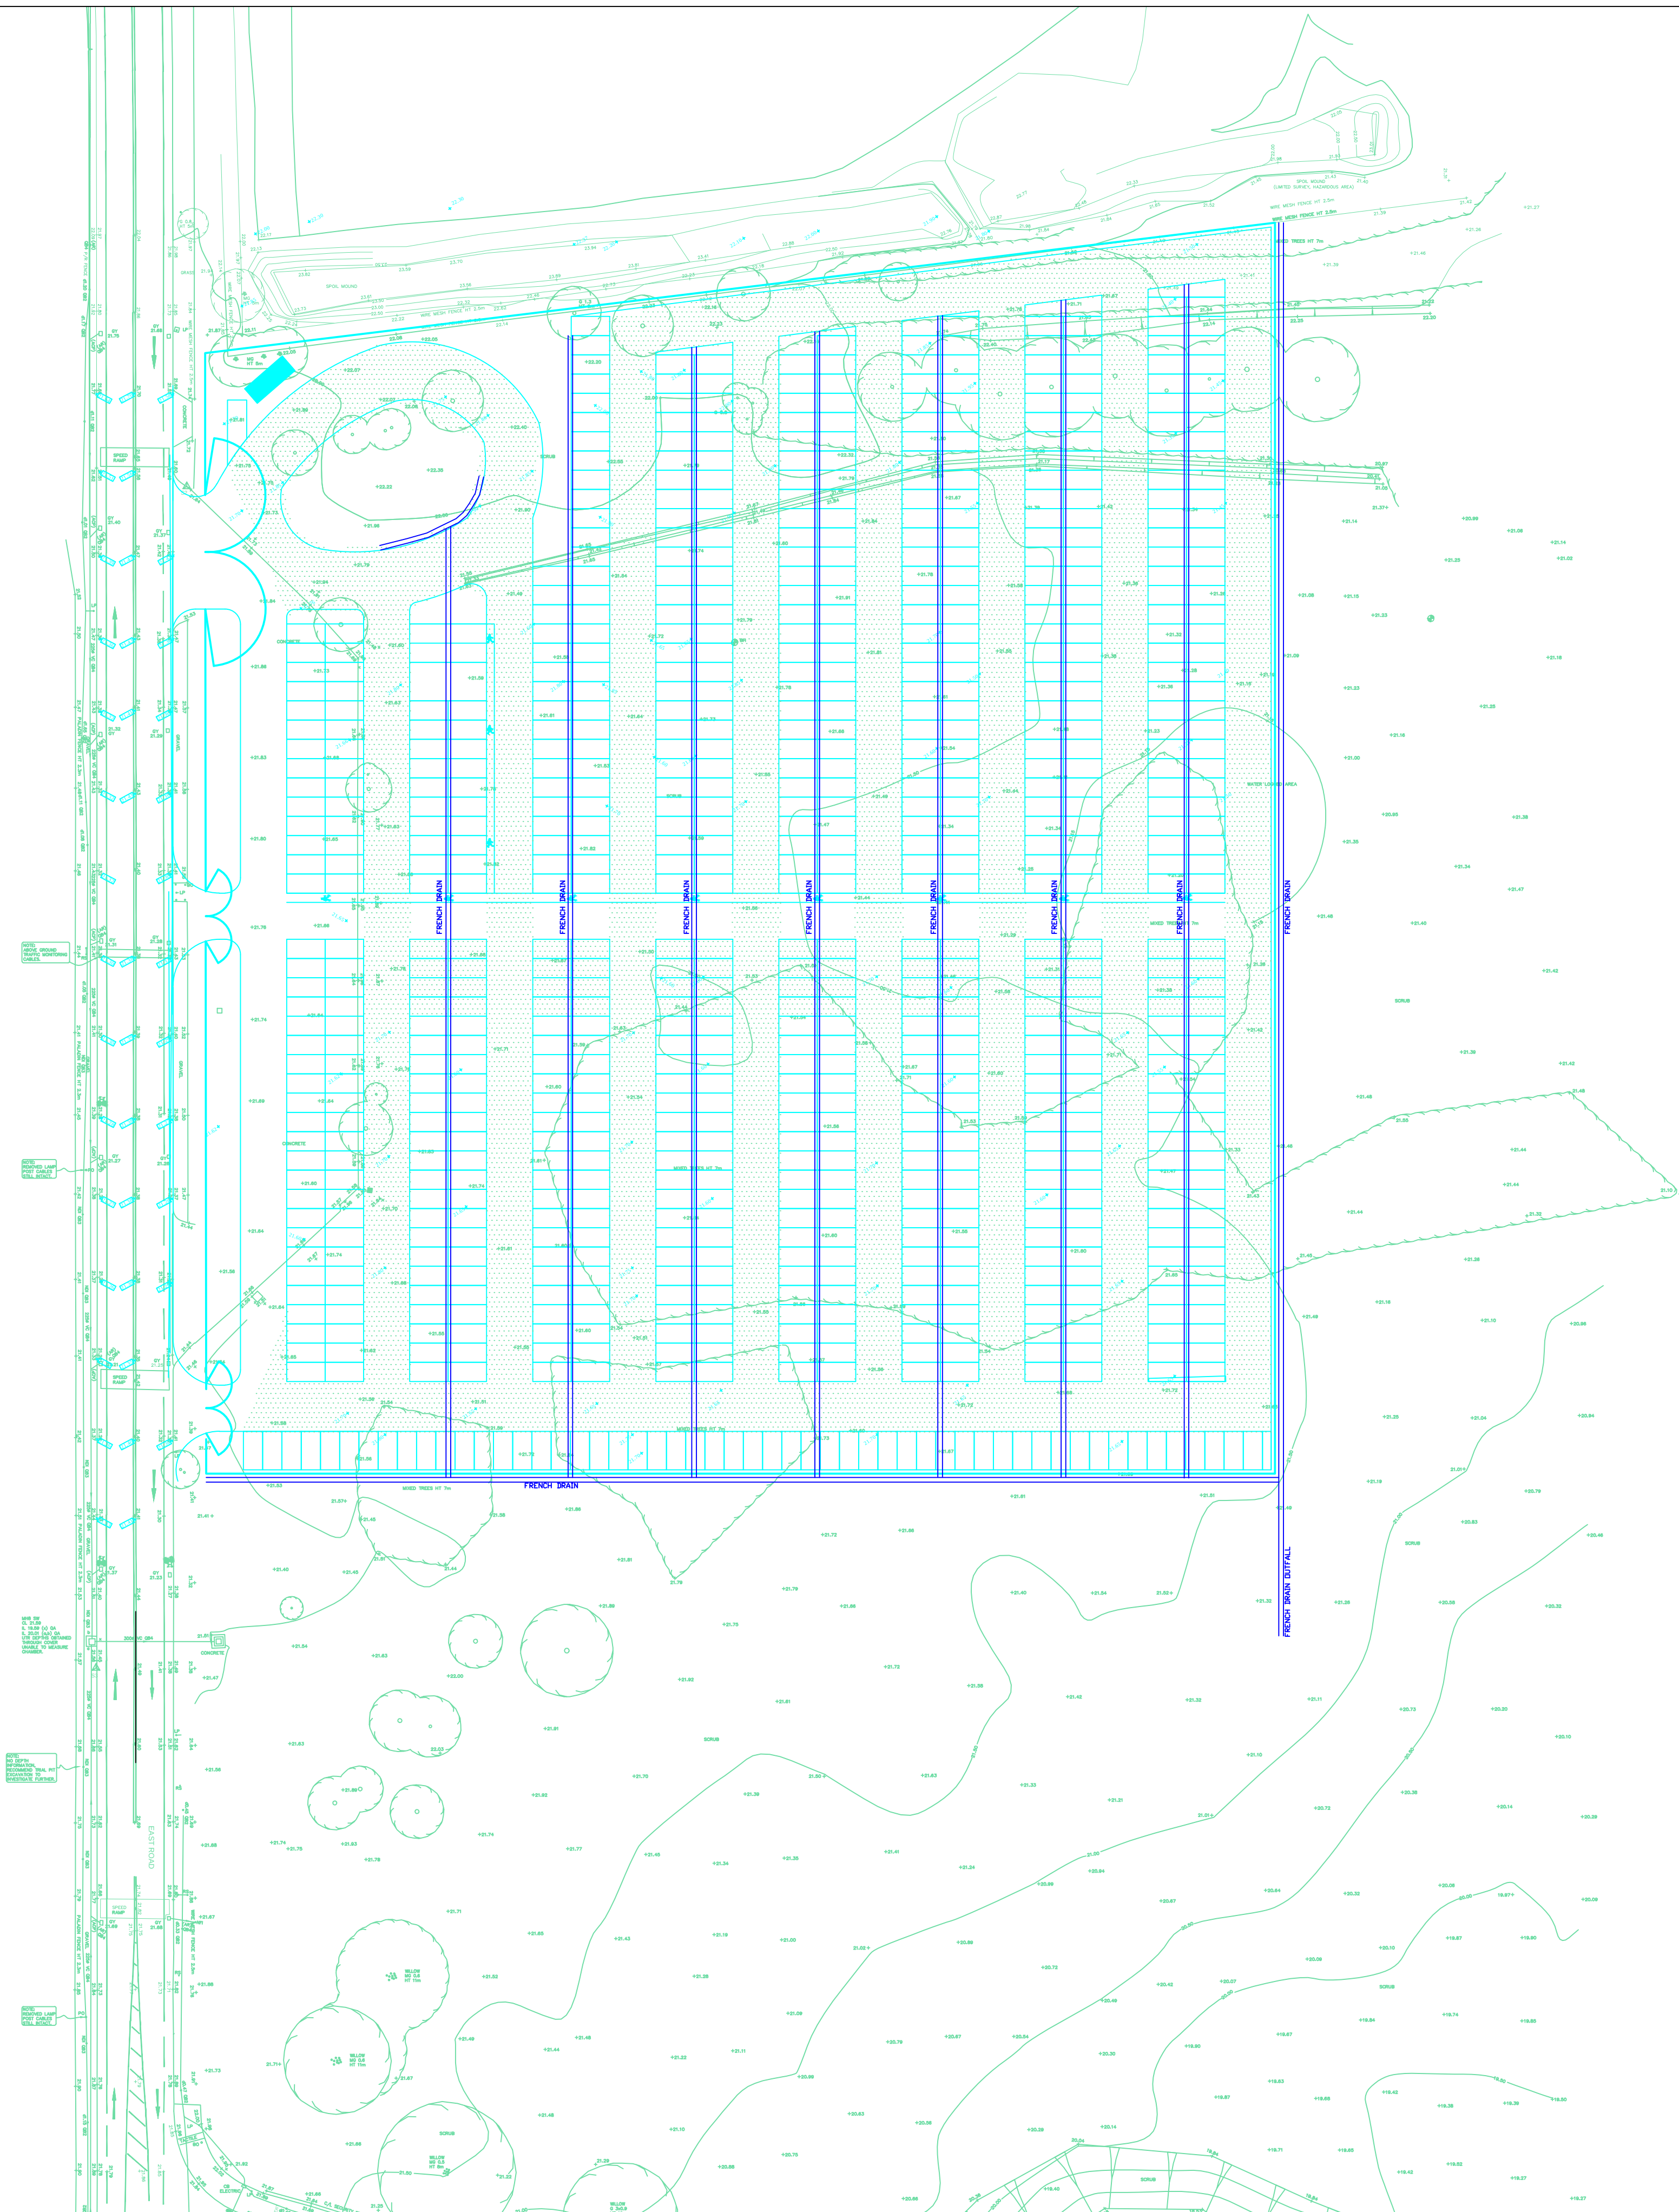

Rev.	Date	By



Catherine Street
Aston
Birmingham
B6 5RS
Tel: 0121 326 8500
Fax: 0121 326 8838
Website: www.mcdermotts.co.uk
E-mail: steve.love@mcdermotts.co.uk

DRAWING TITLE	
Drainage Eastlands As Built	
SITE	
JLR, Halewood	
SCALE:	1 : 250 @ A1
DRAWN BY:	S.L.
DATE:	28/09/2016
JOB No	C430-SL14
REV.	