






As-Built Side Elevation

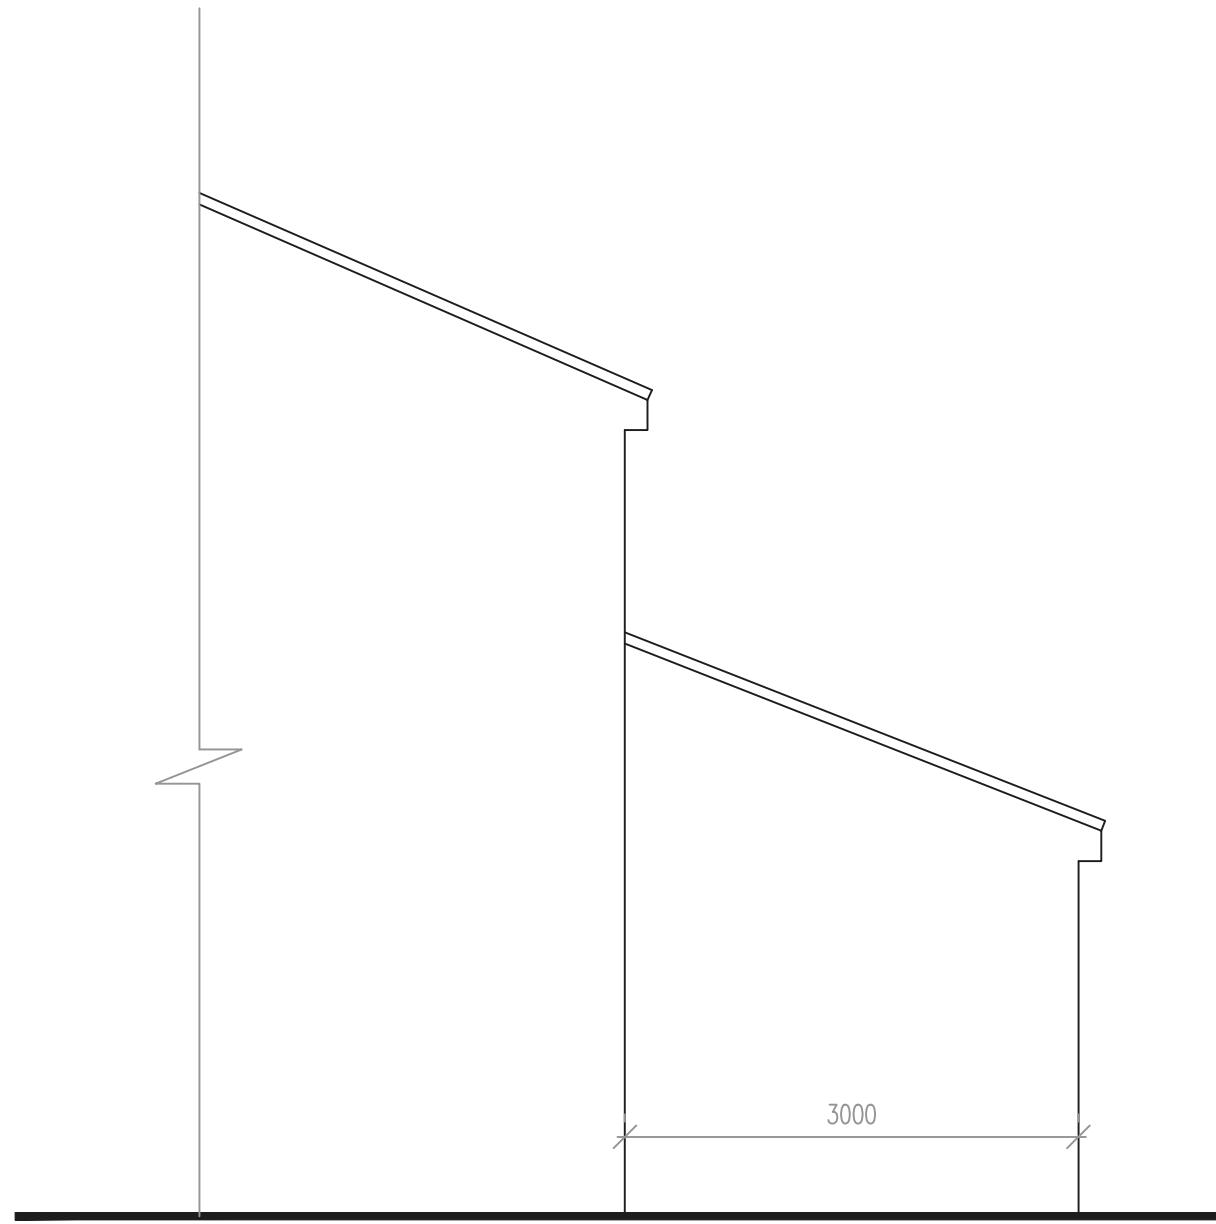


As-Built Rear Elevation

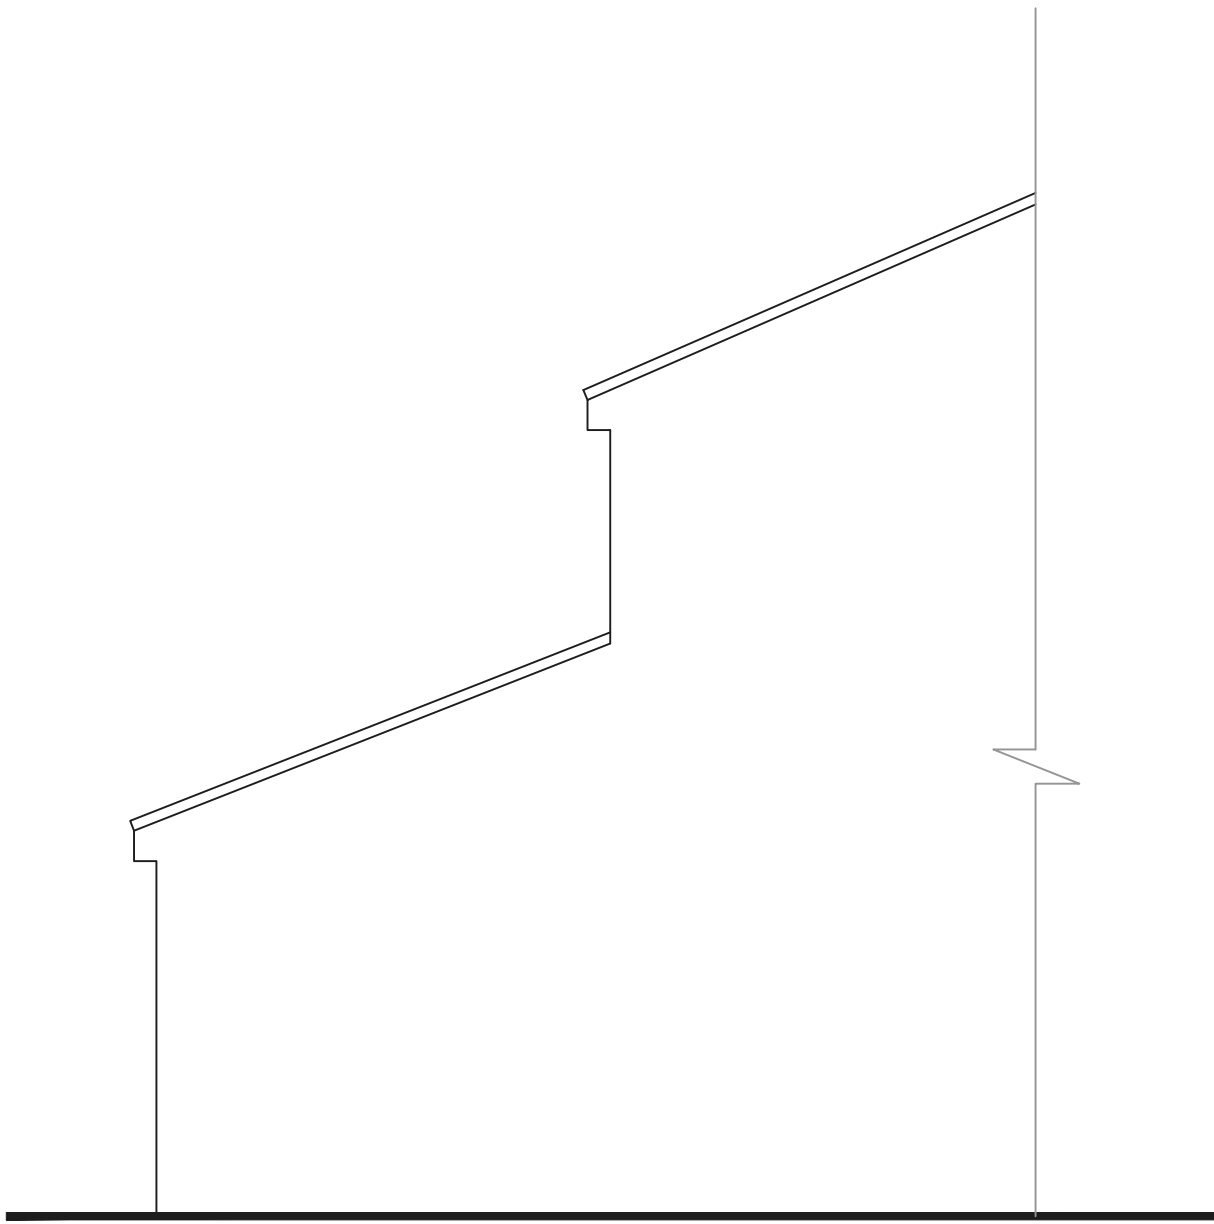

As-Built Side Elevation

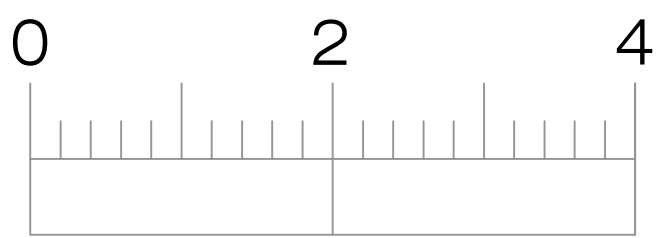

Scale Bar

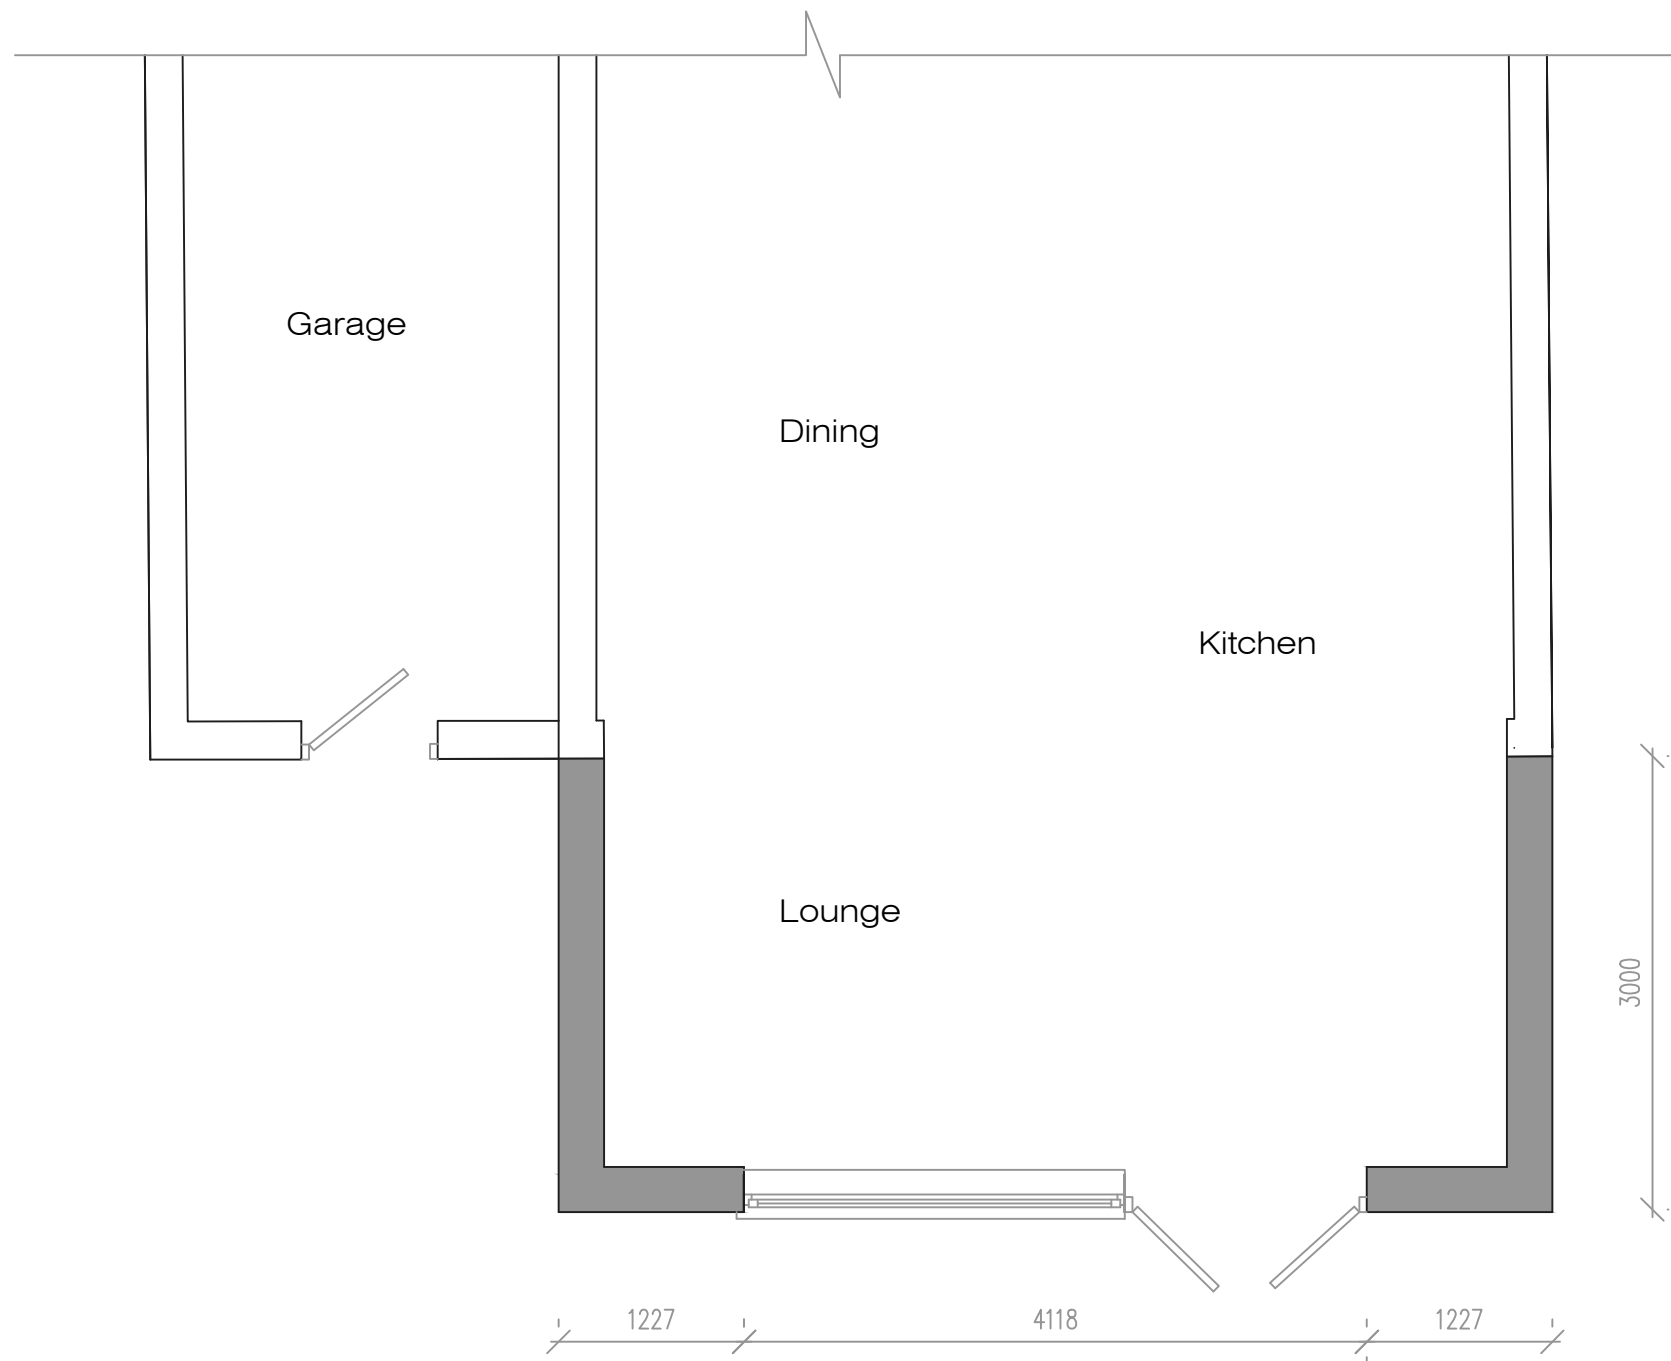

As-Built Ground Floor Plan

Address				
17 Tavington Road, L26				
Job Title				
Single storey extension to rear				
Drawing title				
As Built Plans				
Chkd	Appvd	date	scale	Dwg No.
		Nov '25	1:50 @ A1	002