



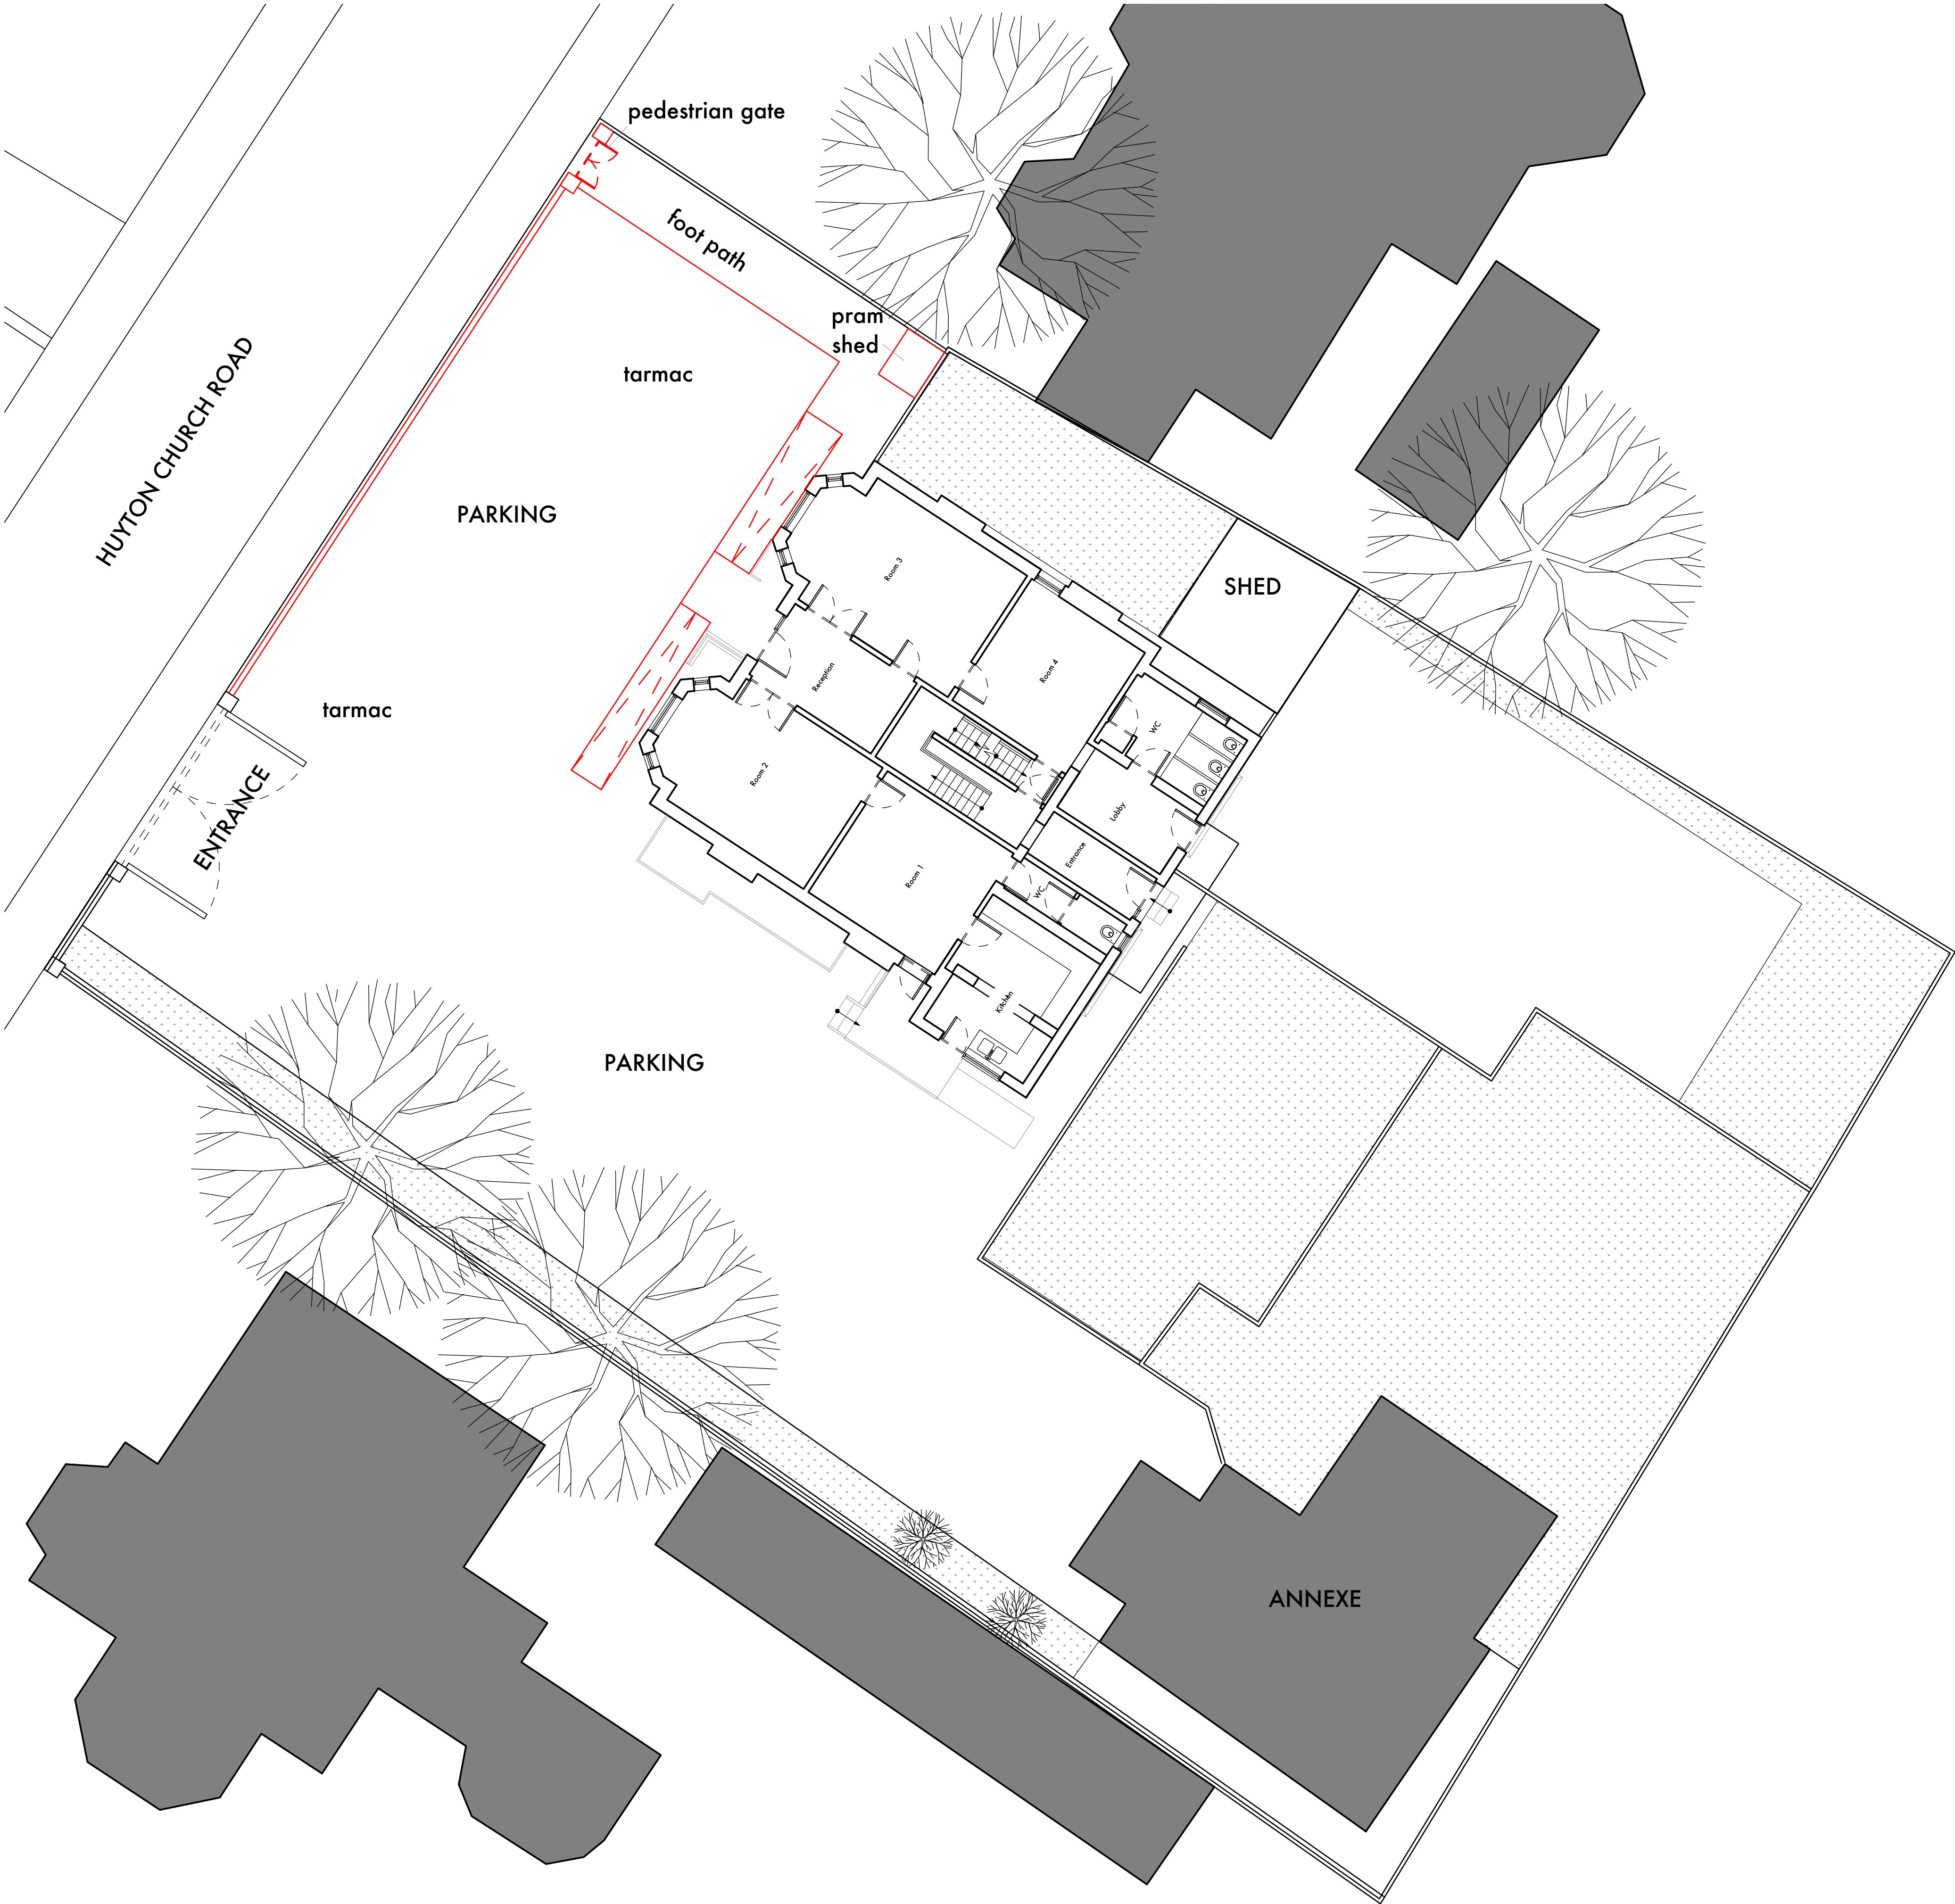

All dimensions are to be checked on site prior to commencing works on site. Discrepancy found between information given on this drawing and that given elsewhere or recorded on site shall be notified immediately to the project architect in writing

PLANNING ISSUE

all details and dimensions tbc with contractor

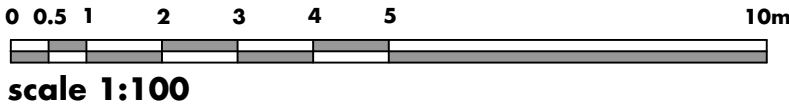

SITE BOUNDARY:



- Site boundary assumed and indicated as shown based OSMAF only
- Should exact clarification of boundary be required then a third party boundary professional must be appointed
- All Existing structure, eaves, gutters etc. to be within assumed boundary at all times

JOB TITLE :
Beech House,
10 Huyton Church Road,
Huyton,
L36 5SJ

DWG TITLE :
Site Plan as Built

REVISION NOTES:
rev A: updated following notes from planning

DWG. NO. :

159-01-A

SCALE :

1:100(@A1)

DATE:

29.10.24

