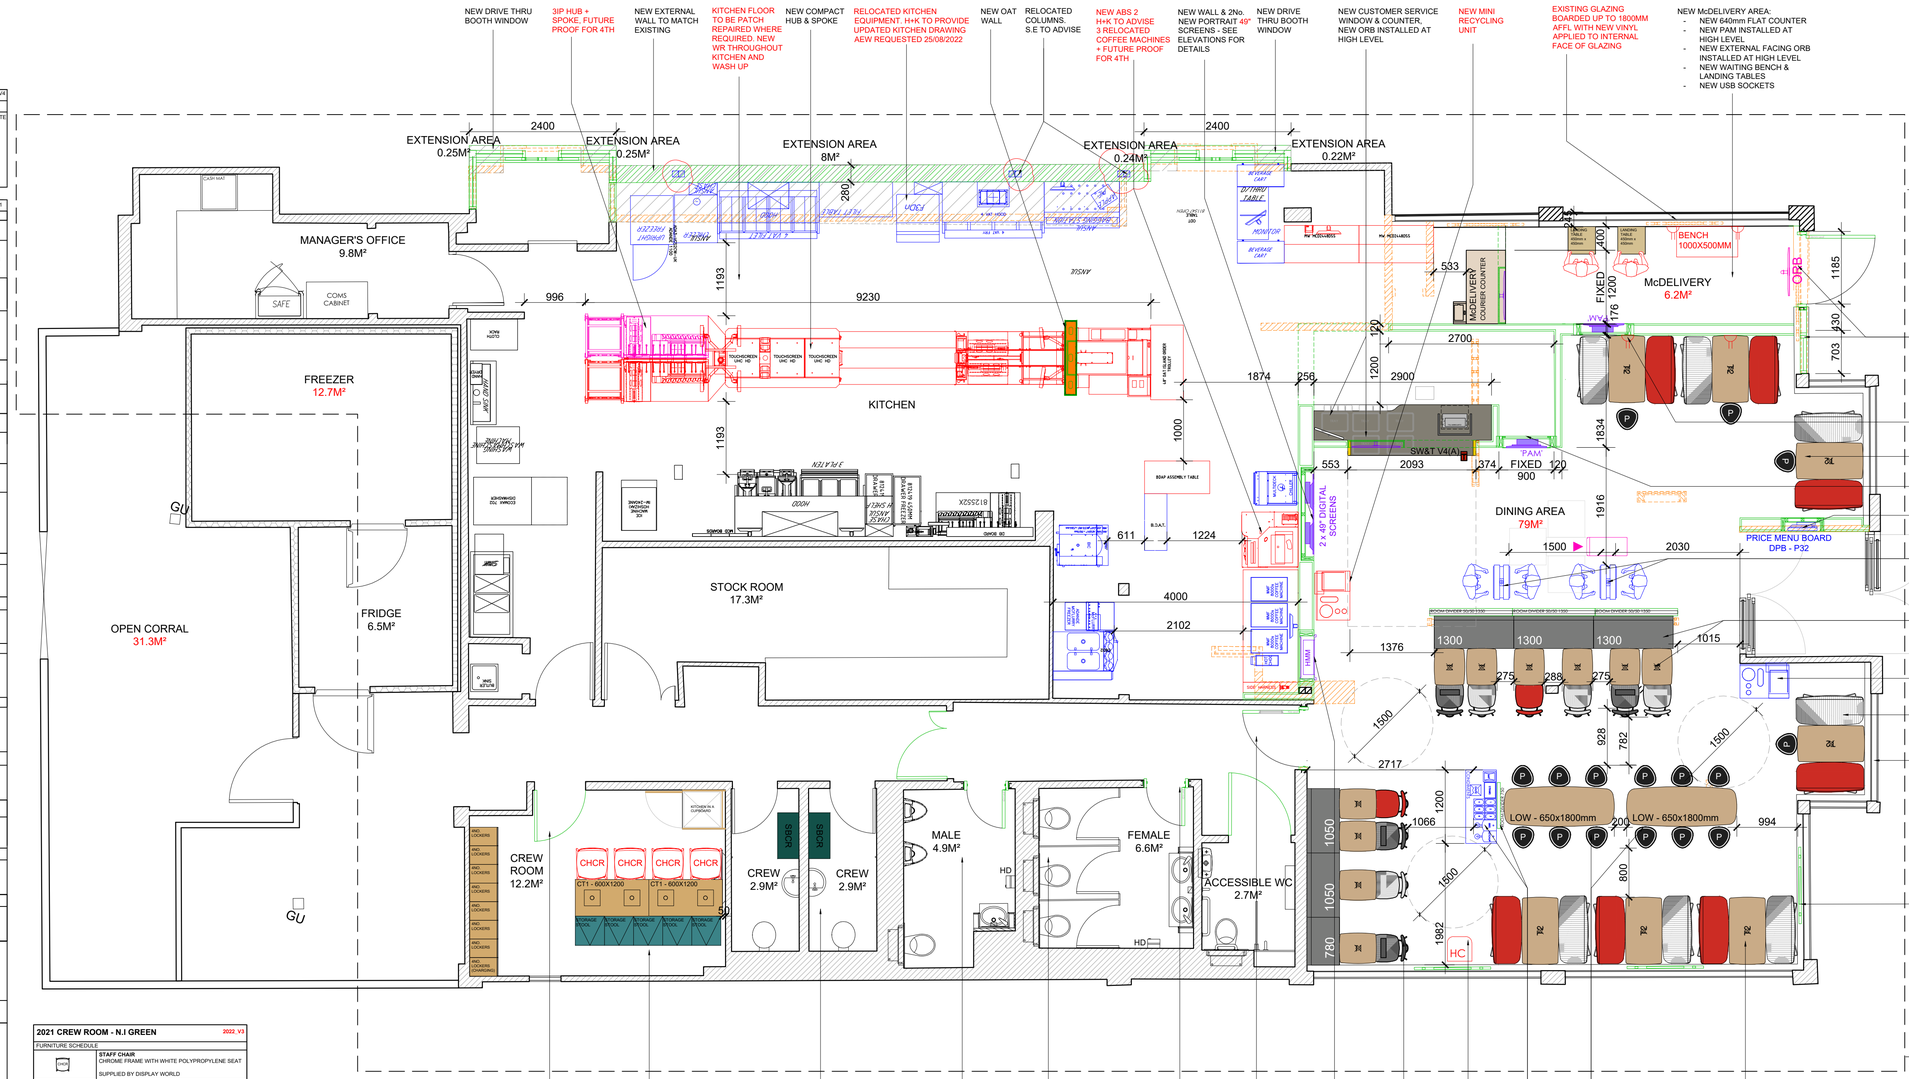



## NOTES

- All dimensions and levels are to be checked on site.
- Any discrepancies are to be reported to the architect before any work commences.
- This drawing shall not be scaled to ascertain any dimensions. Work to figured dims only.
- This drawing shall not be reproduced without express written permission from AEW.
- Title overlay drawings and ownership boundaries are produced using all reasonable endeavours. AEW cannot be responsible for the accuracy or scale discrepancy of base plans supplied to them.
- All works are to be undertaken in accordance with Building Regulations and the latest British Standards.
- All proprietary materials and products are to be used strictly in accordance with the manufacturers recommendations.

## CDM 2015

Client notified of duties: **At Design Workshops**

Principal Designer: **CSS**

Unless noted below, all known hazards have been highlighted on the drawing:

Notes:
All drawings to be read in conjunction with all other drawings as noted on issue sheet.

GEOMETRY - FURNITURE 2019_V4

EXISTING FURNITURE

- ALL EXISTING FURNITURE INDICATED BY BLACK & WHITE
- EXISTING FURNITURE RELOCATED INDICATED BY 'x'
- RE-UPHOLSTERED FURNITURE INDICATED BY 'R'
- RE-UPHOLSTERED AND RELOCATED FURNITURE INDICATED BY 'R*'

GEOMETRY - FURNITURE 2019_V1

| SYMBOLS | REFERENCES |
|---|---|
| | CHAIRS LAMINATE OR GRAPHIC PRINTED ON PLYWOOD LAMINATED<br>AVAILABLE IN 3 NO. FINISHES<br>RED - ABET LAMINATI - ROSSO TANGO - 823<br>WHITE GRAPHIC - WHITE GEOMETRY GRAPHIC PATTERN<br>BLACK GRAPHIC - BLACK GEOMETRY GRAPHIC PATTERN |
| | STOOLS & POUFS<br>(H) COMMUNAL HIGH PEDESTALS - FLOOR FIXED<br>(L) COMMUNAL LOW PEDESTALS - FLOOR FIXED<br>(P) LOW POUFS - LOOSE<br>AVAILABLE IN 1NO. FINISH:<br>PEDESTAL: BLACK POWDER COATED STEEL RAL 9005 (BLACK GLOSS LEVEL 15-20% MATT FINISH) WITH WHITE GEOMETRICAL GRAPHIC PATTERN<br>SEAT PAD: BLACK HILLS VINYL FA16 |
| | BENCH SEATS(780MM/1050MM/1300MM) - TBC<br>BENCH ON WALL OR PARTITION (spaced 25mm off) |
| | AVAILABLE IN 1NO. FINISH:<br>LIGHT GREY - FORMICA - MOUSE 928 |
| | BENCH SEATS WITH SEAT PAD (780MM/1050MM/1300MM)<br>**BENCH ON WALL ONLY** |
| | AVAILABLE IN 1NO. FINISH:<br>LIGHT GREY - FORMICA - MOUSE 928<br>SEAT PAD: ATN - 238x2179<br>250x1240/990/720mm TBC |
| | BENCH SEAT 1100MM<br>BACK TO BACK GAP TO BENCHES - MIN 120MM |
| | AVAILABLE IN 2NO. FINISHES:<br>BLACK GRAPHIC - PRINTED GEOMETRY PATTERN<br>RED - ABET LAMINATI - ROSSO TANGO - 823<br>SEAT PAD: ATN - 238x2179; SIZE 240x1040mm TBC |
| | T1 TABLE 600x500MM / TOP HEIGHT : 750MM<br>AVAILABLE IN 1 NO. FINISH:<br>TOP LAMINATED FORMICA AGED ASH NATURALLE F8844-NT LAMINATE ON PLYWOOD<br>EXPOSED / STEEL LEG WITH GRAPHIC |
| | T2 TABLE 1100x600MM / TOP HEIGHT : 750MM<br>AVAILABLE IN 1 NO. FINISH:<br>TOP LAMINATED FORMICA AGED ASH NATURALLE F8844-NT LAMINATE ON PLYWOOD<br>EXPOSED / STEEL LEG WITH GRAPHIC |
| | PARTITION STANDUP 4<br>TOP LAMINATED FORMICA AGED ASH NATURALLE LAMINATE ON PLYWOOD<br>EXPOSED / STEEL LEG WITH GRAPHIC<br>FIN WALLS: TBC |
| | PARTITION STANDUP 2<br>TOP LAMINATED FORMICA AGED ASH NATURALLE LAMINATE ON PLYWOOD<br>EXPOSED / STEEL LEG WITH GRAPHIC<br>FIN WALLS: TBC |
| | MAGIC TABLE<br>AVAILABLE IN 1 NO. FINISH:<br>TOP LAMINATED WHITE RESOPAL 0105-60 Pearl White LAMINATE ON PLYWOOD + EDGE PLYWOOD<br>EXPOSED / STEEL LEG WITH GRAPHIC |
| | MAGIC TABLE<br>AVAILABLE IN 1 NO. FINISH:<br>TOP LAMINATED WHITE RESOPAL 0105-60 Pearl White LAMINATE ON PLYWOOD + EDGE PLYWOOD<br>EXPOSED / STEEL LEG WITH GRAPHIC |
| | COMMUNAL TABLE (850/650x1200/1800/2400/3000MM) |
| | AVAILABLE IN 1 NO. FINISH:<br>TOP LAMINATED FORMICA AGED ASH NATURALLE F8844-NT LAMINATE ON PLYWOOD<br>EXPOSED / STEEL LEG WITH GRAPHIC |
| | SIT UP (LOW 750mm/ HIGH 1100mm) |
| | AVAILABLE IN 1 NO. FINISH:<br>TOP LAMINATED FORMICA AGED ASH NATURALLE F8844-NT LAMINATE ON PLYWOOD - TBC<br>EXPOSED / STEEL LEG WITH GRAPHIC |
| | FEATURE MMFS SIT-UP TABLE (1100mm HIGH) WITH SOLID PLYWOOD EDGES IN SNO. SIZES:<br>1200X500mm (2NO. STOOLS)<br>1800x500mm (3NO. STOOLS)<br>2400x500mm (4NO. STOOLS)<br>3000X500mm (5NO. STOOLS)<br>**POWER REQUIRED FOR FEATURE LIGHTING**<br>AVAILABLE IN 1NO. FINISH:<br>TBC |
| | PARTITIONS:<br>FRAME PARTITION (1350mm/1100mm): LOW WALL/ PICTURE FRAMES ABOVE<br>ROOM DIVIDER 50/50 (1350mm/1100mm): LOW WALL/ GLASS ABOVE WITH DECALS<br>ROOM DIVIDER (750mm): FULL HEIGHT GLASS WITH DECALS |

MARKETING ELEMENTS 2016_V4

| | |
|---|---|
| | DIGITAL PRICE BOARD - 32"<br>DPB-P32 |
| | DIGITAL WINDOW POSTER (INSTORE) - 46"<br>EXTERIOR FACING - DWP-EX-P46<br>INTERIOR FACING - DWP IN-P46 |
| | CURVED CRADLE DIGITAL MENU BOARDS (OTS&SINGLE BEVERAGE CELL- PORTRAIT) - 40"<br>MB-P40/ P46 (REFER TO ARCHITECTS GA_DWG 50) |
| | DIGITAL MENU BOARDS (ANY EXISTING BUILDING TYPE) - 40"<br>MB-L40<br>TYPE.A - 9NO. CURVED TV'S, R3097<br>TYPE.A2 - 5NO. CURVED TV'S, R2566<br>TYPE.B - 5NO. CURVED TV'S, R2034<br>TYPE.C - 4NO. CURVED TV'S, R2566<br>TYPE.D - 4NO. CURVED TV'S, R3665<br>TYPE.E - 4NO. CURVED TV'S, R3552<br>TYPE.F - 5NO. STRAIGHT TV'S |
| | McCAFÉ SCREEN (PORTRAIT) - 40"<br>MS-P40 |
| | ORDER READY BOARD- 32"<br>ORB-L32 |
| | DOUBLED SIDE SELF ORDER KIOSK (SOK) |
| | SINGLE SIDED SELF ORDER KIOSK (SOK) |
| | AIRCHARGE<br>MOBILE PHONE CHARGING SOLUTION. |
| | TABLET TABLE, 700mm SCREEN IN SCHEME SPECIFIC LAMINATE IF POWER/DATA CANT BE ACCESSED THROUGH FLOOR. |

COLOUR REFERENCE

- NEW EQUIPMENT/FURNITURE (OR INDICATED BY COLOURED HATCH)
- EXISTING/FURNITURE EQUIPMENT
- RELOCATED/FURNITURE EQUIPMENT
- FUTURE/OPTIONAL EQUIPMENT
- MERCHANDISING EQUIPMENT
- NEW CONSTRUCTION
- EXISTING STRUCTURE TO BE REMOVED
- EXISTING 30 MINUTE FIRE RATE WALL
- EXISTING 60 MINUTE FIRE RATE WALL
- PROPOSED 30 MINUTE FIRE RATE WALL
- PROPOSED 60 MINUTE FIRE RATE WALL

2021 CREW ROOM - N.I GREEN 2022_V3

FURNITURE SCHEDULE

| | |
|---|---|
| CHAIR | **STAFF CHAIR**<br>CHROME FRAME WITH WHITE POLYPROPYLENE SEAT<br>SUPPLIED BY DISPLAY WORLD |
| STOOL | **HIGH STOOL**<br>CHROME FRAME WITH WHITE POLYPROPYLENE SEAT<br>SUPPLIED BY DISPLAY WORLD |
| | **TABLE 1200 x 600mm**<br>POWDER COATED BLACK PEDESTAL CT1<br>TABLE TOP FINISHED IN FORMICA LAMINATE NEVADA OAK F8588<br>**TABLE 600 x 600mm**<br>POWDER COATED BLACK PEDESTAL CT2<br>TABLE TOP FINISHED IN FORMICA LAMINATE NEVADA OAK F8588<br>SUPPLIED BY DISPLAY WORLD. |
| PCU | **PC UNIT**<br>BLACK FRAME WITH M10 CONUNTERSUNK HOLES, WHITE LAMINATE WORK TOP WITH DOLKEN EDGING<br>600 L x 400 D x 1000 H<br>SUPPLIED BY DISPLAY WORLD |
| LOCKERS | **HELMSMAN LOCKERS**<br>BANKS OF 4 STANDARD OR 10 WALLET LOCKETS<br>AVAILABLE WITH OR WITHOUT USB CHARGING<br>DOOR MATERIAL - FORMICA COMPACT - RANDOM PATTERN TO MATCH VISUAL<br>1 - FORMICA - F7879 DUSTY JADE<br>2 - FORMICA - F2255 POLAR WHITE<br>MAIN BODY FINHSED IN FORMICA LAMINATE NEVADA OAK F8588 |
| STOOL | **STORAGE STOOL**<br>TOP OF STOOL UPHOLSTERED SEAT PAD - JEMO 7044.04 - VESCOM<br>STOOL BASE FORMICA LAMINATE NEVADA OAK F8588<br>SUPPLIED BY DISPLAY WORLD |
| BENCH 1200X500MM | **SIMPLE BENCH**<br>TOP OF STOOL UPHOLSTERED SEAT PAD - JEMO 7044.04 - VESCOM<br>BENCH LEGS IN FORMICA LAMINATE NEVADA OAK F8588<br>SUPPLIED BY DISPLAY WORLD - TO BE SIGNED OFF BY NW |
| KITCHEN IN A CUPBOARD | **KITCHEN IN A CUPBOARD**<br>FINISHED IN FORMICA LAMINATE NEVADA OAK F8588 |

NOTE:
AEW PRESENTED TWO OPTIONS TO FRANCHISEE AT BRIEFING MEETING, L-SHAPE BEV CELL & GALLEY BEV CELL. FRANCHISEE REQUEST TO PROCEED WITH INCREASED WIDTH GALLEY BEV CELL

FRANCHISEE REQUEST FOR NO AIRCHARGE, TABLETS OR MAGIC TABLE

| AREAS SCHEDULE | EXISTING | PROPOSED |
|---|---|---|
| TOTAL COVERS | 89 | 64 |
| DINING AREA INTERNAL AREA (m²) | 100.4m² | 79m² |
| WC INTERNAL AREA (m²) | 14.2m² | 14.2m² |
| CREW ROOM INTERNAL AREA (m²) | 12.2m² | 12.2m² |

DRAWINGS BASED ON:
AS BUILT: SGD280-1025-50_J

# PROPOSED GENERAL ARRANGEMENT PLAN 1:50

GEOMERTY
COTF & REIMAGE

| Rev | Date | Drawn by: | Checked by: |
|---|---|---|---|
| A | 22/08/2022 | PC | MW |

UPDATED FOLLOWING STAGE 1 MEETING 12/06/22
- NEW WALL WITH RELOCATED PRICE MENU BOARD TO ENTRANCE LOBBY
- NEW LOCKERS TO CREW ROOM
- NEW BENCHES TO CREW WC
- MCDELIVERY DOOR INCREASED
- NEW STACK OF HIGH CHAIRS
- NEW ABS REQUIRED
- NEW LAYOUT TO MCDELIVERY/ DINING AREA AS CONFIRMED BY M.E 24/08/2022
- RESUBMITTED FOR DWG APPROVAL

| - | 23/05/2022 | AL | MW |
|---|---|---|---|

INITIAL ISSUE

| REV | Date | Drawn by: - | Checked by: - |
|---|---|---|---|

Status: **S2** — Purpose of Issue: **FOR INFORMATION**

drawing stage: **STAGE 1**

client: **McDonald's Restaurants Ltd**

project: **LIVERPOOL ROAD, PAGE MOSS, HUYTON** — store: **1025**

drawing title: **PROPOSED GA PLAN COTF**

date **23.05.2022** drawn **AL**
scale@A1 **1:50** checked **MW**

Rev **A**
Job No **12887_AEW_1025_0050**

aew architects
0161 214 4370
www.aewarchitects.com