




Highways Update

0934 – Marled Hay, Stockbridge Village

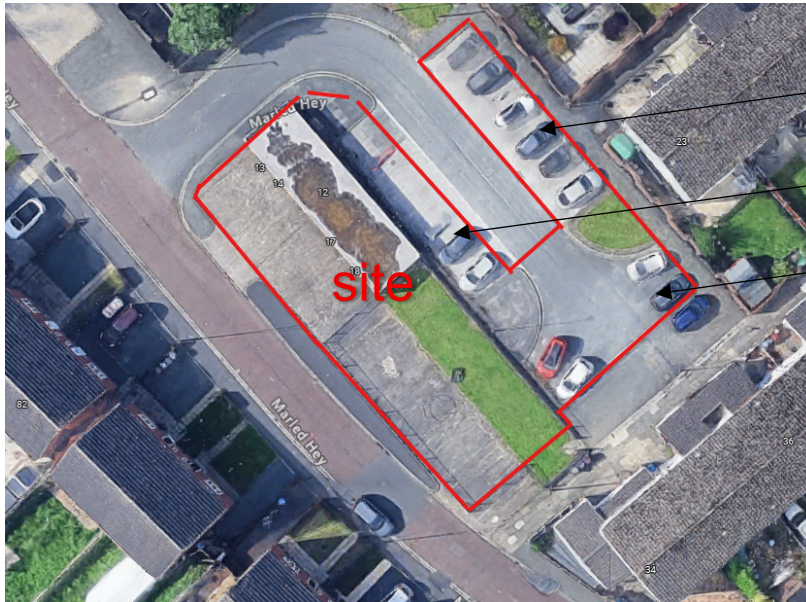

Existing site conditions

In relation to the site at Marley Hey, Stockbridge Village, the parking area to the rear of our site can accommodate a total of 14 parking spaces. These spaces are used by local residents who voiced the concerns at the public consultation which was held on 12th December 2024.


The residents raised concerns over the loss of 7 number parking spaces.



Site Plan - Proposed

Public consultation site plan

Following the public consultation, the redline boundary was extended to include the turning head to accommodate the relocation of 6 of the parking spaces to the west of the turning head resulting in the loss of 1 parking space overall.

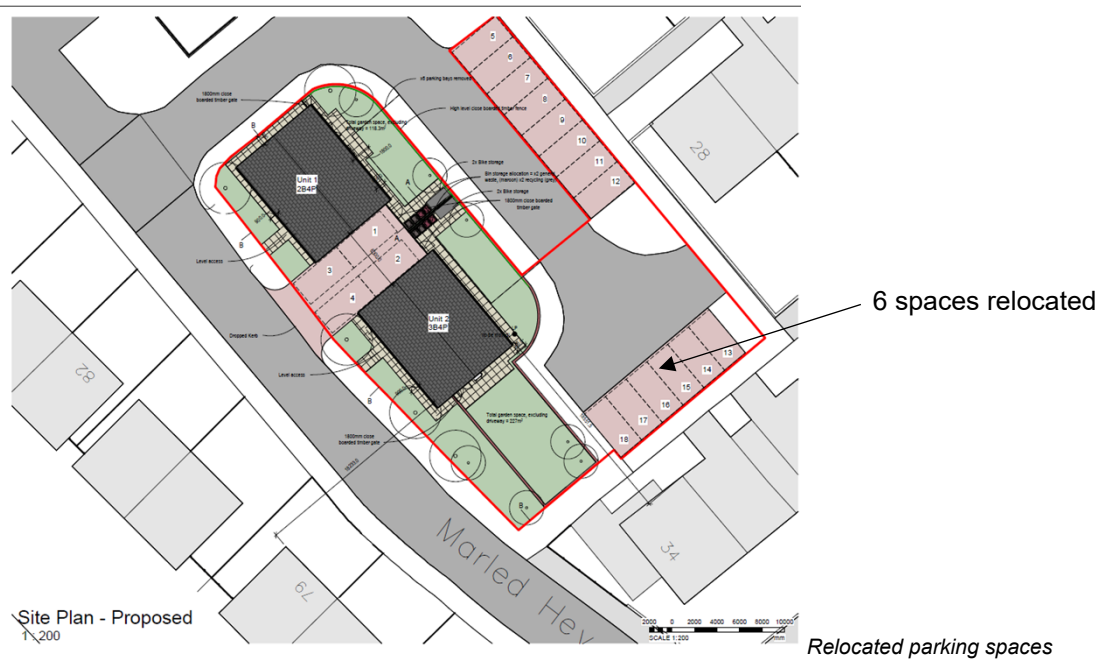

In addition, residents are currently parking within the turning head causing a highways safety issue as refuse vehicles would not be able to utilise the turning head and would have to reverse out of the site.

Our proposal although reducing the total number of parking spaces by 1 space; would have the advantage of improving highway safety.