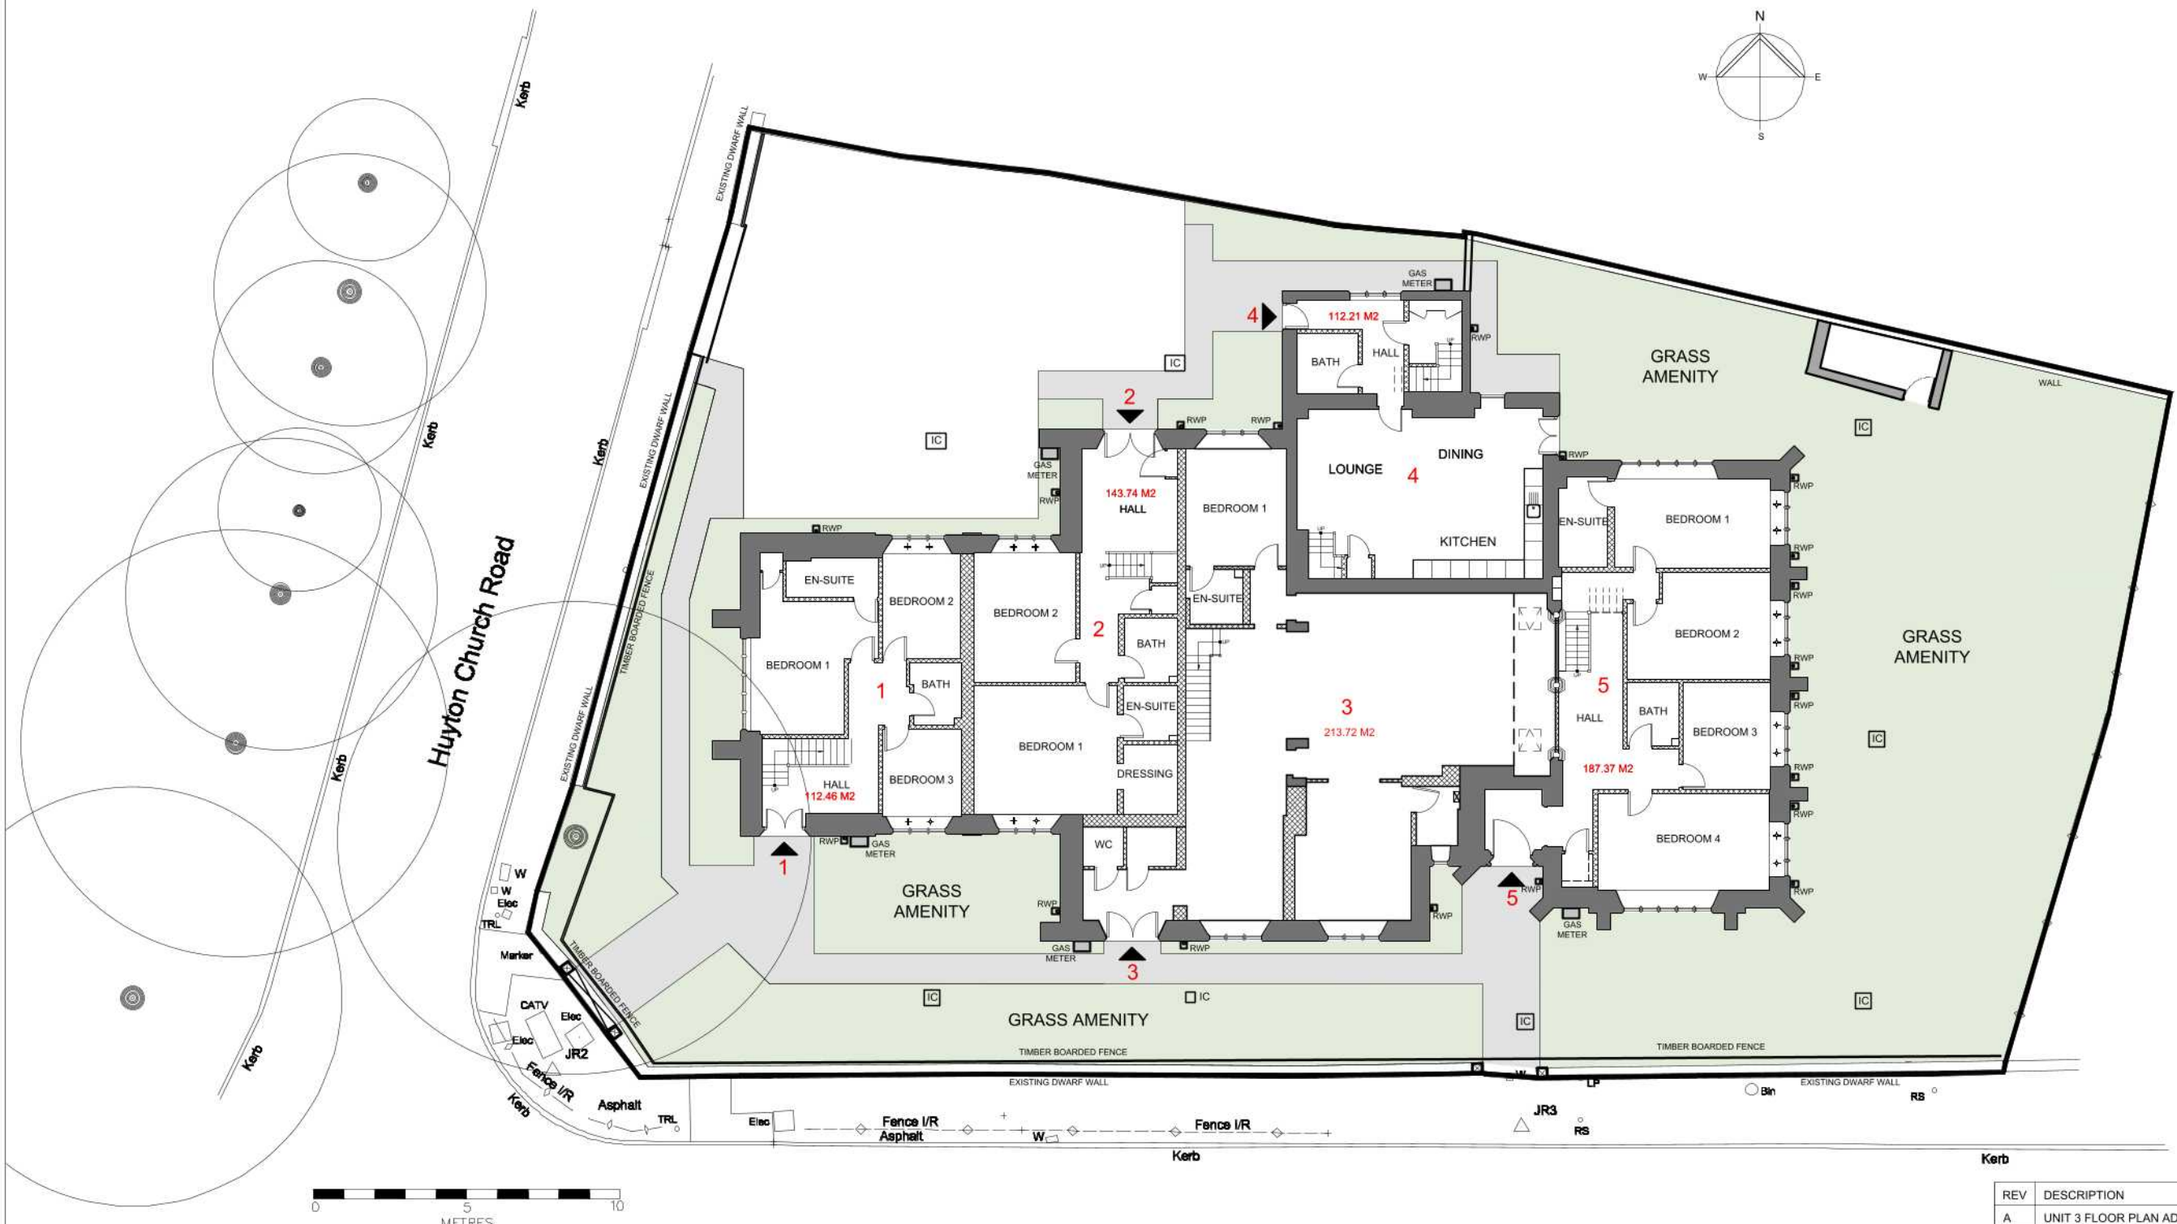


AS BUILT SITE PLAN


REV	DESCRIPTION
A	UNIT 3 FLOOR PLAN ADDED 16.01.24 D.D.

AS BUILT SITE PLAN

PROPOSED CONVERSION OF EXISTING CHURCH INTO FIVE DWELLINGS
PARK HALL, HUYTON HEY ROAD, LIVERPOOL

CLIENT:	PARK HALL HUYTON LTD
DWG NO:	PL K1116/01
SCALE:	1/200 @ A3
DRAWN BY:	D.D.
DATE:	13/11/23
REV:	A

NEIL PIKE ARCHITECTS
MICHIGAN HOUSE,17-19 CHORLEY NEW ROAD, BOLTON, BL1 4QR
TEL: 01204 392233 FAX: 01204 528505
WWW.NEILPIKEARCHITECTS.CO.UK EMAIL: INFO@NEILPIKEARCHITECTS.CO.UK

COPYRIGHT OF THIS DRAWING REMAINS WITH THE ARCHITECT. DO NOT SCALE FROM THIS DRAWING. WORK TO FIGURED DIMENSIONS. CHECK ALL DIMENSIONS ON SITE. IN THE EVENT OF ANY DISCREPANCY REFER QUERY TO THE ARCHITECTS.