



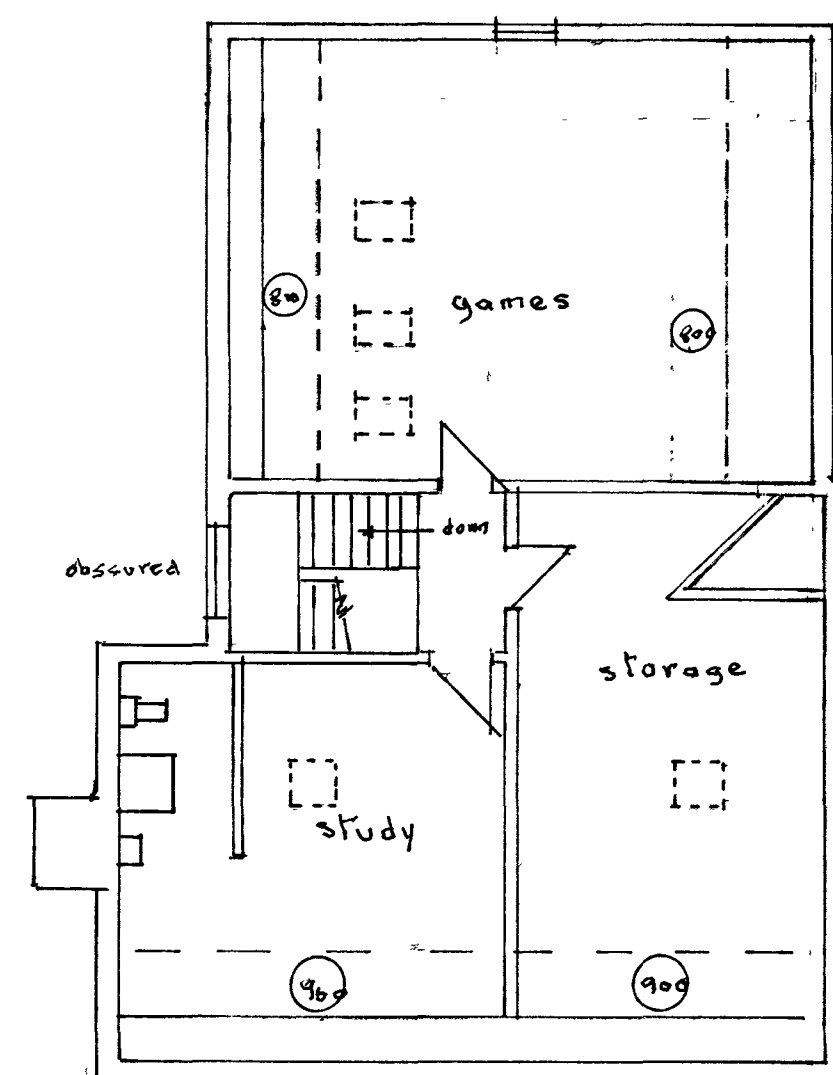



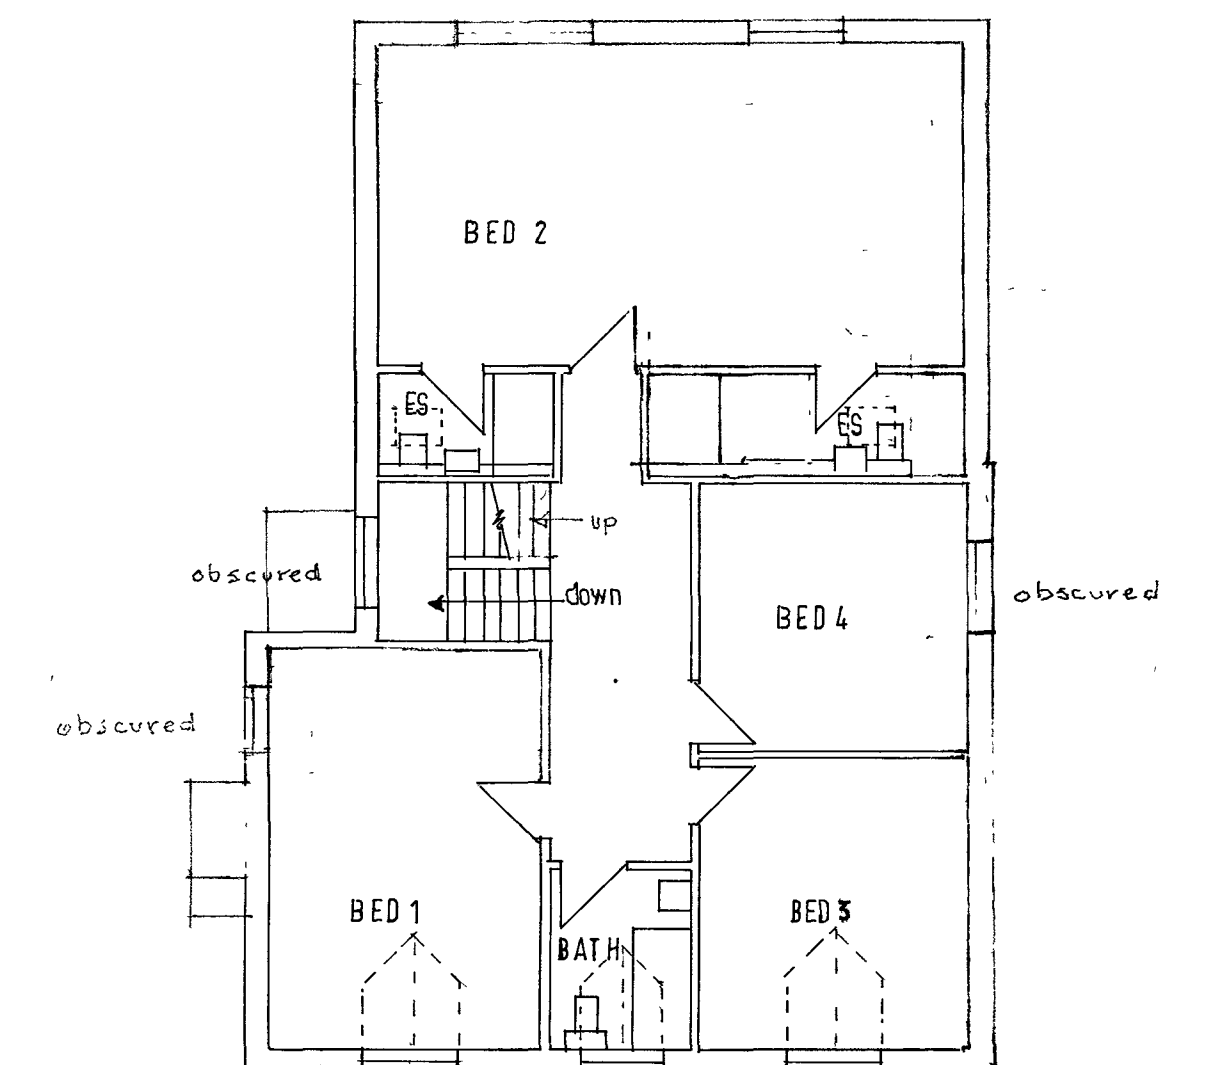

PROPOSED Whitefield Lane frontage 1:200

No.	Date	
A	3-5	Lane frontage added
B	1-18	removed cur parking
C	1-18	Big Road added
D	9-21	" " "
E	2-13 3-23	Drawing of "as built"

K. WOODWARD. Chartered Architect			
Forest Gate, Tarn Road, Frodsham, Cheshire. WA6 5UU.			
Tel & Fax: 01928 724679			
E-mail: woodwardkw@btinternet.com			
Project:			
92 Whitefield Lane			
Tarbock Green			
Prescot			
L36 1QX			
Dwg Title:			
proposed dwelling			
Date:	Scale:	Dwg No.	Rev.
2-17	1:100	K 273-2	A 1st B E