


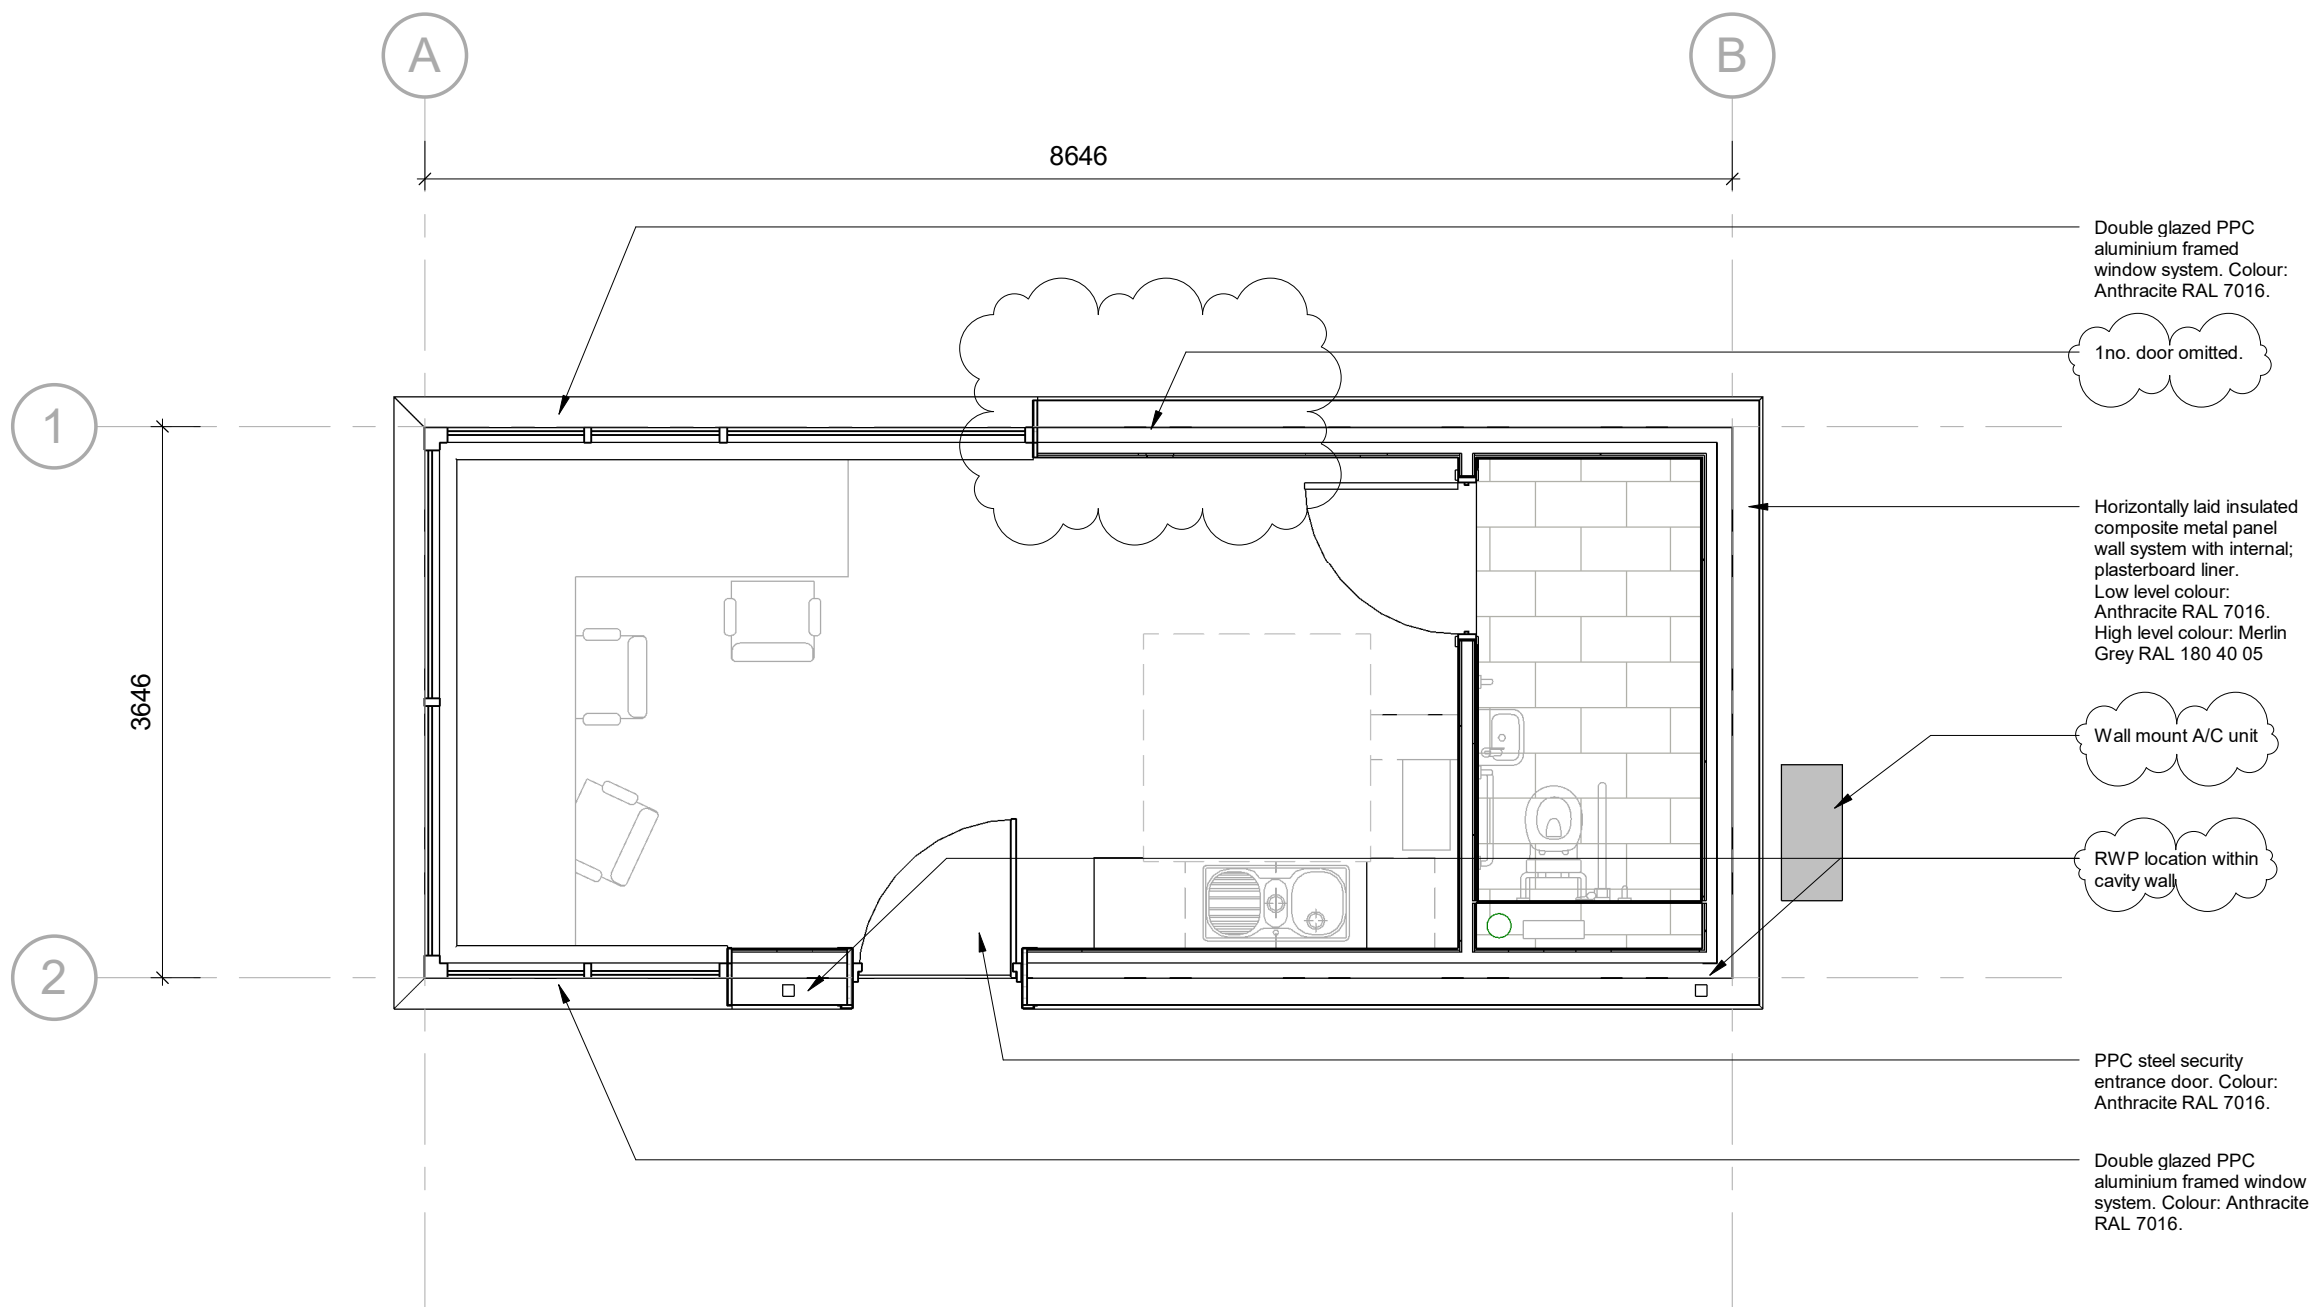


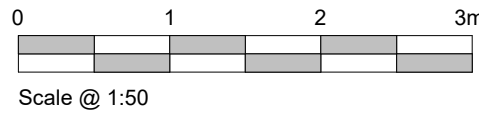


Ground Floor Plan
Scale @ 1 : 50

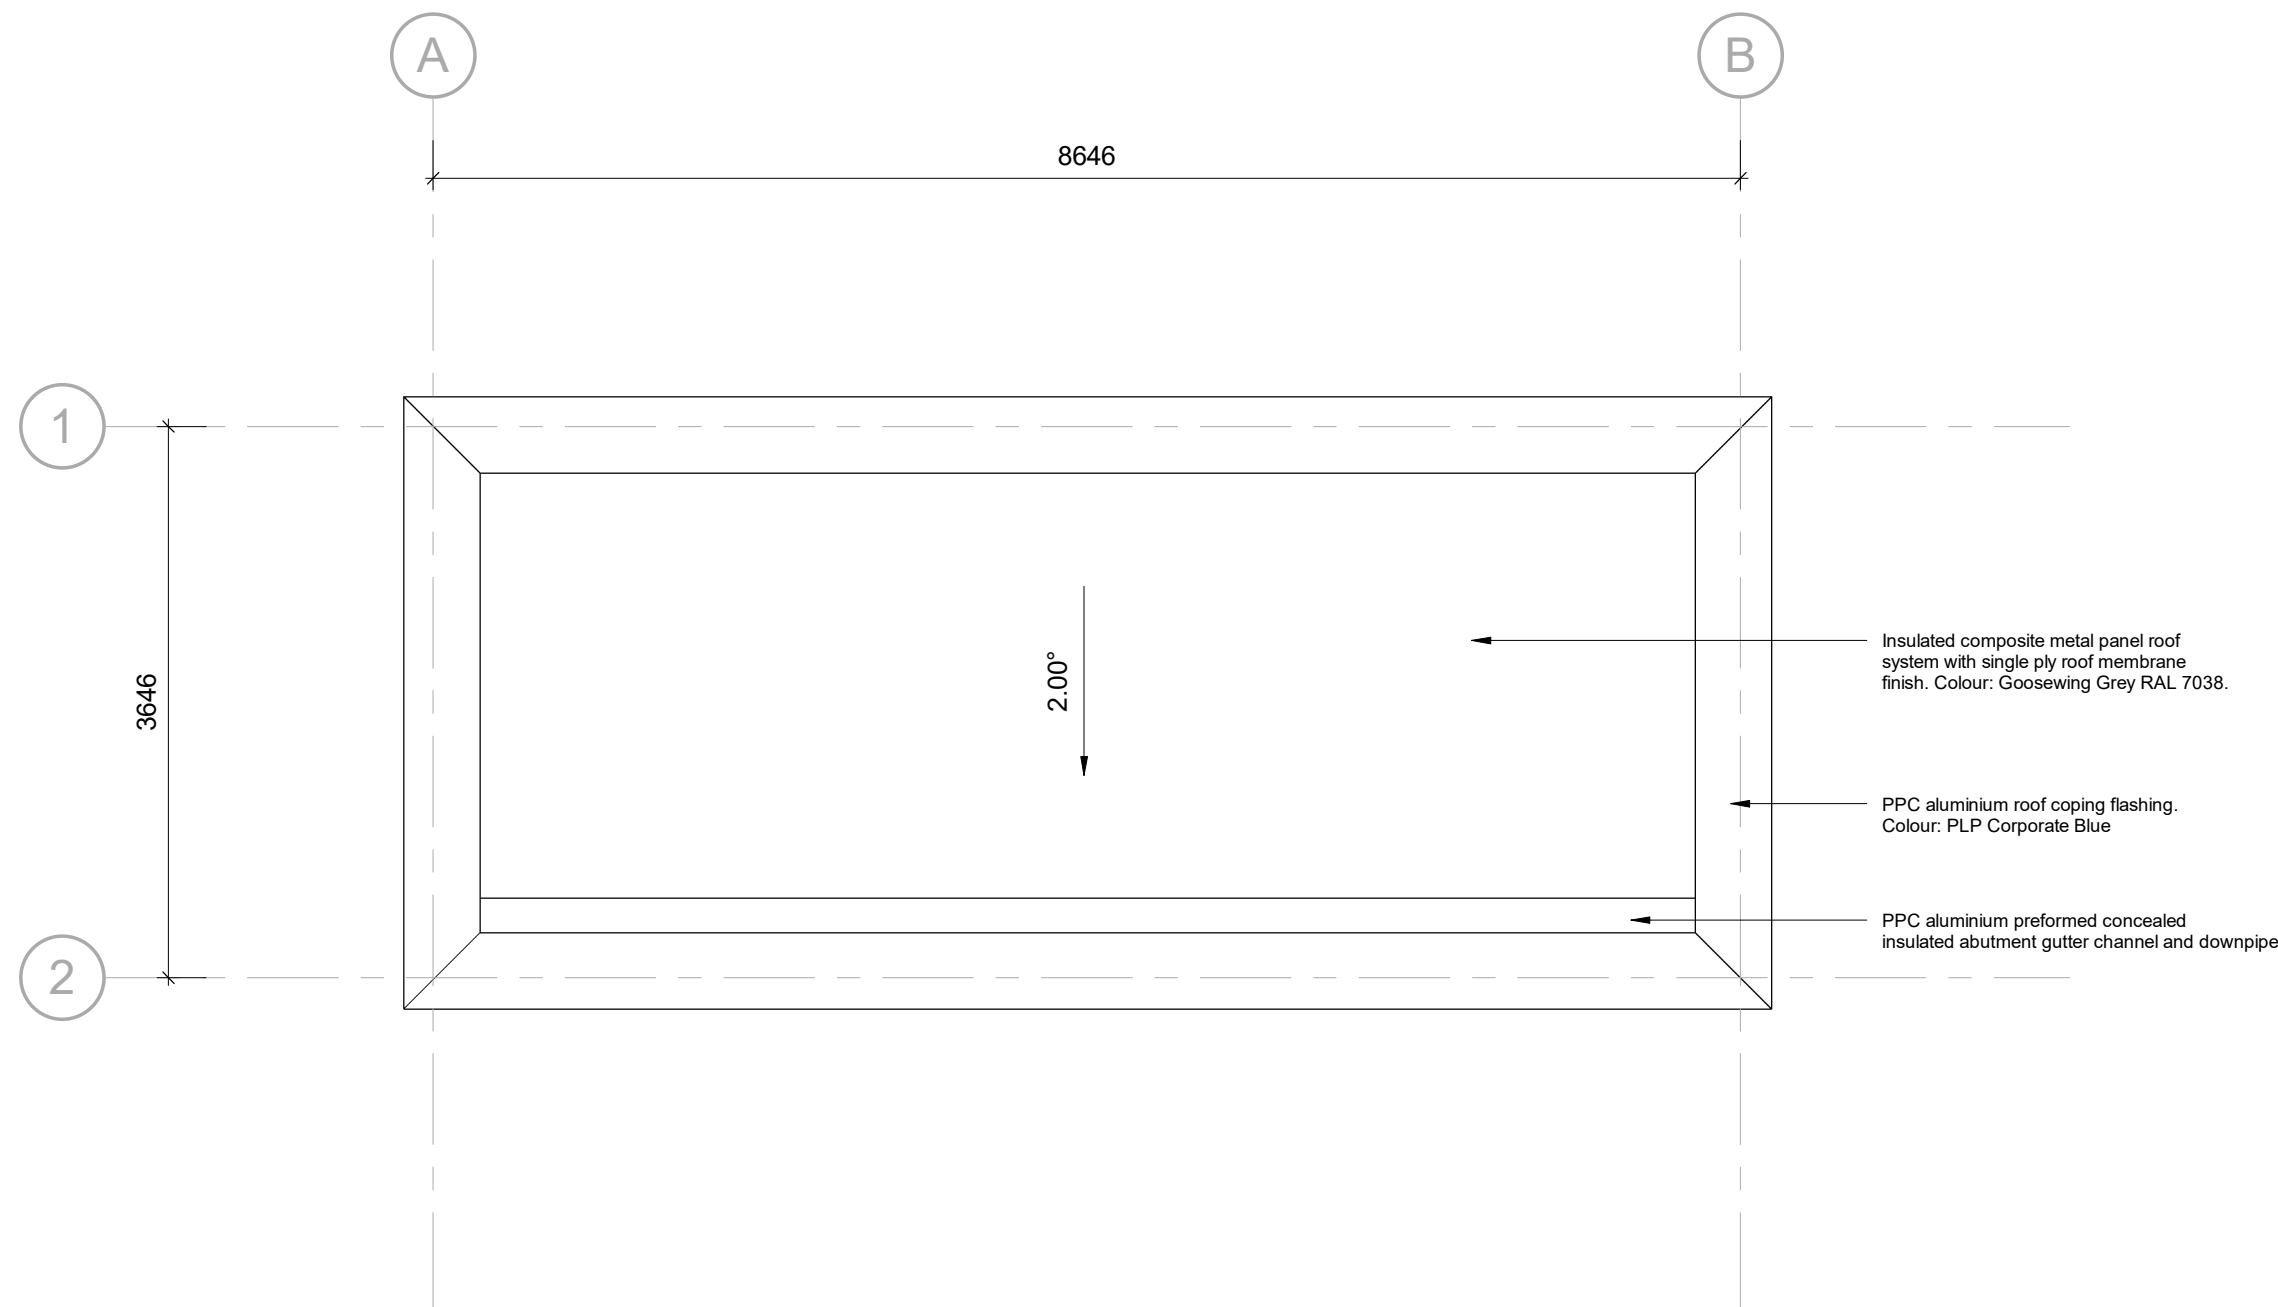

Roof Plan
Scale @ 1 : 50

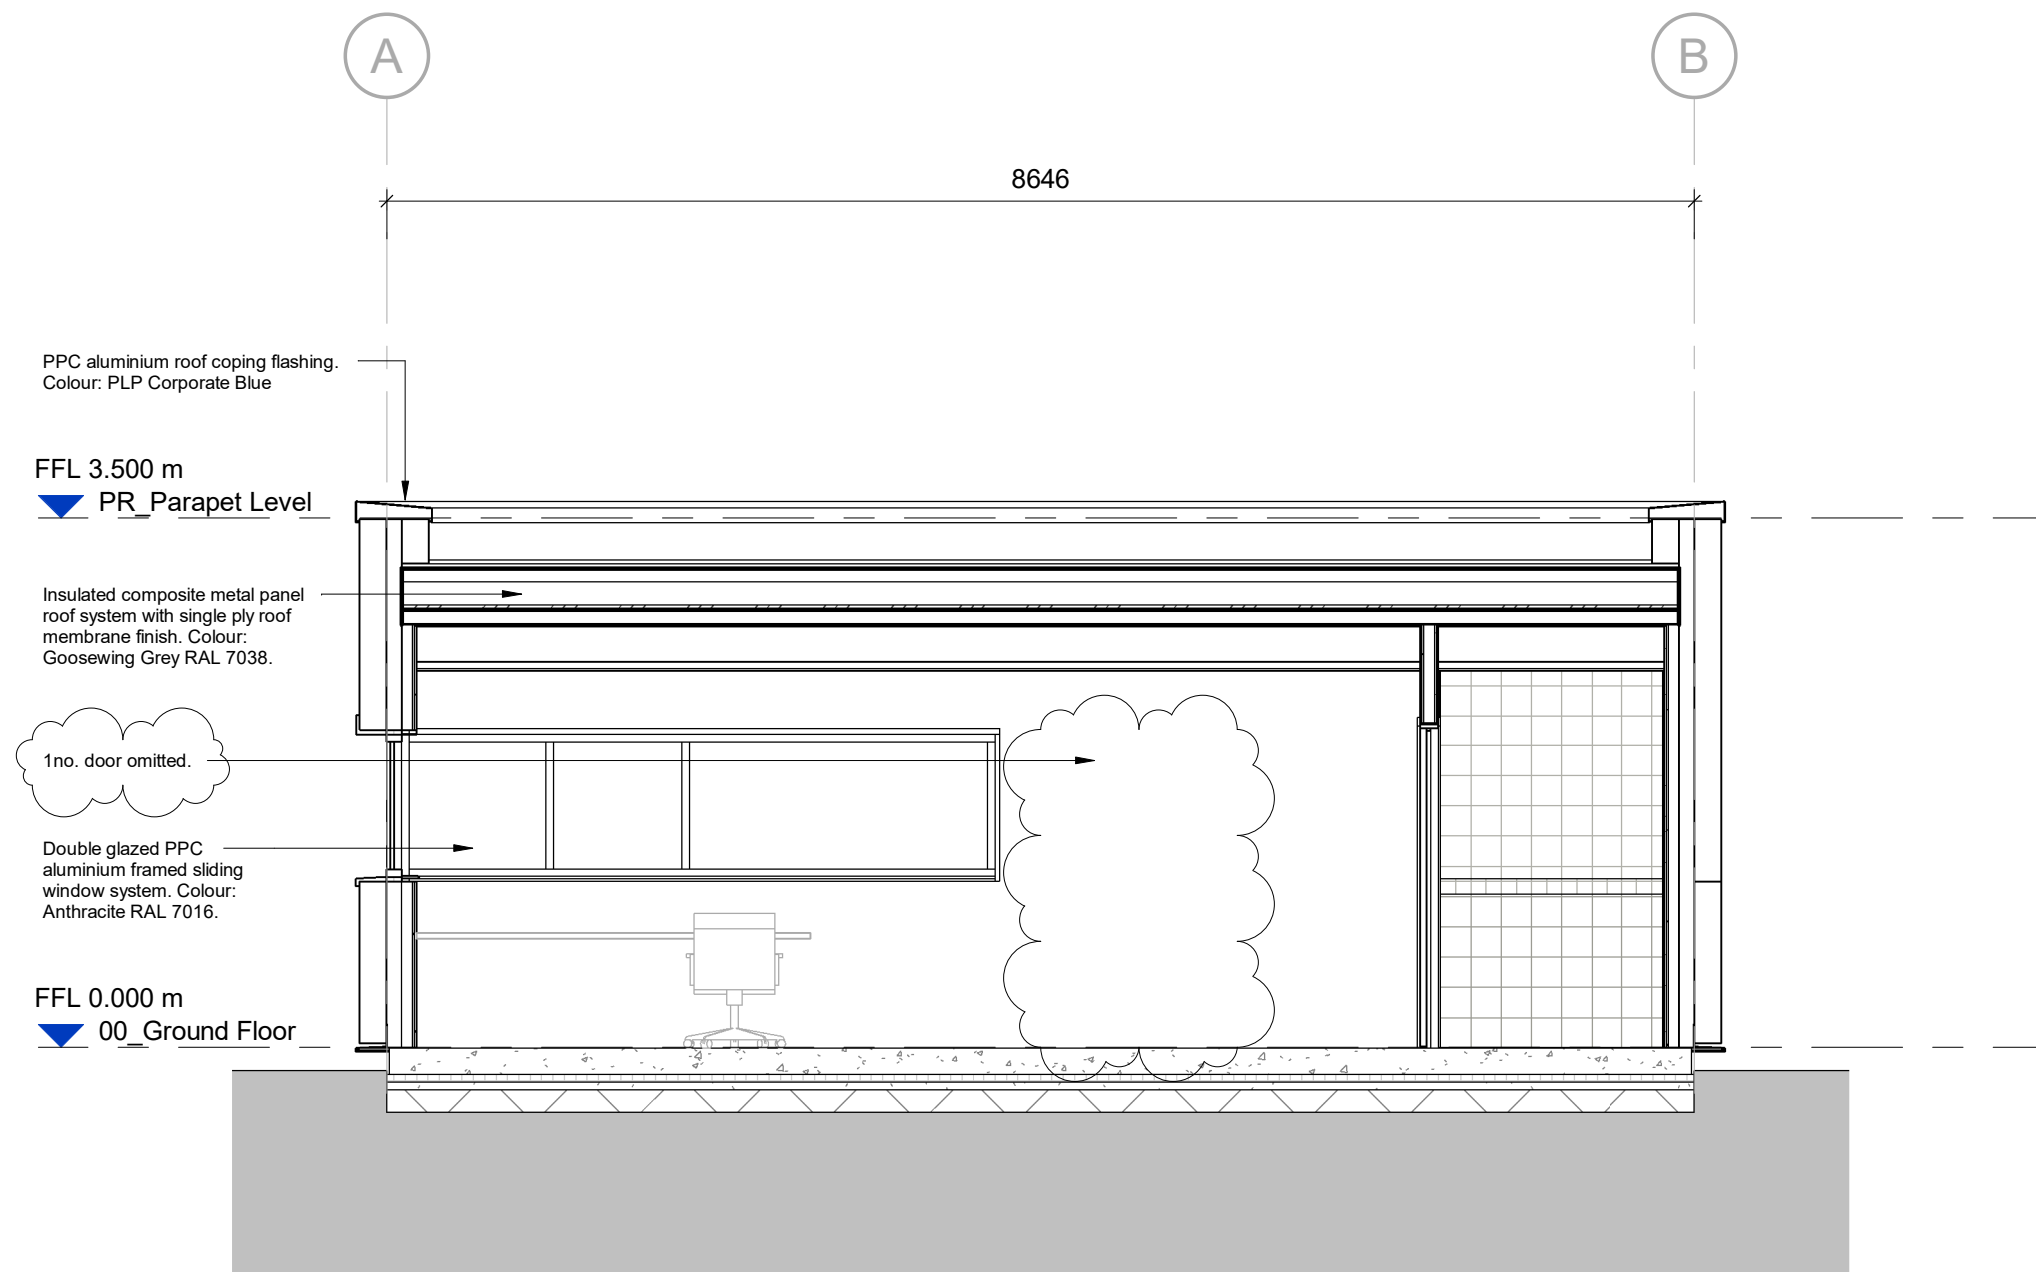

A Section
Scale @ 1 : 50

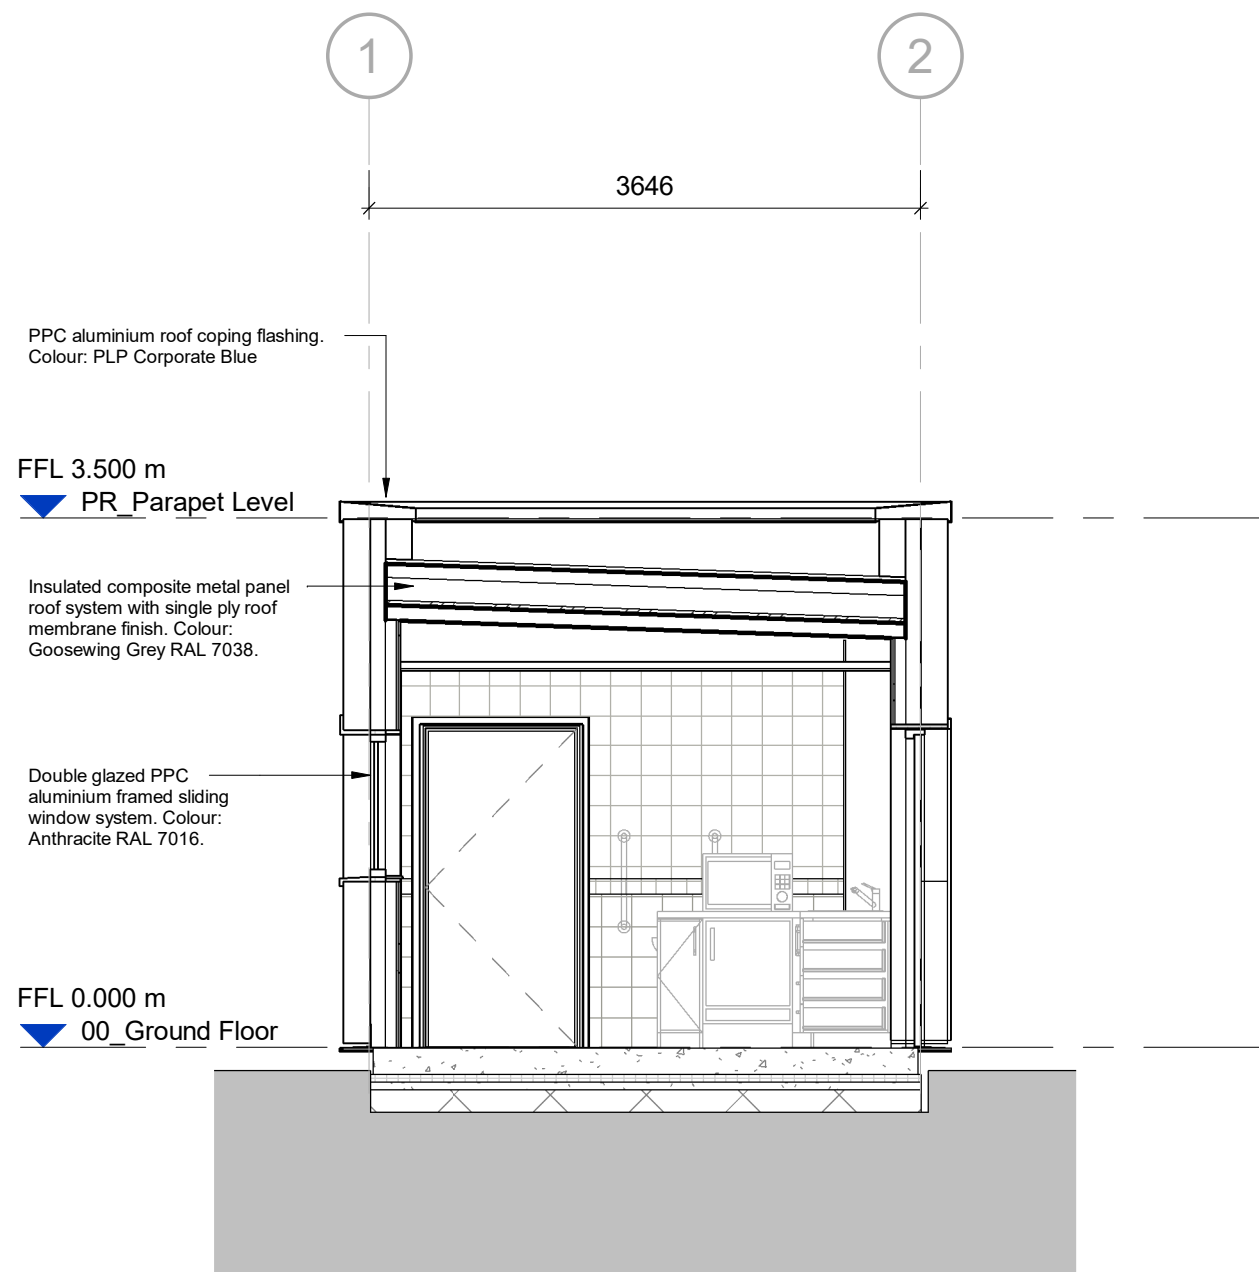

B Section
Scale @ 1 : 50

NOTES

- All dimensions and levels are to be checked on site.
- Any discrepancies are to be reported to the architect before any work commences
- This drawing shall not be scaled to ascertain any dimensions. Work to figured dimensions only.
- This drawing shall not be reproduced without express written permission from AEW.
- Title overlay drawings and ownership boundaries are produced using all reasonable endeavors. AEW cannot be responsible for the accuracy or scale discrepancy of base plans supplied to them.
- All works are to be undertaken in accordance with Building Regulations and the latest British Standards.
- All proprietary materials and products are to be used strictly in accordance with the manufacturers recommendations.


This drawing contains the following model files :-

KNW001-AEW-B2-XX-M3-A-0002_Guardhouse [P1.1] [S6]

CDM 2015

Client notified of duties: **June 2019**
Principal Designer: **CDM Contract Services**

Unless noted below, all known hazards have been highlighted on the drawing:

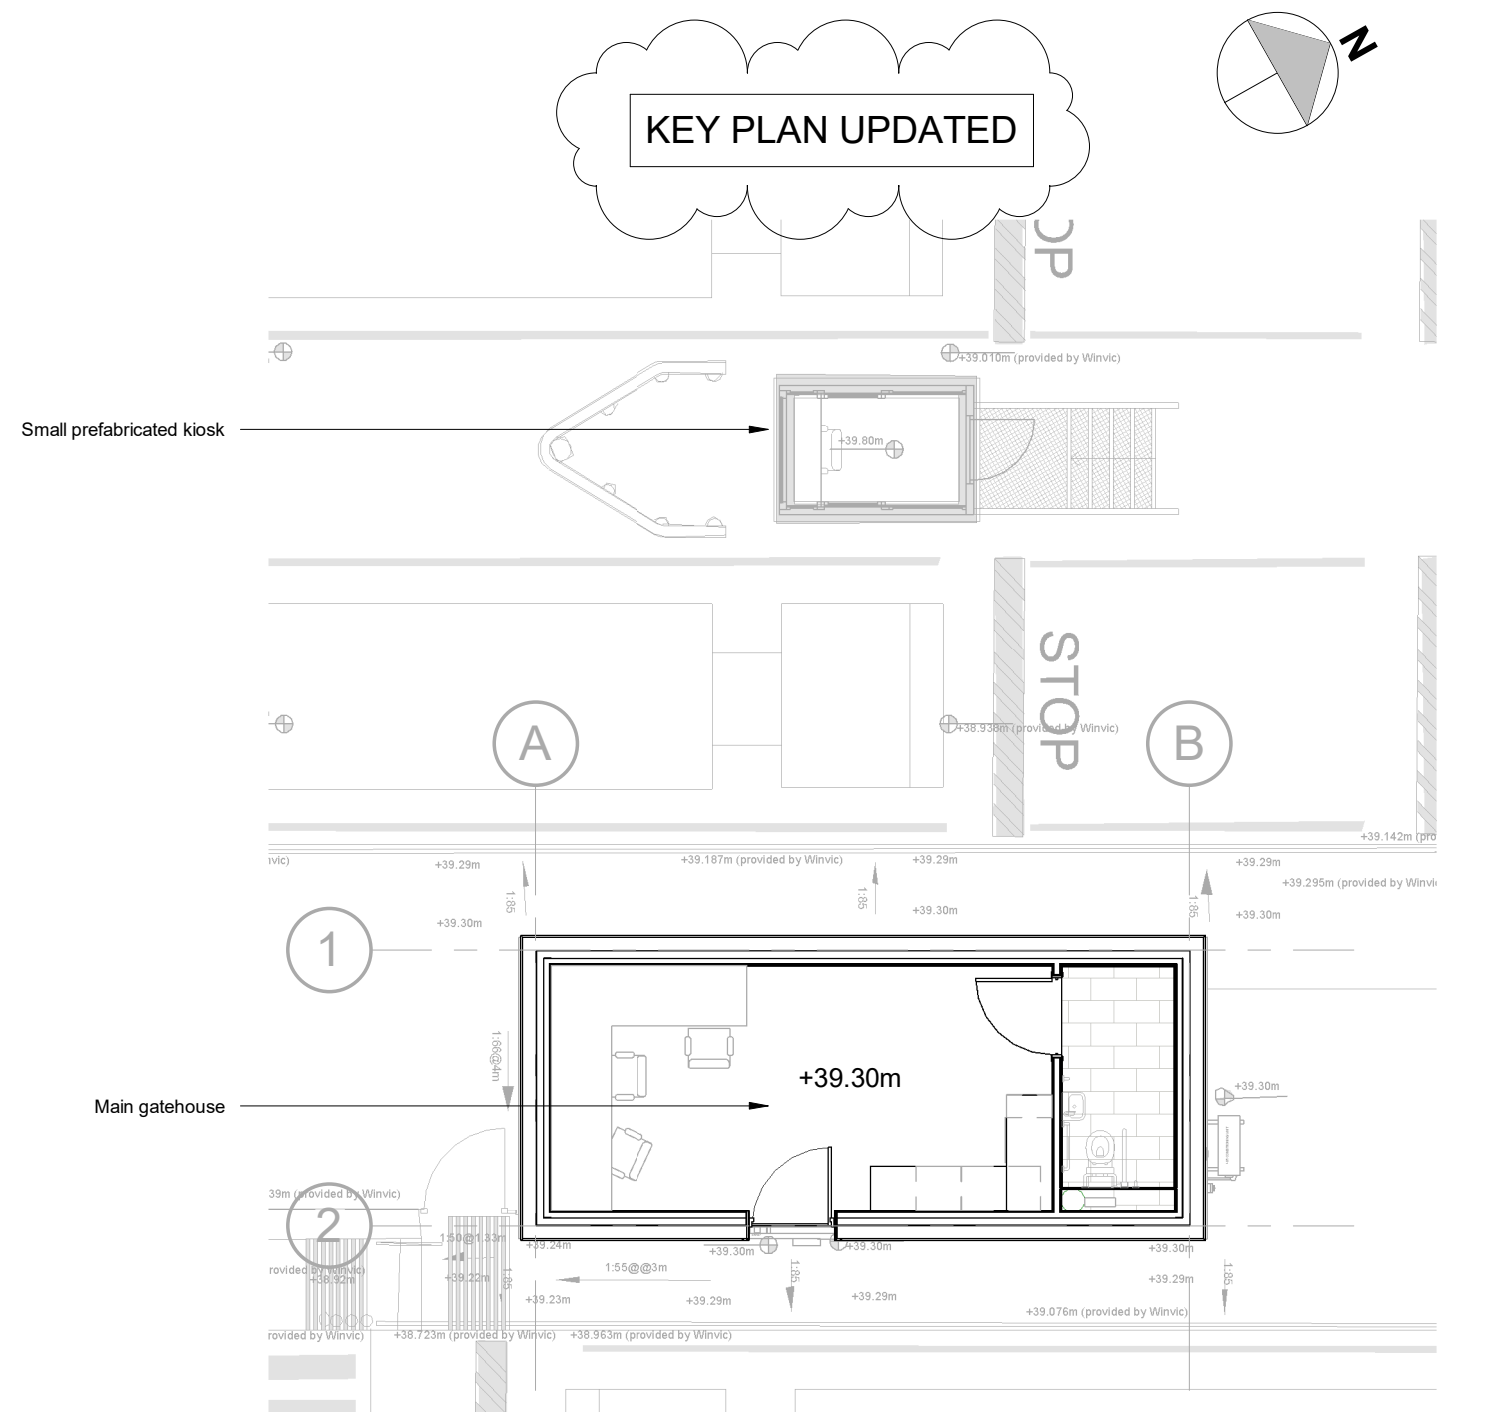

Key Plan
Scale @ 1 : 100

P4	28/02/22	WS	RDDW
Updated tenant requirements and technical design development.			
P3	30/09/20	NC	ER
Minor updates - refer to NMA mark-ups for details			
P2	06/02/20	TF	DRS
Notation amended			
P1	04/02/20	TF	DRS
Initial Issue			
REV	Date	Drawn by :-	Checked by :-

Status Purpose of Issue
S2 For Approval

drawing stage **Technical Design**

client



project

PLP Knowsley

drawing title

Proposed Guardhouse Plan and Sections

date 29.09.20 drawn NC
scale @ A1 As indicated checked ER

Rev

P4

B8391-AEW-XX-XX-DR-A-0512

Draw No

aew architects
0161 214 4370
www.aewarchitects.com

AEW