


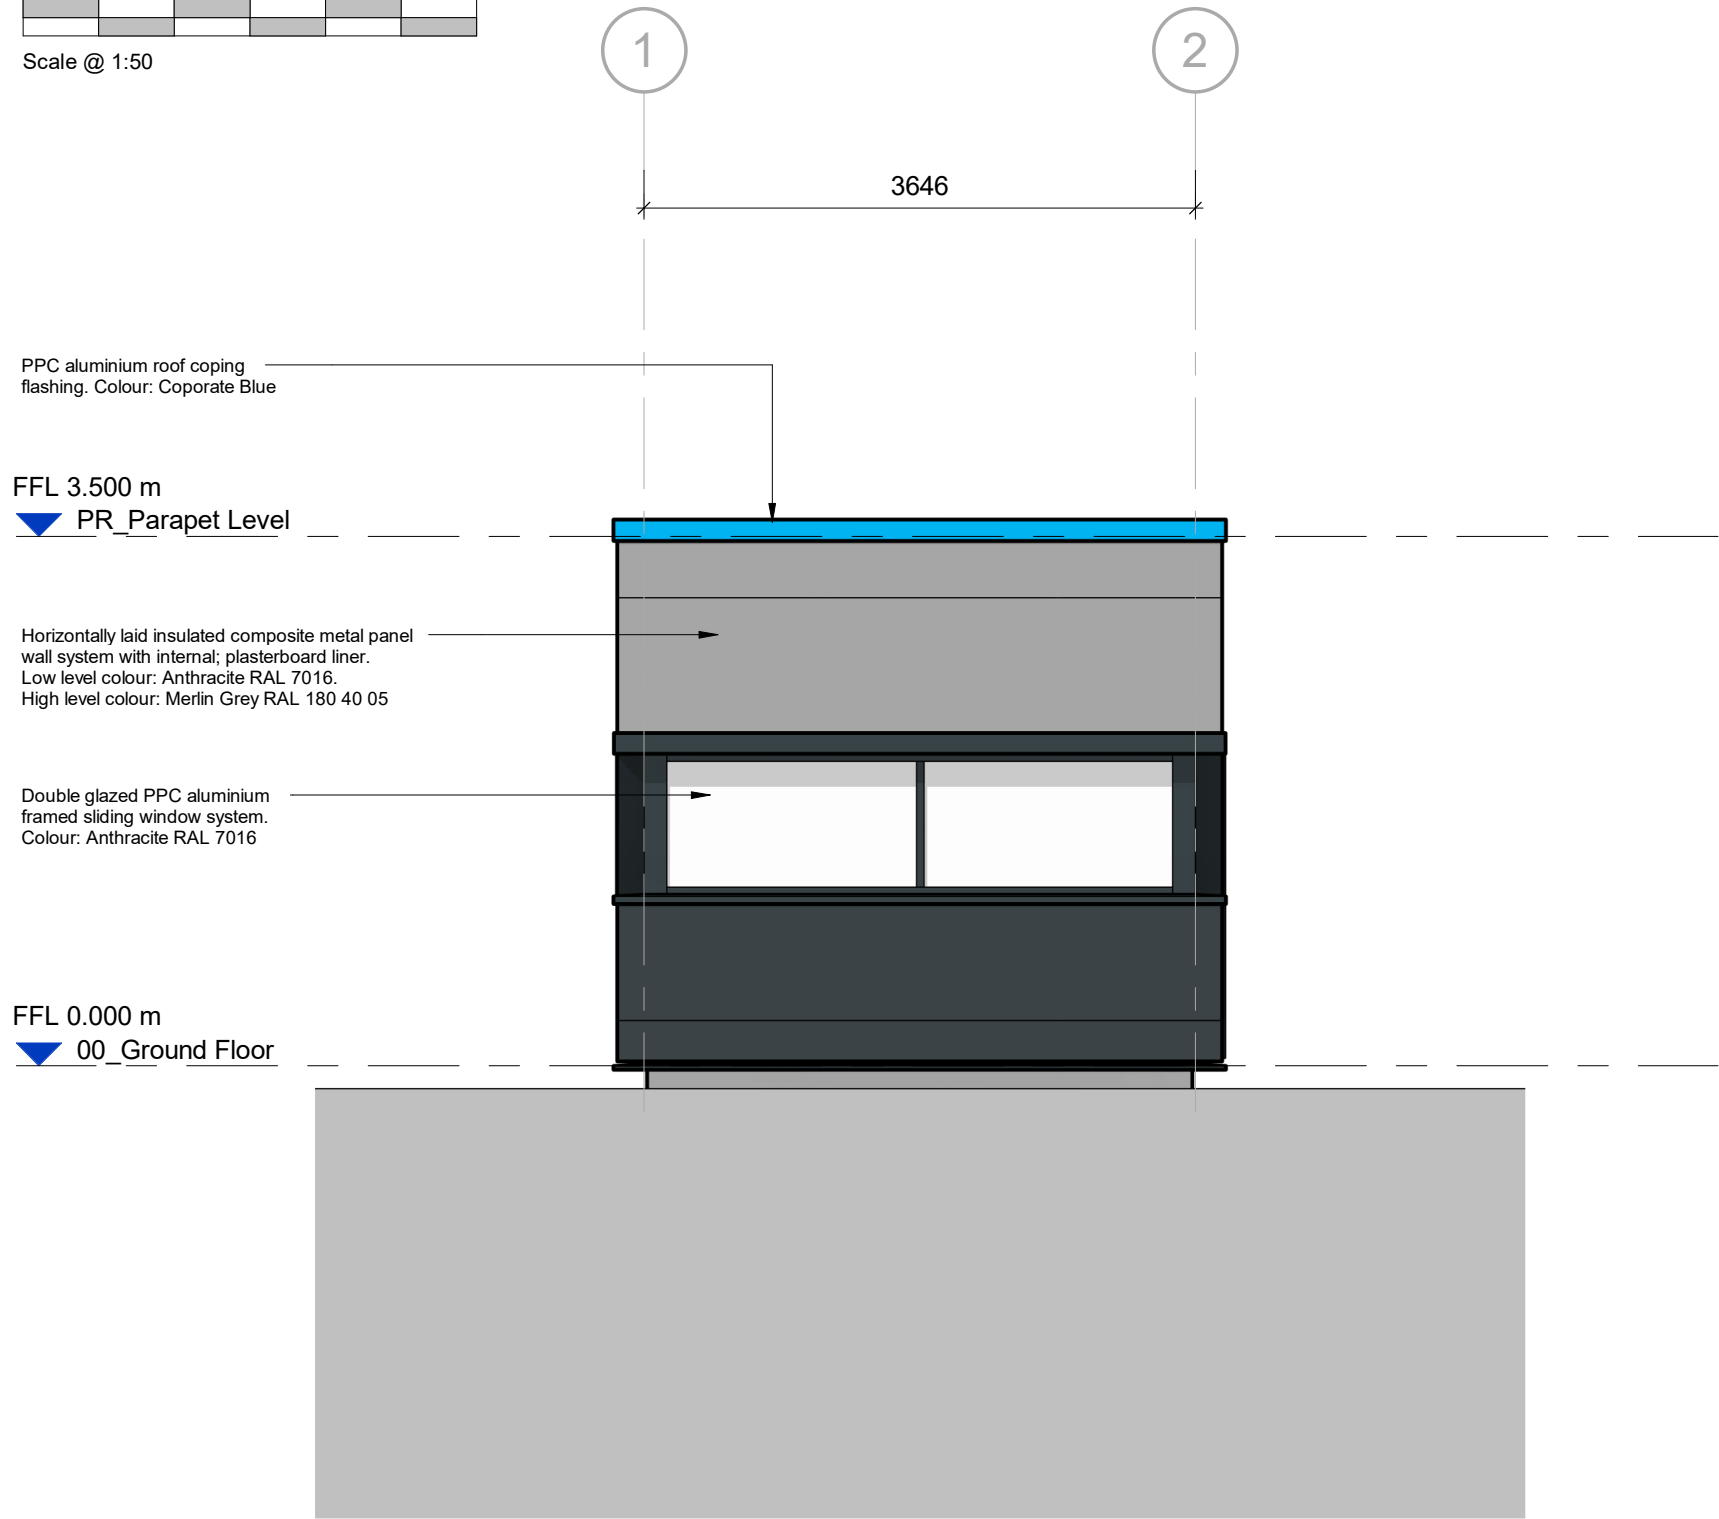


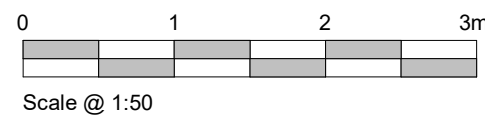


1 South West Elevation
Scale @ 1 : 50

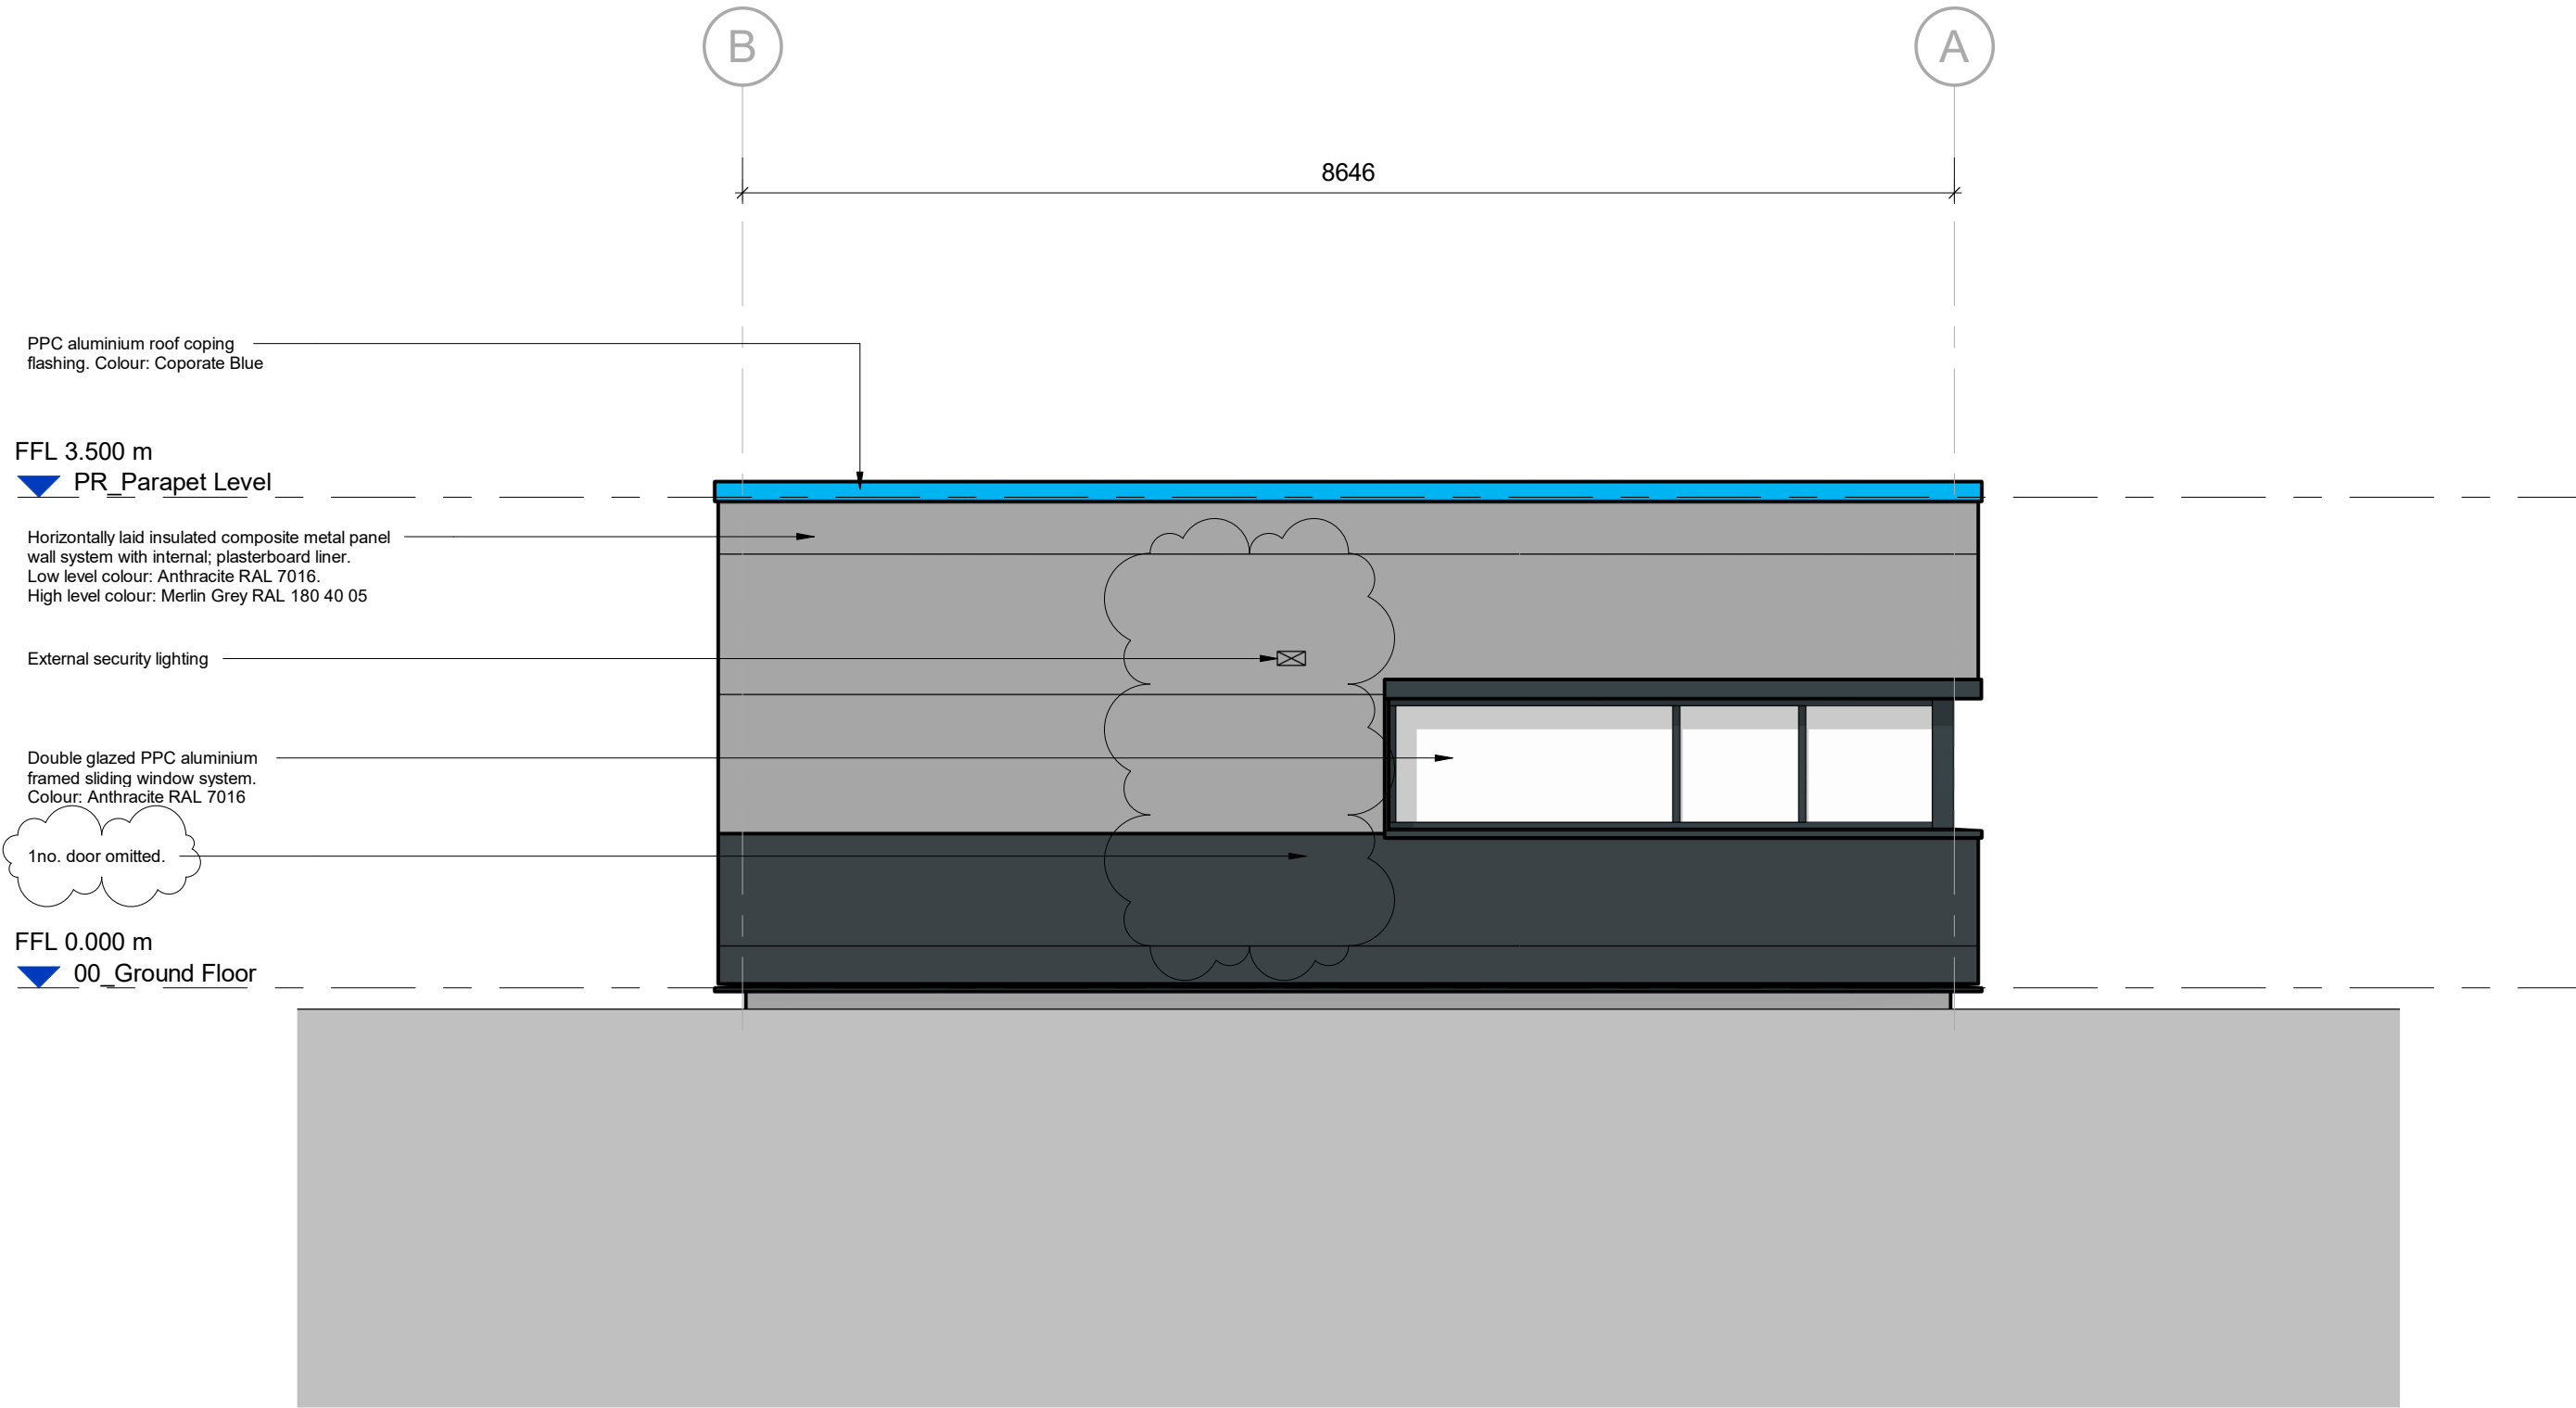


2 North West Elevation
Scale @ 1 : 50

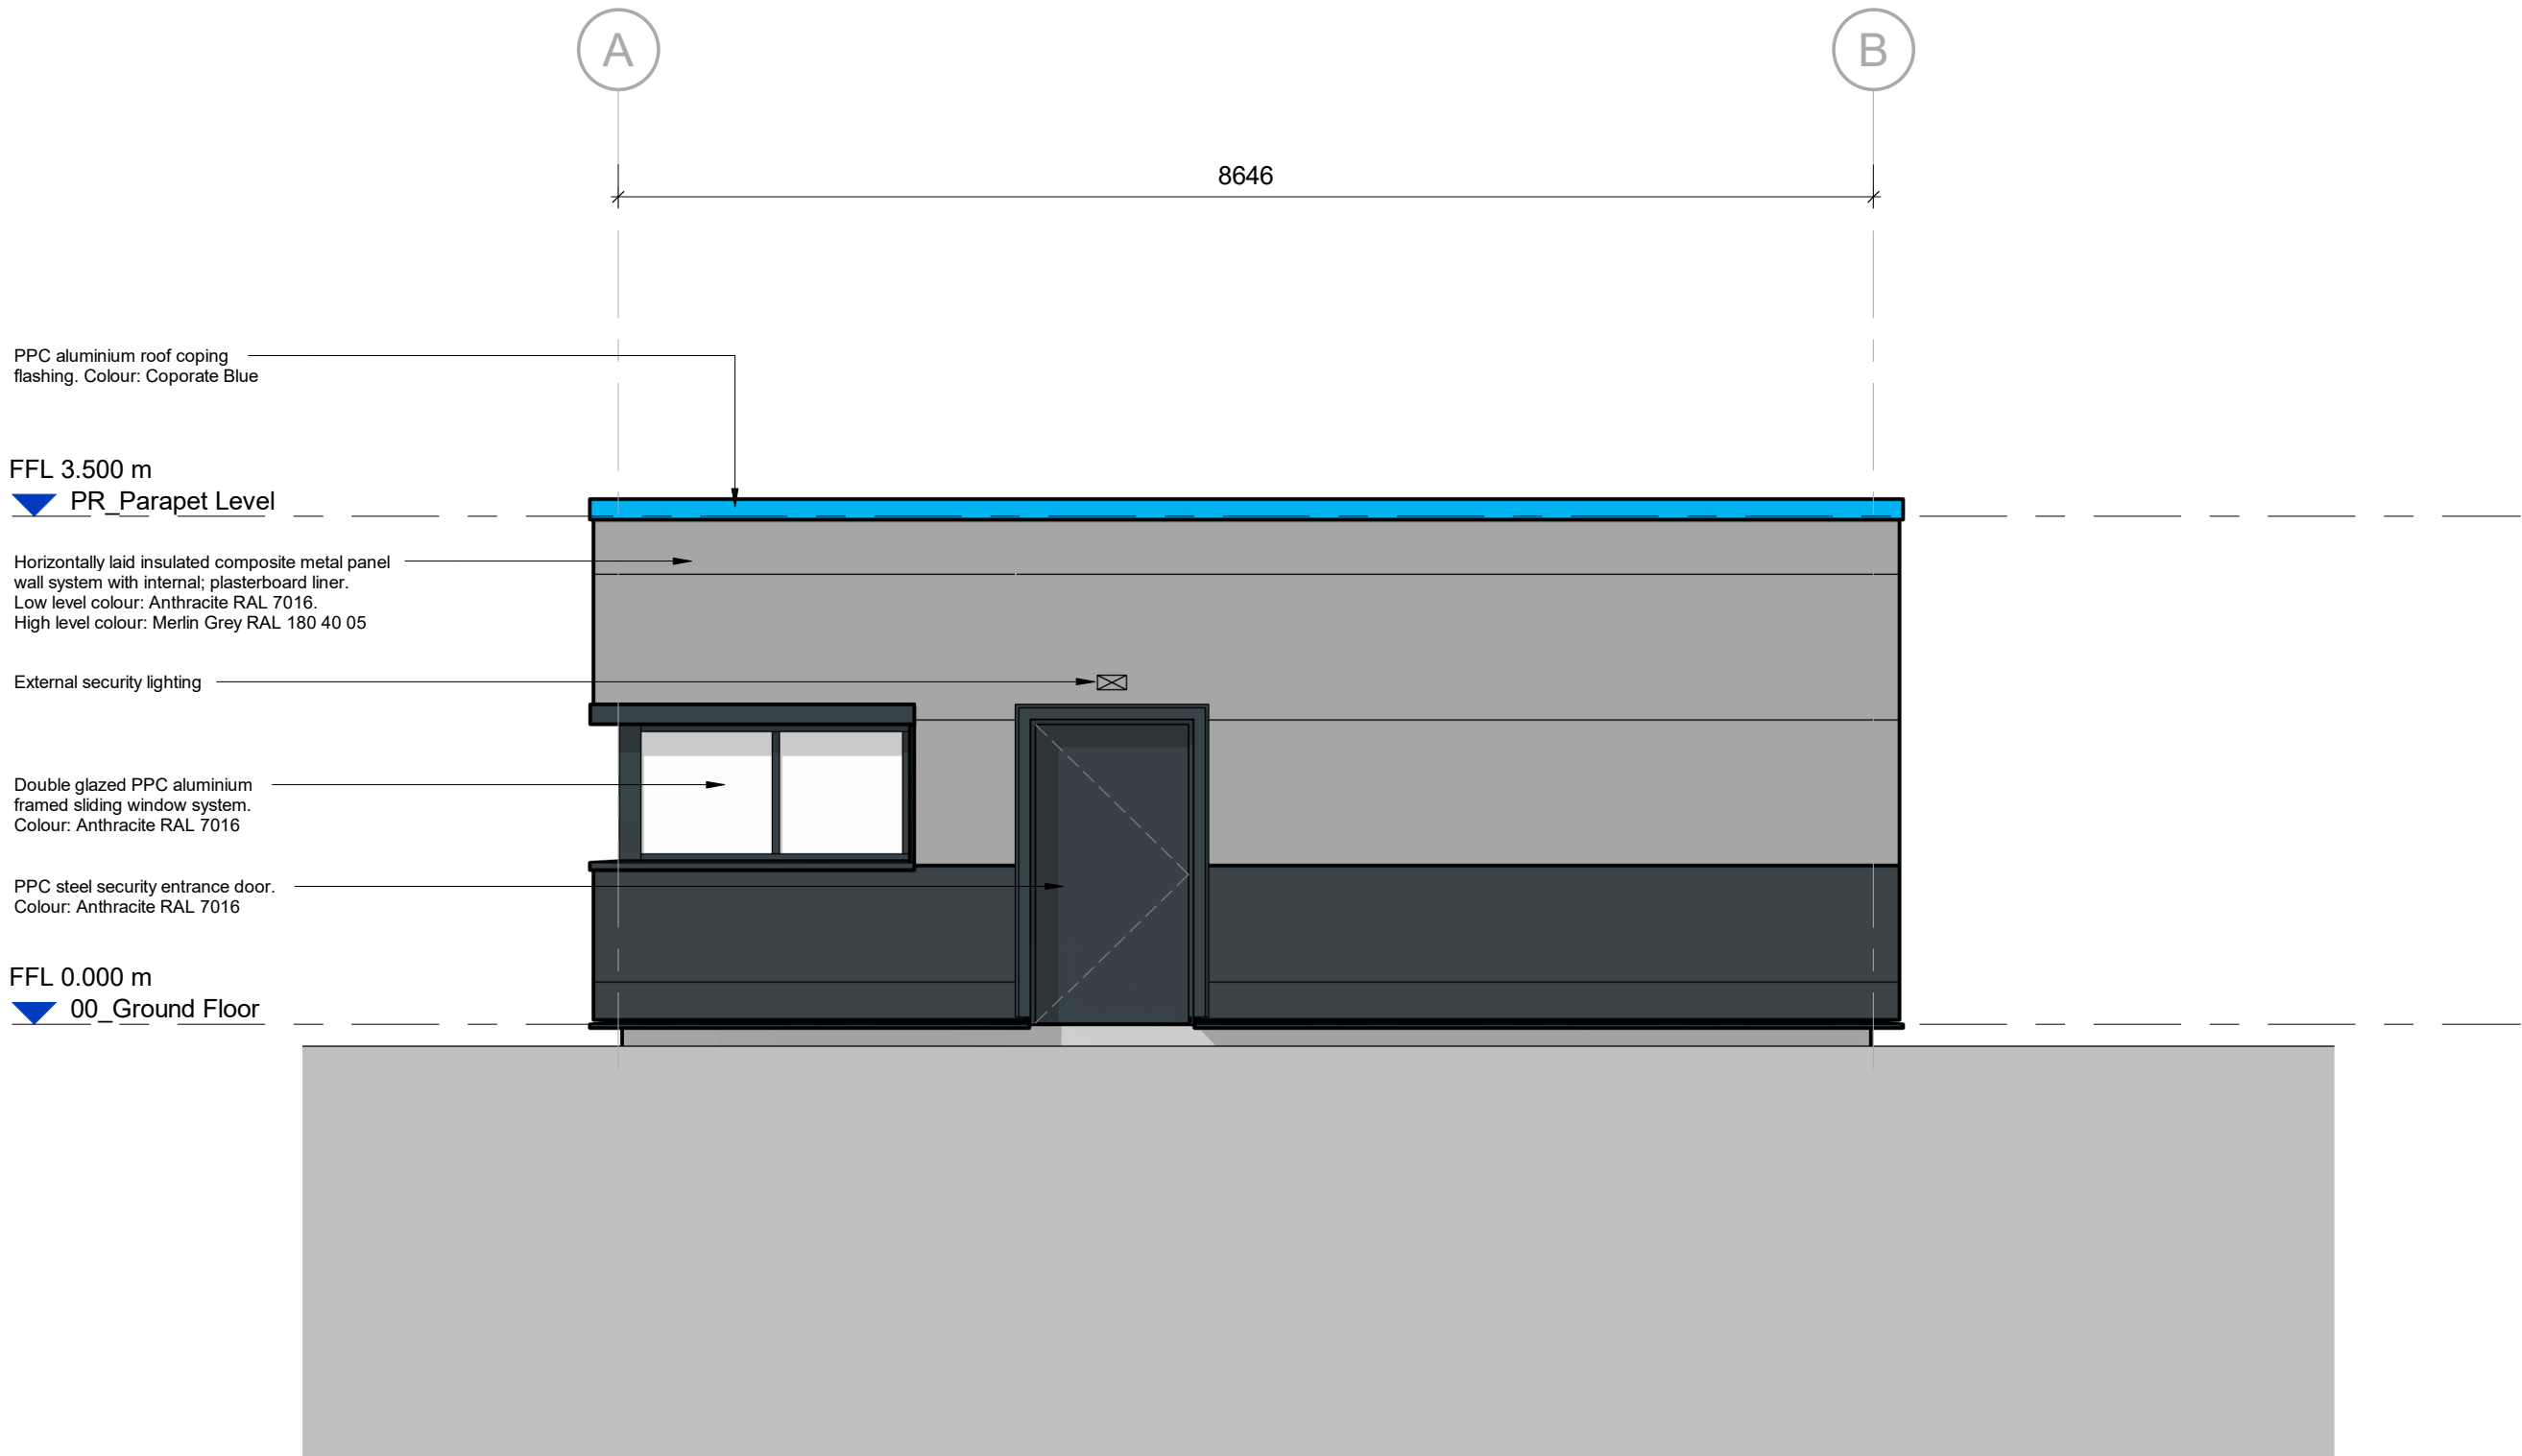

3 South East Elevation
Scale @ 1 : 50

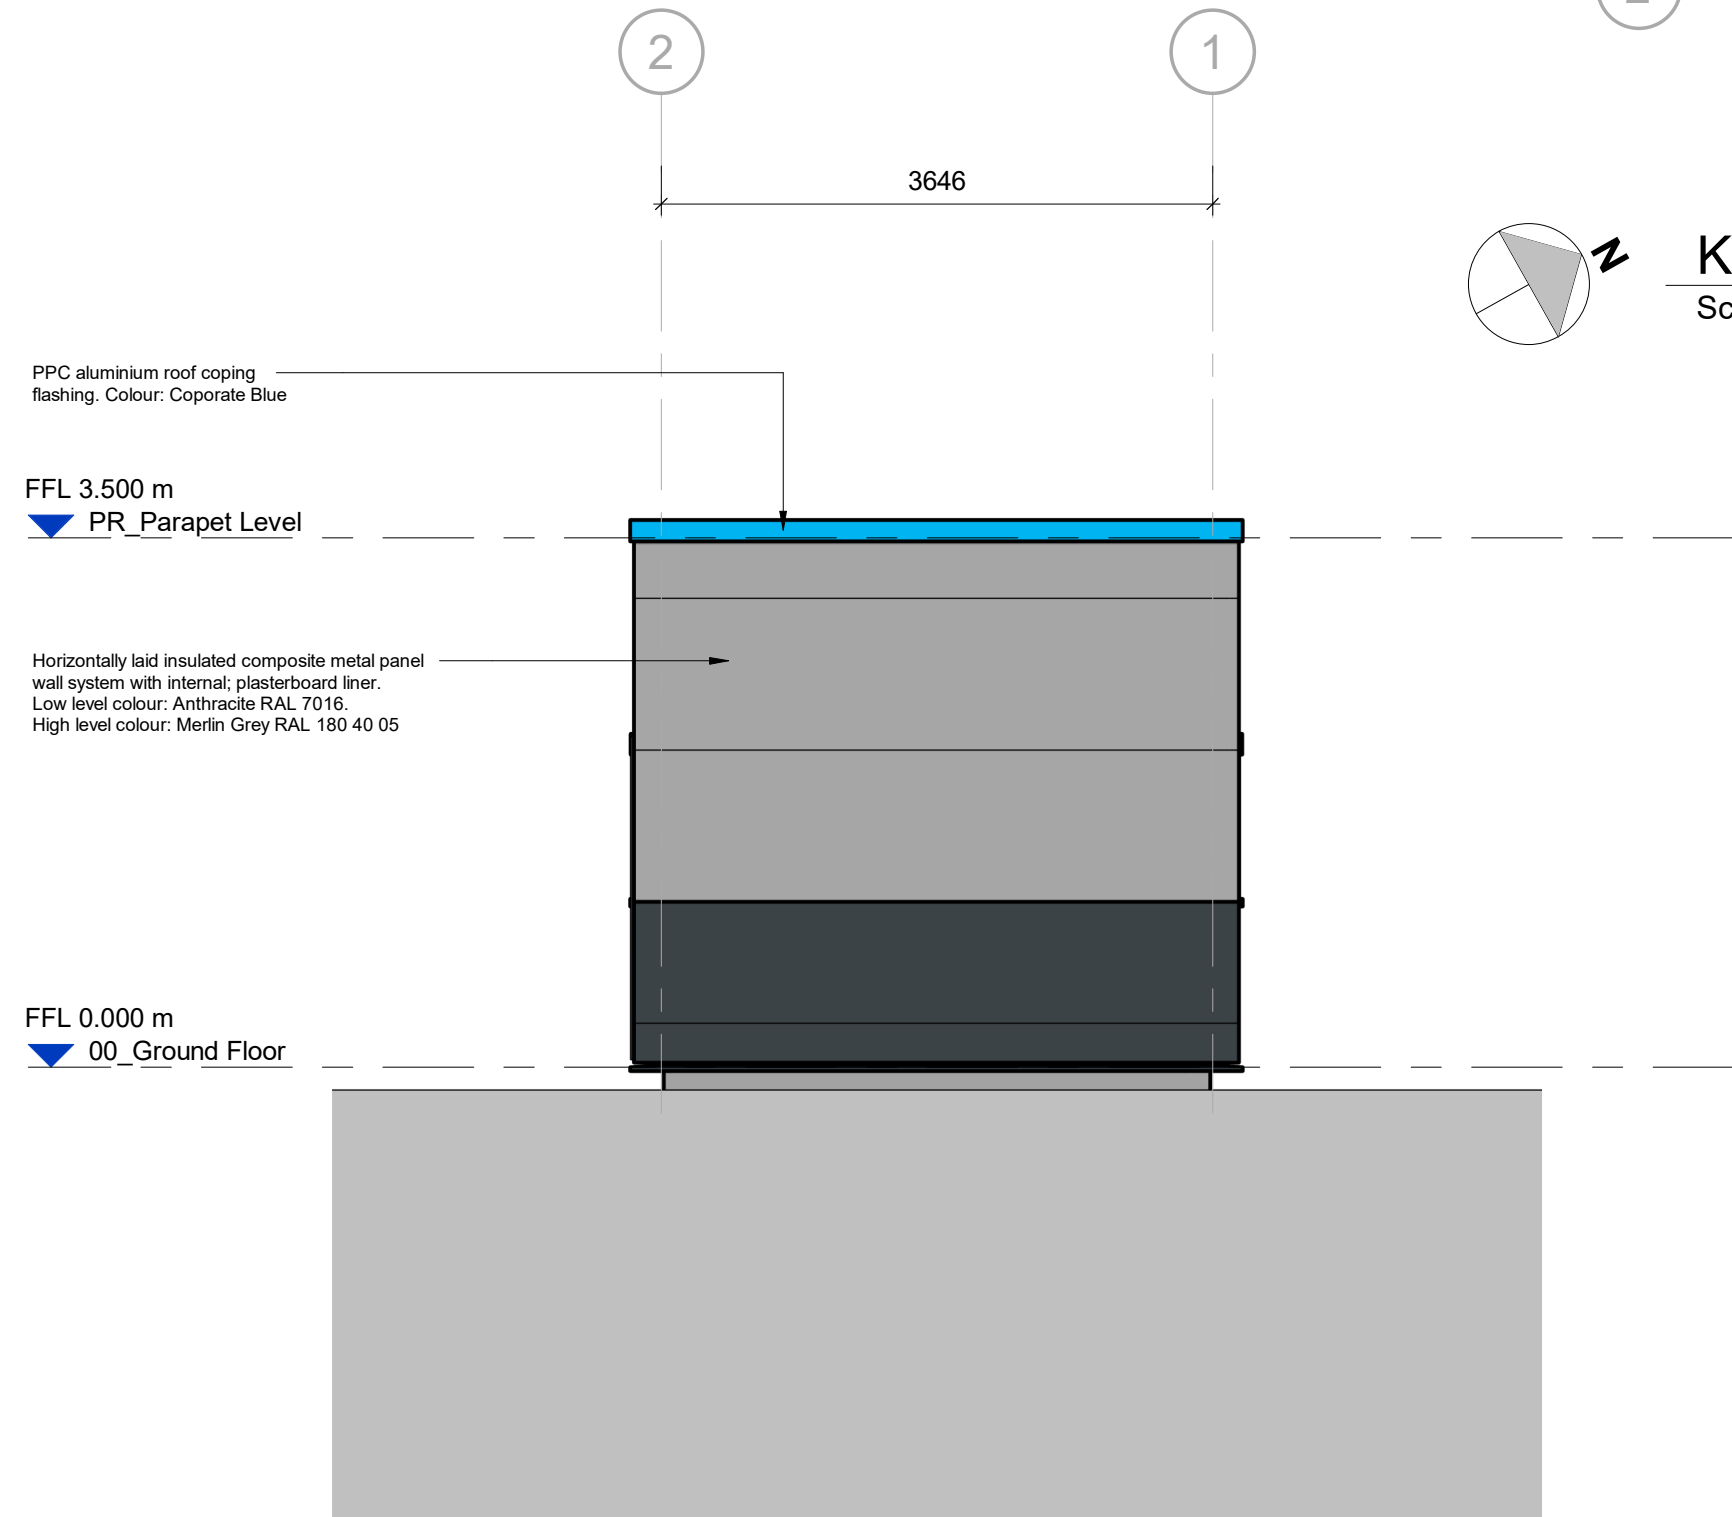

4 North East Elevation
Scale @ 1 : 50

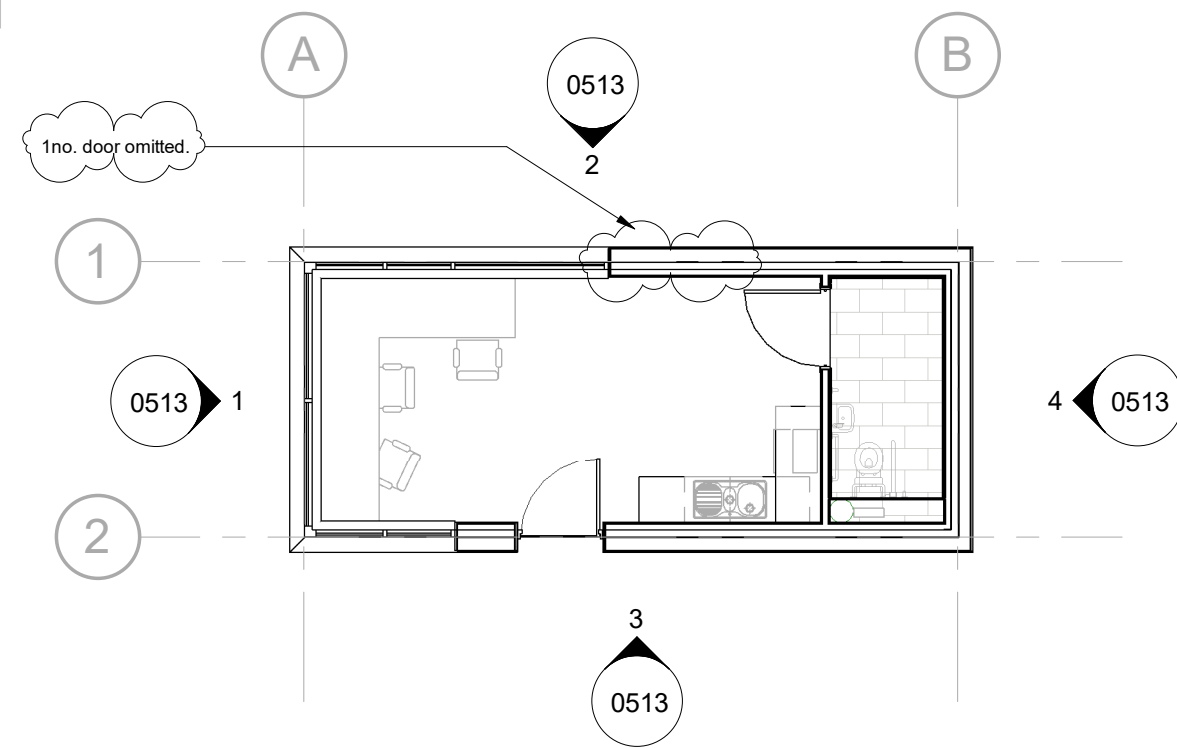

Key Plan
Scale @ 1 : 100

NOTES

- All dimensions and levels are to be checked on site.
 - Any discrepancies are to be reported to the architect before any work commences
 - This drawing shall not be scaled to ascertain any dimensions. Work to figured dimensions only.
 - This drawing shall not be reproduced without express written permission from AEW.
 - Title overlay drawings and ownership boundaries are produced using all reasonable endeavors. AEW cannot be responsible for the accuracy or scale discrepancy of base plans supplied to them.
 - All works are to be undertaken in accordance with Building Regulations and the latest British Standards.
 - All proprietary materials and products are to be used strictly in accordance with the manufacturers recommendations.
- This drawing contains the following model files : -
- KNW001-AEW-B2-XX-M3-A-0002_Guardhouse [P1.1] [S6]

CDM 2015

Client notified of duties: **June 2019**
Principal Designer: **CDM Contract Services**

Unless noted below, all known hazards have been highlighted on the drawing:

P3	28/02/22	WS	RDI/DW
Updated tenant requirements and technical design development.			
P2	30/09/20	NC	ER
Minor updates - refer to NMA mark-ups for details			
P1	04/02/20	TF	DRS
Initial Issue			
REV	Date	Drawn by -	Checked by -
Status	Purpose of Issue		
S2	For Approval		

drawing stage **Technical Design**

client



project

PLP Knowsley

drawing title

Proposed Guardhouse Elevations

date	29.09.20	drawn	NC
scale @ A1	As indicated	checked	ER

Rev

P3

B8391-AEW-XX-XX-DR-A-0513

Draw No

project

aew architects

0161 214 4370

www.aewarchitects.com

aew