


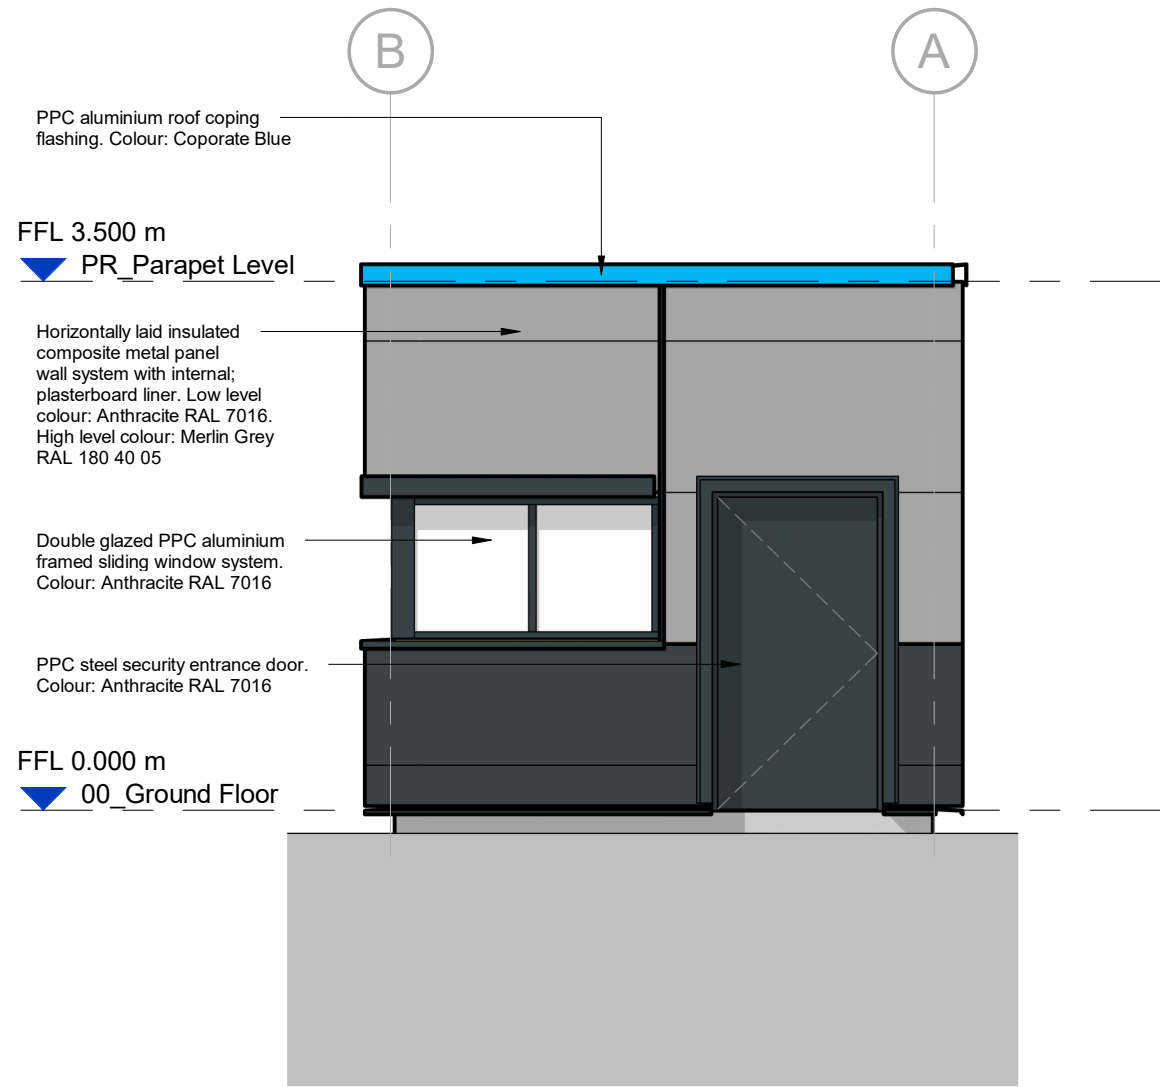


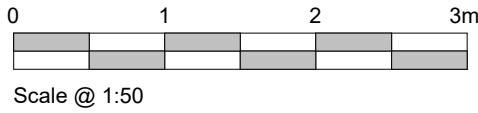


1 North West Elevation  
Scale @ 1 : 50

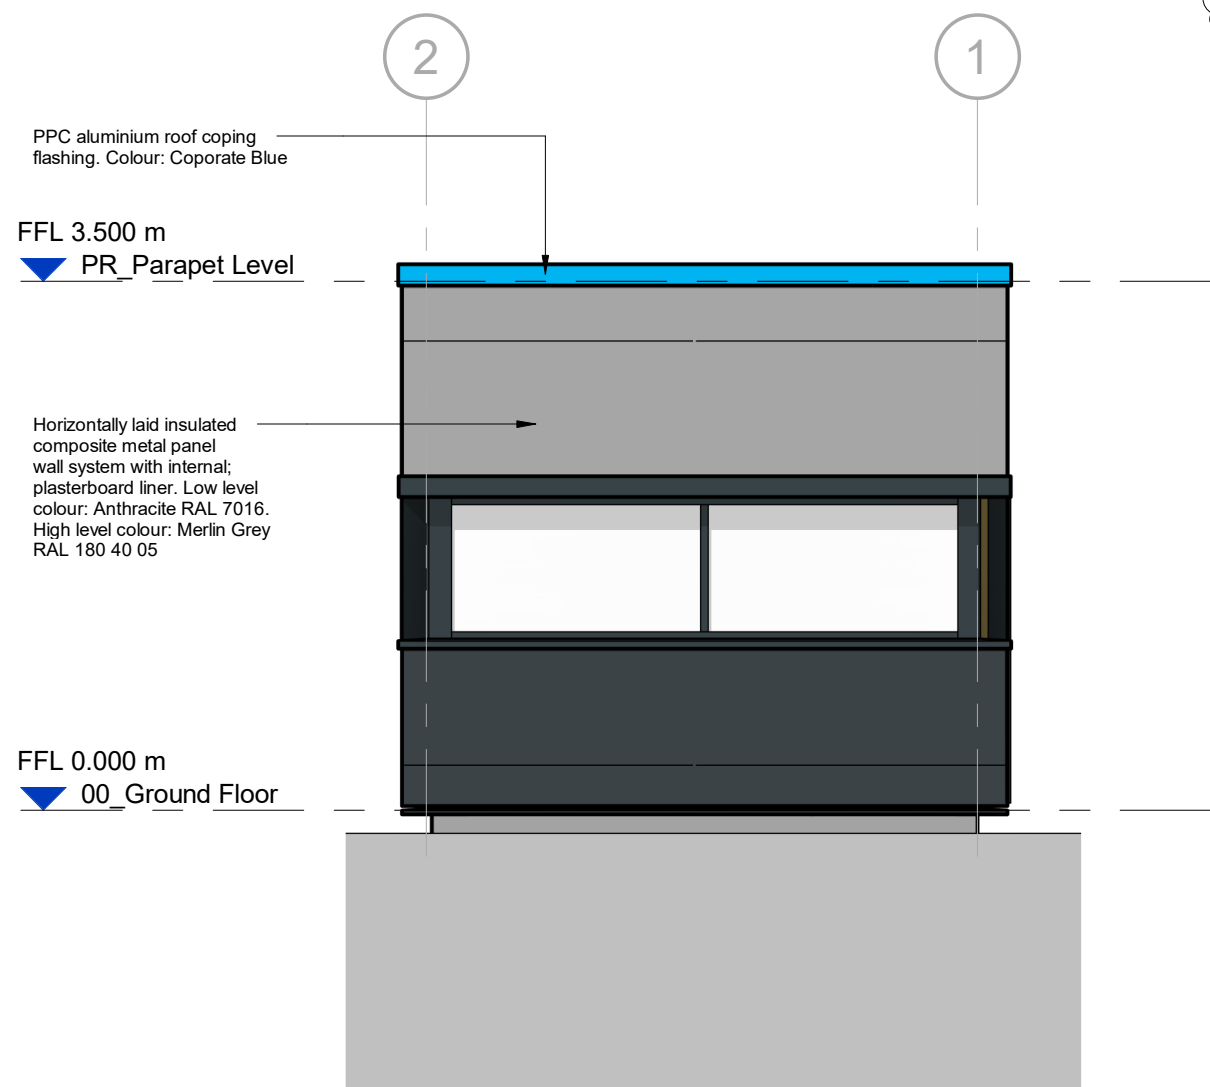


2 North East Elevation  
Scale @ 1 : 50

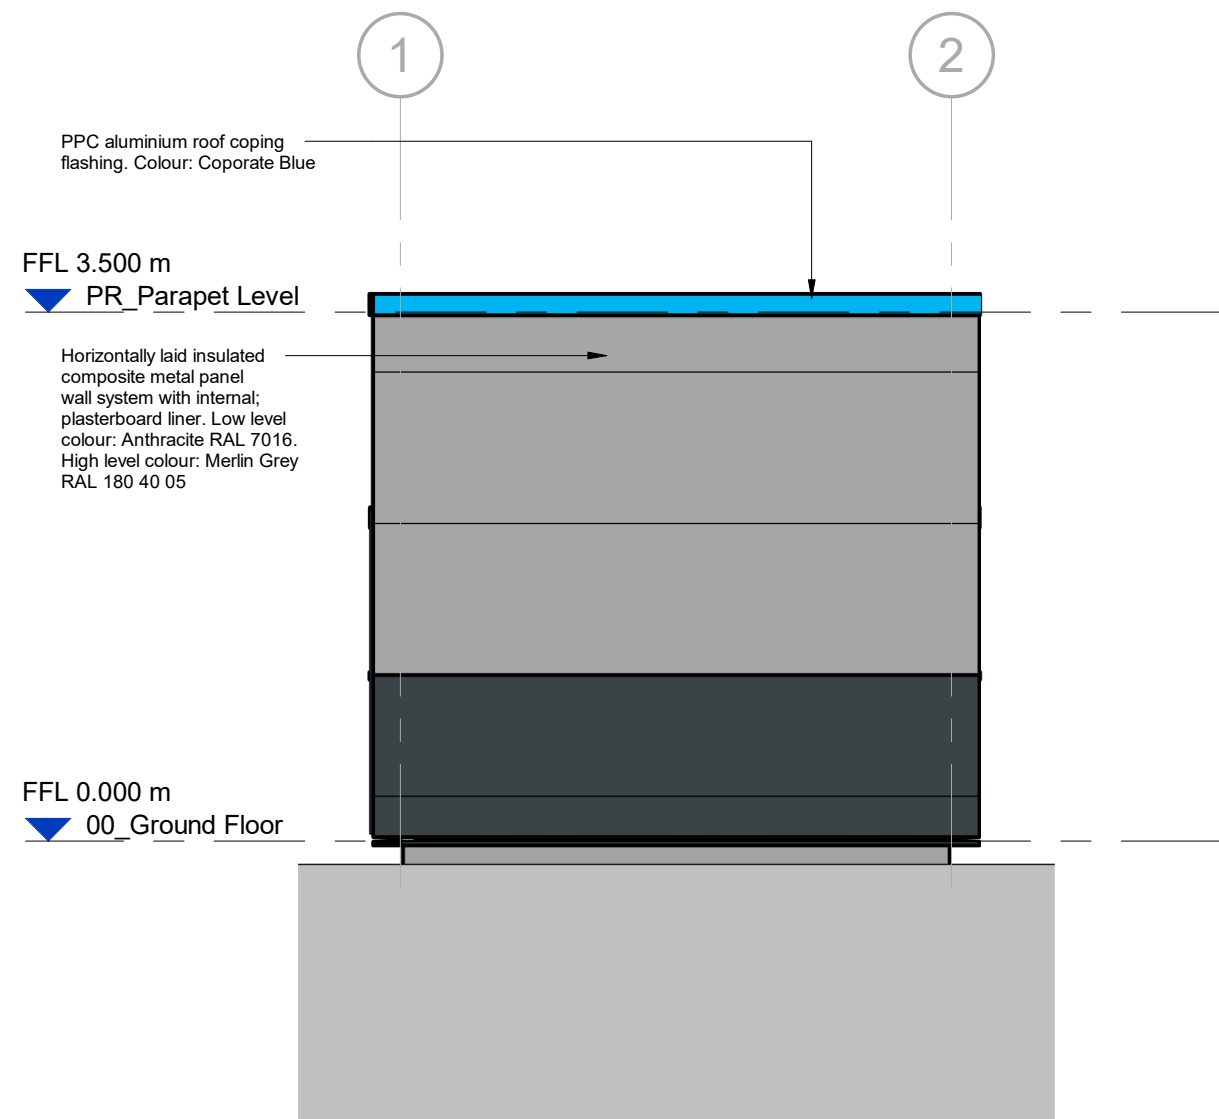

3 South West Elevation  
Scale @ 1 : 50

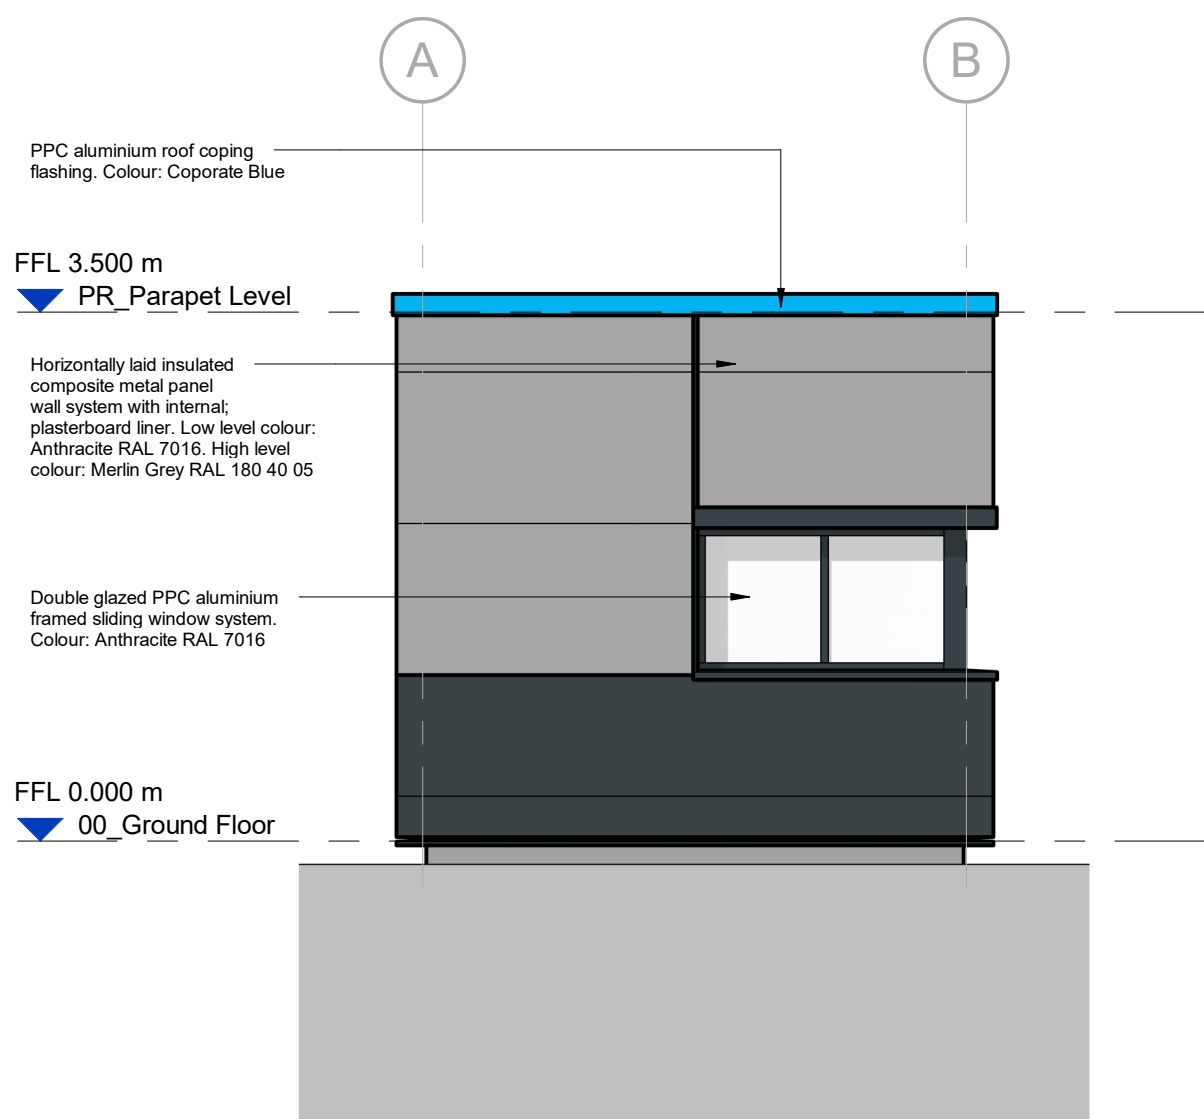

4 South East Elevation  
Scale @ 1 : 50

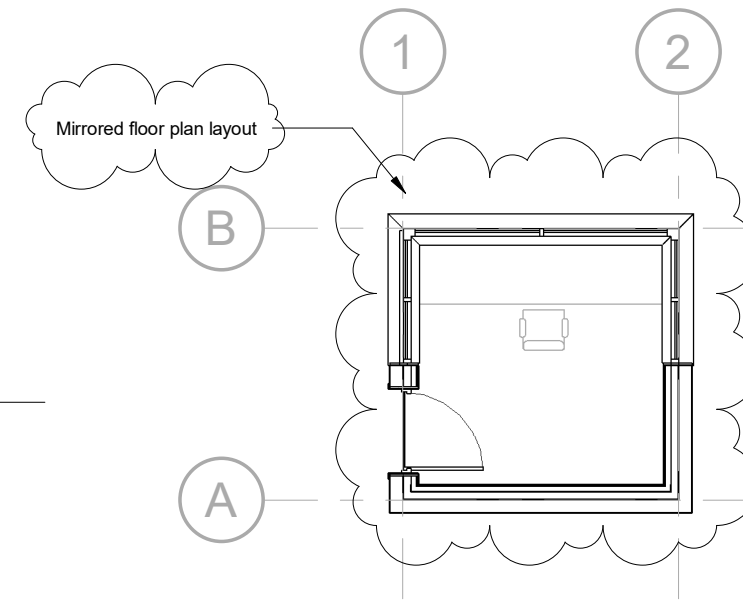

Key Plan  
Scale @ 1 : 100

## NOTES

- All dimensions and levels are to be checked on site.
  - Any discrepancies are to be reported to the architect before any work commences
  - This drawing shall not be scaled to ascertain any dimensions. Work to figured dimensions only.
  - This drawing shall not be reproduced without express written permission from AEW.
  - Title overlay drawings and ownership boundaries are produced using all reasonable endeavors. AEW cannot be responsible for the accuracy or scale discrepancy of base plans supplied to them.
  - All works are to be undertaken in accordance with Building Regulations and the latest British Standards.
  - All proprietary materials and products are to be used strictly in accordance with the manufacturers recommendations.
- This drawing contains the following model files: -
- KNW001-AEW-B3-XX-M3-A-0003\_Guardshack [P0.1] [S0]

## CDM 2015

Client notified of duties: **June 2019**  
Principal Designer: **CDM Contract Services**

Unless noted below, all known hazards have been highlighted on the drawing:

|                                                               |                  |             |               |
|---------------------------------------------------------------|------------------|-------------|---------------|
| P3                                                            | 28/02/22         | WS          | RD/DW         |
| Updated tenant requirements and technical design development. |                  |             |               |
| P2                                                            | 30/09/20         | NC          | ER            |
| Minor updates - refer to NMA mark-ups for details             |                  |             |               |
| P1                                                            | 04/02/20         | TF          | DRS           |
| Initial Issue                                                 |                  |             |               |
| REV                                                           | Date             | Drawn by: - | Checked by: - |
| Status                                                        | Purpose of Issue |             |               |
| S2                                                            | For Approval     |             |               |
| drawing stage                                                 | Tender Design    |             |               |

client



project

PLP Knowsley

drawing title

Proposed Guardshack Elevations

date 29.09.20 drawn NC  
scale @ A2 As indicated checked Checker

Rev P3

B8391-AEW-XX-XX-DR-A-0515

aew architects  
0161 214 4370  
www.aewarchitects.com

aew