



Knowsley Council

**REGENERATION AND ECONOMIC DEVELOPMENT
DEPARTMENT**

TOWN AND COUNTRY PLANNING ACT 1990

PLANNING PERMISSION

Application No: 25/00353/FUL

Name and address of applicant

The Wade Deacon Trust
Whiston Willis Community Primary
School, Early Years Milton Avenue
Whiston
Knowsley
L35 2XY

Name and address of agent

Falconer Chester Hall Ltd
12 Temple Street
Liverpool
L2 5RH

Date of Receipt: 6 June 2025

Date Valid: 22 July 2025

Address/Location Of Development:

**Whiston Willis Community Primary School
Milton Avenue
Whiston
Knowsley
L35 2XY**

Description of Development:

**ERECTION OF A SINGLE STOREY EXTENSION TO EXISTING DINING HALL
AND ERECTION OF A MODULAR BUILDING TO THE NORTH OF THE SITE**

The Council of the Metropolitan Borough of Knowsley hereby give notice in pursuance of the above Act(s) that Planning Permission has been **granted** for the carrying out of the development referred to above in accordance with the application and plans submitted subject to the following condition(s):

1. The development must be begun not later than the expiration of three years beginning with the date of this permission.

Reason: In order to comply with the requirements of Section 91 of the Town and Country Planning Act 1990 (as amended).

2. The development hereby permitted shall be carried out in accordance with the following approved plans and documents :-
 - a. Site Location Plan - Received (04/07/2025).
 - b. Modular Building Plans and Elevations - Received (04/07/2025).
 - c. Agent Email materials - Received (30/07/2025).
 - d. Extension - Proposed Elevations - Received (02/07/2025).

- e. Extension - Proposed Plans - Received (06/06/2025).
- f. Proposed Site Plan - Received (02/07/2025).

Reason: For the avoidance of doubt.

REASON(S) FOR THE GRANTING OF PLANNING PERMISSION

The decision to grant planning permission has also been taken having regard to the policies and proposals as set out below, and to all relevant material considerations including supplementary planning guidance:-

KNOWSLEY LOCAL PLAN: CORE STRATEGY

CS2 - Development Principles

CS7 - Transport Networks

CS8 - Green Infrastructure

CS19 - Design Quality and Accessibility in New Development

This informative is only intended as a summary of the reason(s) for the granting of planning permission. Should you require any further details relating to the decision please contact the relevant case officer (Andrew Hunt on 0151 443 2204)

ARTICLE 35 STATEMENT

The Local Planning Authority has acted positively and proactively in determining this application by assessing the proposal against all material considerations, including planning policies and any representations that may have been received and subsequently determining to grant planning permission in accordance with the presumption in favour of sustainable development, as set out within the National Planning Policy Framework.

NOTE FOR APPLICANT:

IMPORTANT - PLEASE READ CAREFULLY THE NOTES BELOW AS FAILURE TO COMPLY COULD MAKE THE DEVELOPMENT HEREBY PERMITTED UNAUTHORISED

- 1) This planning permission is granted in strict accordance with the approved plans. It should be noted however that:
 - a) Any variation from the approved plans following commencement of the development, irrespective of the degree of variation, will constitute unauthorised development and may be liable to enforcement action.
 - b) You or your agent or any other person responsible for implementing this permission should inform Planning Services immediately of any proposed variation from the approved plans and ask to be advised as to the best method to resolve the matter. Most proposals for variation to the approved plans will require the submission of a new planning application.
- 2) This permission is granted subject to conditions and it is the owner of the property and the person responsible for the implementation of the development who will be fully responsible for their compliance throughout the development and beyond.
- 3) If there is a condition that requires work to be carried out or details to be approved prior to the commencement of the development this is called a "condition precedent". The following should be noted with regards to conditions precedent.
 - a) If a condition precedent is not complied with prior to the start of development, the whole of the development will be unauthorised and you may be liable to enforcement action.
 - b) In addition, if the requirements of a condition precedent are subsequently not complied with, the development is unauthorised and the only way to rectify the development is the submission of a new application.

If any other type of condition is breached then you will be liable to a breach of condition notice.

Informatives

1. The proposed development lies within an area that has been defined by the Mining Remediation Authority as containing coal mining features at surface or shallow depth. These features may include: mine entries (shafts and adits); shallow coal workings; geological features (fissures and break lines); mine gas and former surface mining sites. Although such features are seldom readily visible, they can often be present and problems can occur, particularly as a result of new development taking place.

Any form of development over or within the influencing distance of a mine entry can be dangerous and raises significant land stability and public safety risks. As a general precautionary principle, the Mining Remediation Authority considers that the building over or within the influencing distance of a mine entry should be avoided. In exceptional circumstance where this is unavoidable, expert advice must be sought to ensure a suitable engineering design which takes account of all relevant safety and environmental risk factors, including mine gas and mine-water. Your attention is drawn to the Mining Remediation Authority Policy in relation to new development and mine entries available at: Building on or within the influencing distance of mine entries - GOV.UK

Any intrusive activities which disturb or enter any coal seams, coal mine workings or coal mine entries (shafts and adits) requires a Mining Remediation Authority Permit. Such activities could include site investigation boreholes, excavations for foundations, piling activities, other ground works and any subsequent treatment of coal mine workings and coal mine entries for ground stability purposes. Application forms for Mining Remediation Authority permission and further guidance can be obtained from The Mining Remediation Authority's website at: www.gov.uk/get-a-permit-to-deal-with-a-coal-mine-on-your-property

What is a permit and how to get one? - GOV.UK (www.gov.uk)

In areas where shallow coal seams are present caution should be taken when carrying out any on site burning or heat focused activities.

If any future development has the potential to encounter coal seams which require excavating, for example excavation of building foundations, service trenches, development platforms, earthworks, non-coal mineral operations, an Incidental Coal Agreement will be required. Further information regarding Incidental Coal Agreements can be found here - <https://www.gov.uk/government/publications/incidental-coal-agreement/guidance-notes-for-applicants-for-incidental-coal-agreements>

If any coal mining features are unexpectedly encountered during development, this should be reported immediately to the Mining Remediation Authority on 0800 288 4242. Further information is available on the Mining Remediation Authority website at: Mining Remediation Authority - GOV.UK

2. See attached letter from Merseyside Fire and Rescue.
3. See attached letter from Cadent Gas



Executive Director - Regeneration and Economic Development

Date: 20 August 2025

IMPORTANT NOTES FOR YOUR ATTENTION:

1. This permission refers only to that required under the Town and Country Planning Acts and does not include any consent or approval under any other enactment, bylaw, order or regulation.
2. This permission refers only to those plans submitted as part of the Planning Application a copy of which is retained by the Local Planning Authority. The Local Planning Authority should be contacted in writing if it is proposed to amend these plans in any way as a further permission, may be required.
3. You should ensure that you understand the requirements of all planning conditions and that you fully comply with their requirements. If you are in any doubt about what a condition requires of you, please ask us for assistance. Planning conditions may require you to submit further information to us and await our approval before you can start your development. A failure to do so could result in your development being unlawful and necessitate the submission of a further planning application. A failure to comply with the conditions of the permission/consent may result in the taking of enforcement and potentially legal action, against you to remedy the breach of planning control.
4. A fee is normally payable to discharge planning conditions in accordance with government regulations.
5. This permission does not convey any rights or approval to build on, or develop, any land that is not fully owned or controlled by you, including on party boundaries. You should satisfy yourself that the agreement of any adjoining landowners has been given prior to commencing any building works.
6. If a Building Regulations Consent is required for these works it is your responsibility to ensure that the plans submitted for both the Building Regulations Consent and Planning Permission are the same in all respects. Should the plans relating to one consent vary from the other, it will be necessary for you to submit amended plans to this Department and obtain the relevant approval(s) prior to commencing any works. Knowsley Council's Building Control team are contactable on (0151)-443 2342 and they would be pleased to assist you.

Appeals to the Secretary of State

- If you are aggrieved by the decision of your local planning authority to refuse permission for the proposed development or to grant it subject to conditions, then you can appeal to the Secretary of State under section 78 of the Town and Country Planning Act 1990.
- As this is a decision for a minor commercial application, if you want to appeal against your local planning authority's decision then you must do so within 12 weeks of the date of this notice.
- Appeals can be made online at: <https://www.gov.uk/planning-inspectorate>.
If you are unable to access the online appeal form, please contact the Planning Inspectorate to obtain a paper copy of the appeal form on tel: 0303 444 5000.
- The Secretary of State can allow a longer period for giving notice of an appeal but will not normally be prepared to use this power unless there are special circumstances which excuse the delay in giving notice of appeal.
- The Secretary of State need not consider an appeal if it seems to the Secretary of State that the local planning authority could not have granted planning permission for the proposed development or could not have granted it without the conditions they imposed, having regard to the statutory requirements, to the provisions of any development order and to any directions given under a development order.

Date: 06/08/2025

LinesearchbeforeUdig ref: 38262805

Your ref: 25/00353/FUL (DE)

Dear Sir/Madam,

Your planning application – No objection, informative note required

We have received a notification from the LinesearchbeforeUdig (LSBUD) platform regarding a planning application that has been submitted which is in close proximity to our medium and low pressure assets. We have no objection to this proposal from a planning perspective, however we need you to take the following action.

What you need to do

To prevent damage to our assets or interference with our rights, please add the following **Informative Note** into the **Decision Notice**:

Cadent Gas Ltd own and operate the gas infrastructure within the area of your development. There may be a legal interest (easements and other rights) in the land that restrict activity in proximity to Cadent assets in private land. The applicant must ensure that the proposed works do not infringe on legal rights of access and or restrictive covenants that exist.

If buildings or structures are proposed directly above the apparatus the development may only take place following diversion of the apparatus. The applicant should apply online to have apparatus diverted in advance of any works, by visiting cadentgas.com/our-services/gas-diversions

Prior to carrying out works, including the construction of access points, please register on www.linesearchbeforeudig.co.uk to submit details of the planned works for review, ensuring requirements are adhered to.

Your responsibilities and obligations

Cadent may have a Deed of Easement on the pipeline, which provides us with a right of access for a number of functions and prevents change to existing ground levels, storage of materials. It also prevents the erection of permanent/temporary buildings, or structures. If necessary Cadent will take action to legally enforce the terms of the easement.

This letter does not constitute any formal agreement or consent for any proposed development work either generally or related to Cadent's easements or other rights, or any planning or building regulations applications.

Cadent Gas Ltd or their agents, servants or contractors do not accept any liability for any losses arising under or in connection with this information. This limit on liability applies to all and any claims in contract, tort (including negligence), misrepresentation (excluding fraudulent misrepresentation), breach of statutory duty or otherwise. This limit on liability does not exclude or restrict liability where prohibited by the law nor does it supersede the express terms of any related agreements.

If you need any further information or have any questions about the outcome, please contact us at plantprotection@cadentgas.com or on 0800 688 588 quoting your reference at the top of this letter.

Kind Regards,


Plant Protection Team

T: 0800 688 588

plantprotection@cadentgas.com

cadentgas.com

Overview map of worksite

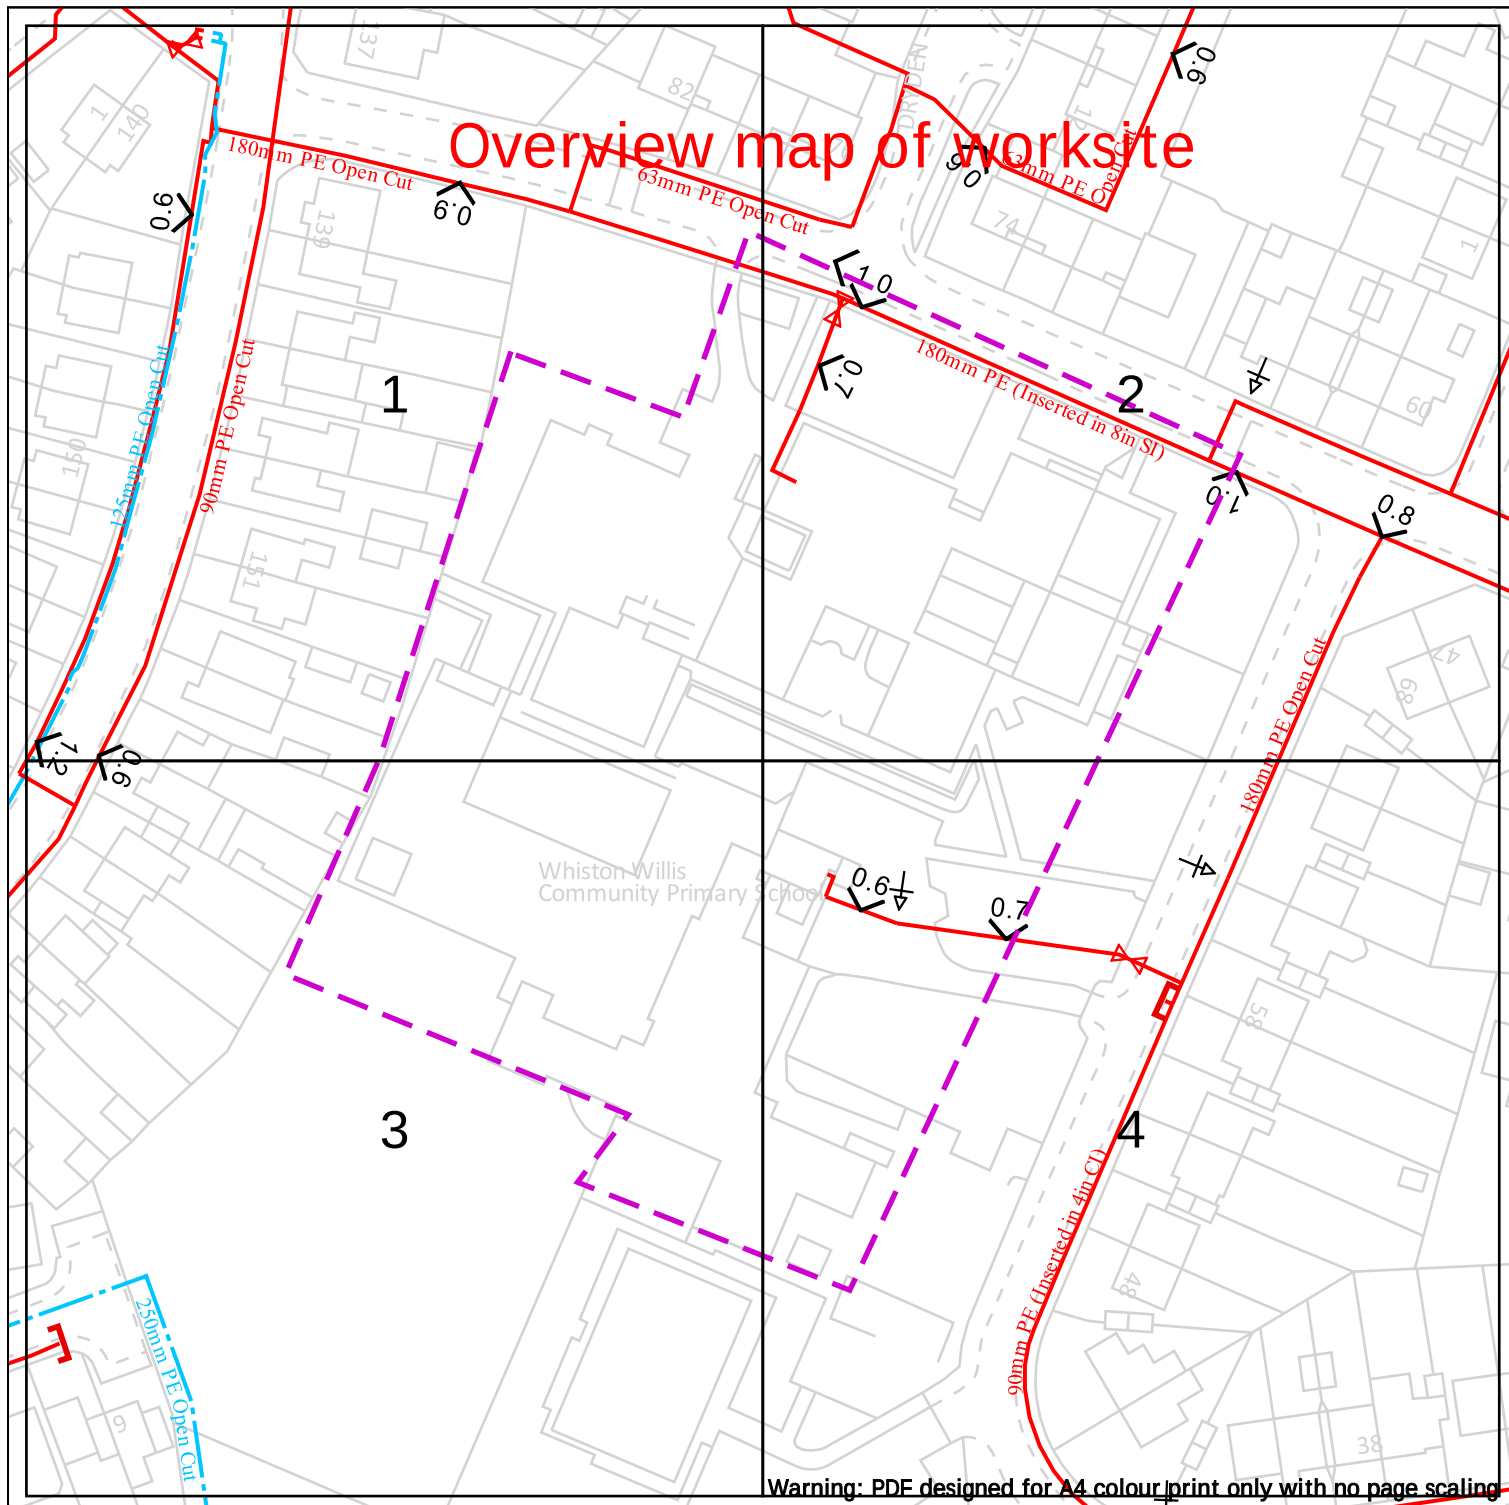


Warning: PDF designed for A4 colour print only with no page scaling

Cadent
Your Gas Network

Dig Sites

Area:

Line:

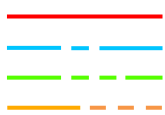

LP Mains
MP Mains
IP Mains
LHP Mains



Valve

Depth of cover

Syphon



Diameter Change

Material Change



Out of Standard Service

Where an out-of-standard service is present please contact plant protection 0800 688 588 for further information.

Out-of-standard service symbology may be used to indicate one or more of the following:

- Identification of shallow services
 - Identification of dual services
 - Recording of non-perpendicular services
- A perpendicular service/connection is laid in a straight line from the entry point at the property to the connection at the main – this includes a pipe that has a perpendicular connection and is not straight but does not deviate more than 1m off centre line.

Date Requested: 06/08/2025
Job Reference: 38262805
Site Location: 347324 391330
Requested by: Miss Dolapo Esan

Your Scheme/Reference:
25/00353/FUL (DE)

View extent: 100m, 100m


IMPORTANT NOTICES

This plan shows these pipes owned by Cadent Gas Limited in its role as a Licensed Gas Transporter (GT). Gas pipes owned by other GT's or otherwise privately owned may be present in this area. Information with regards to such pipes should be obtained from the relevant owners. The information shown on this plan is given without warranty, the accuracy thereof cannot be guaranteed. Service pipes, valves, syphons, stub connections etc. are not shown but their presence should be anticipated. No liability of any kind whatsoever is accepted by Cadent Gas Limited or their agents, servants or contractors for any errors or omission. Safe digging practices, in accordance with HS(G)47, must be used to verify and establish the actual position of mains, pipes, services and other apparatus on site before any mechanical plant is used. It is your responsibility to ensure that this information is provided to all persons (either direct labour or contractors) working for you on or near gas apparatus. The information included on this plan should not be referred to beyond a period of 28 days from the date of issue.

In case of emergency call - 0800 111 999

Scale: 1:1025 (When plotted at A4)

Crown Copyright © - This plan is reproduced from or based on the OS map by Cadent Gas Limited, with the sanction of the controller of HM Stationary Office. Crown Copyright Reserved. Ordnance Survey Licence number 100024886

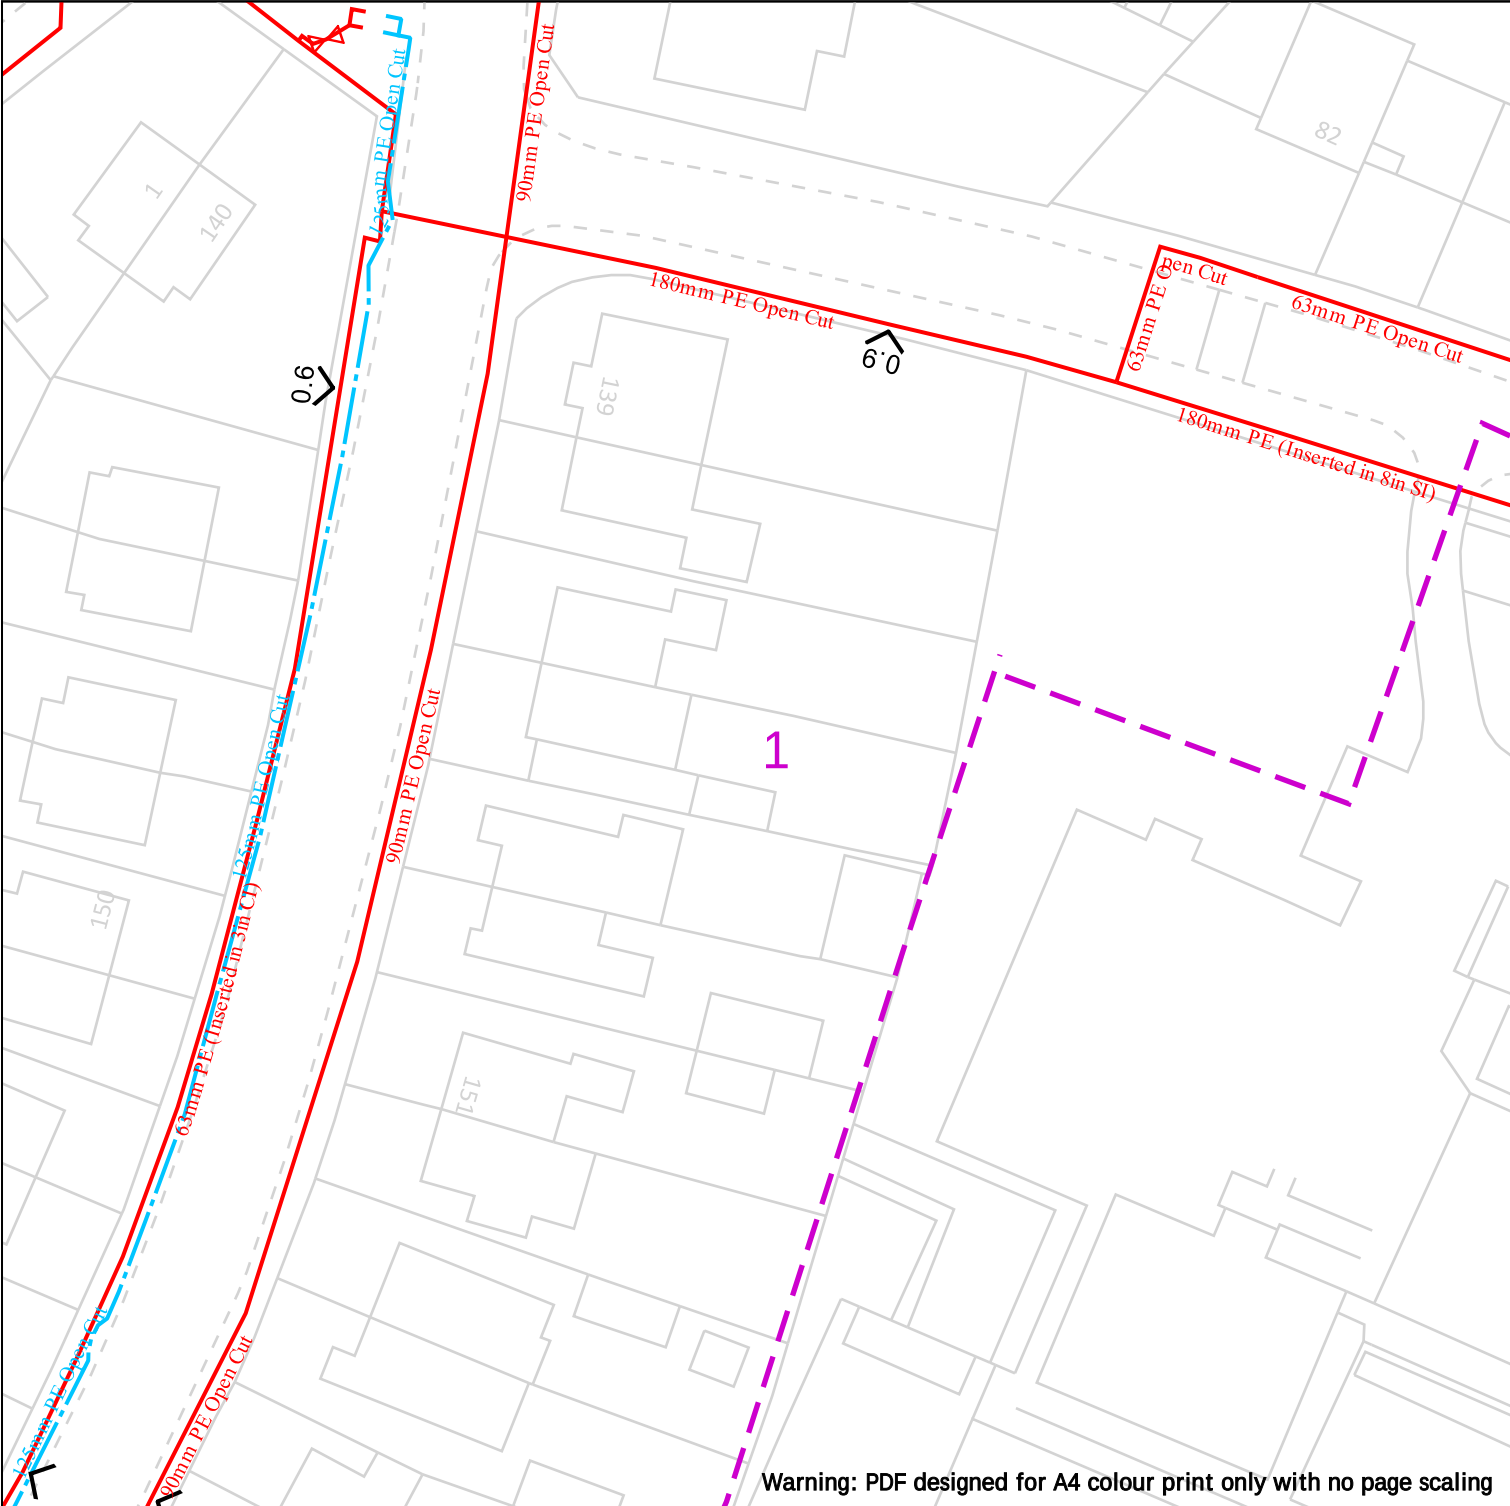

Warning: PDF designed for A4 colour print only with no page scaling



Cadent
Your Gas Network

Date Requested: 06/08/2025
Job Reference: 38262805
Site Location: 347324 391330
Requested by: Miss Dolapo Eсан

Your Scheme/Reference:
25/00353/FUL (DE)

View extent: 100m, 100m



25m

Dig Sites	Area: 	Line: 
 LP Mains	 Valve	 Diameter Change
 MP Mains	 Depth of cover	 Material Change
 IP Mains	 Syphon	 Out of Standard Service
 LHP Mains		

Where an out-of-standard service is present please contact plant protection 0800 688 588 for further information.

Out-of-standard service symbology may be used to indicate one or more of the following:

- Identification of shallow services
- Identification of dual services
- Recording of non-perpendicular services

A perpendicular service/connection is laid in a straight line from the entry point at the property to the connection at the main – this includes a pipe that has a perpendicular connection and is not straight but does not deviate more than 1m off centre line.


IMPORTANT NOTICES

This plan shows these pipes owned by Cadent Gas Limited in its role as a Licensed Gas Transporter (GT). Gas pipes owned by other GT's or otherwise privately owned may be present in this area. Information with regards to such pipes should be obtained from the relevant owners. The information shown on this plan is given without warranty, the accuracy thereof cannot be guaranteed. Service pipes, valves, syphons, stub connections etc. are not shown but their presence should be anticipated. No liability of any kind whatsoever is accepted by Cadent Gas Limited or their agents, servants or contractors for any errors or omission. Safe digging practices, in accordance with HS(G)47, must be used to verify and establish the actual position of mains, pipes, services and other apparatus on site before any mechanical plant is used. It is your responsibility to ensure that this information is provided to all persons (either direct labour or contractors) working for you on or near gas apparatus. The information included on this plan should not be referred to beyond a period of 28 days from the date of issue.

In case of emergency call - 0800 111 999

Scale: 1:500 (When plotted at A4)

Crown Copyright © - This plan is reproduced from or based on the OS map by Cadent Gas Limited, with the sanction of the controller of HM Stationary Office. Crown Copyright Reserved. Ordnance Survey Licence number 100024886

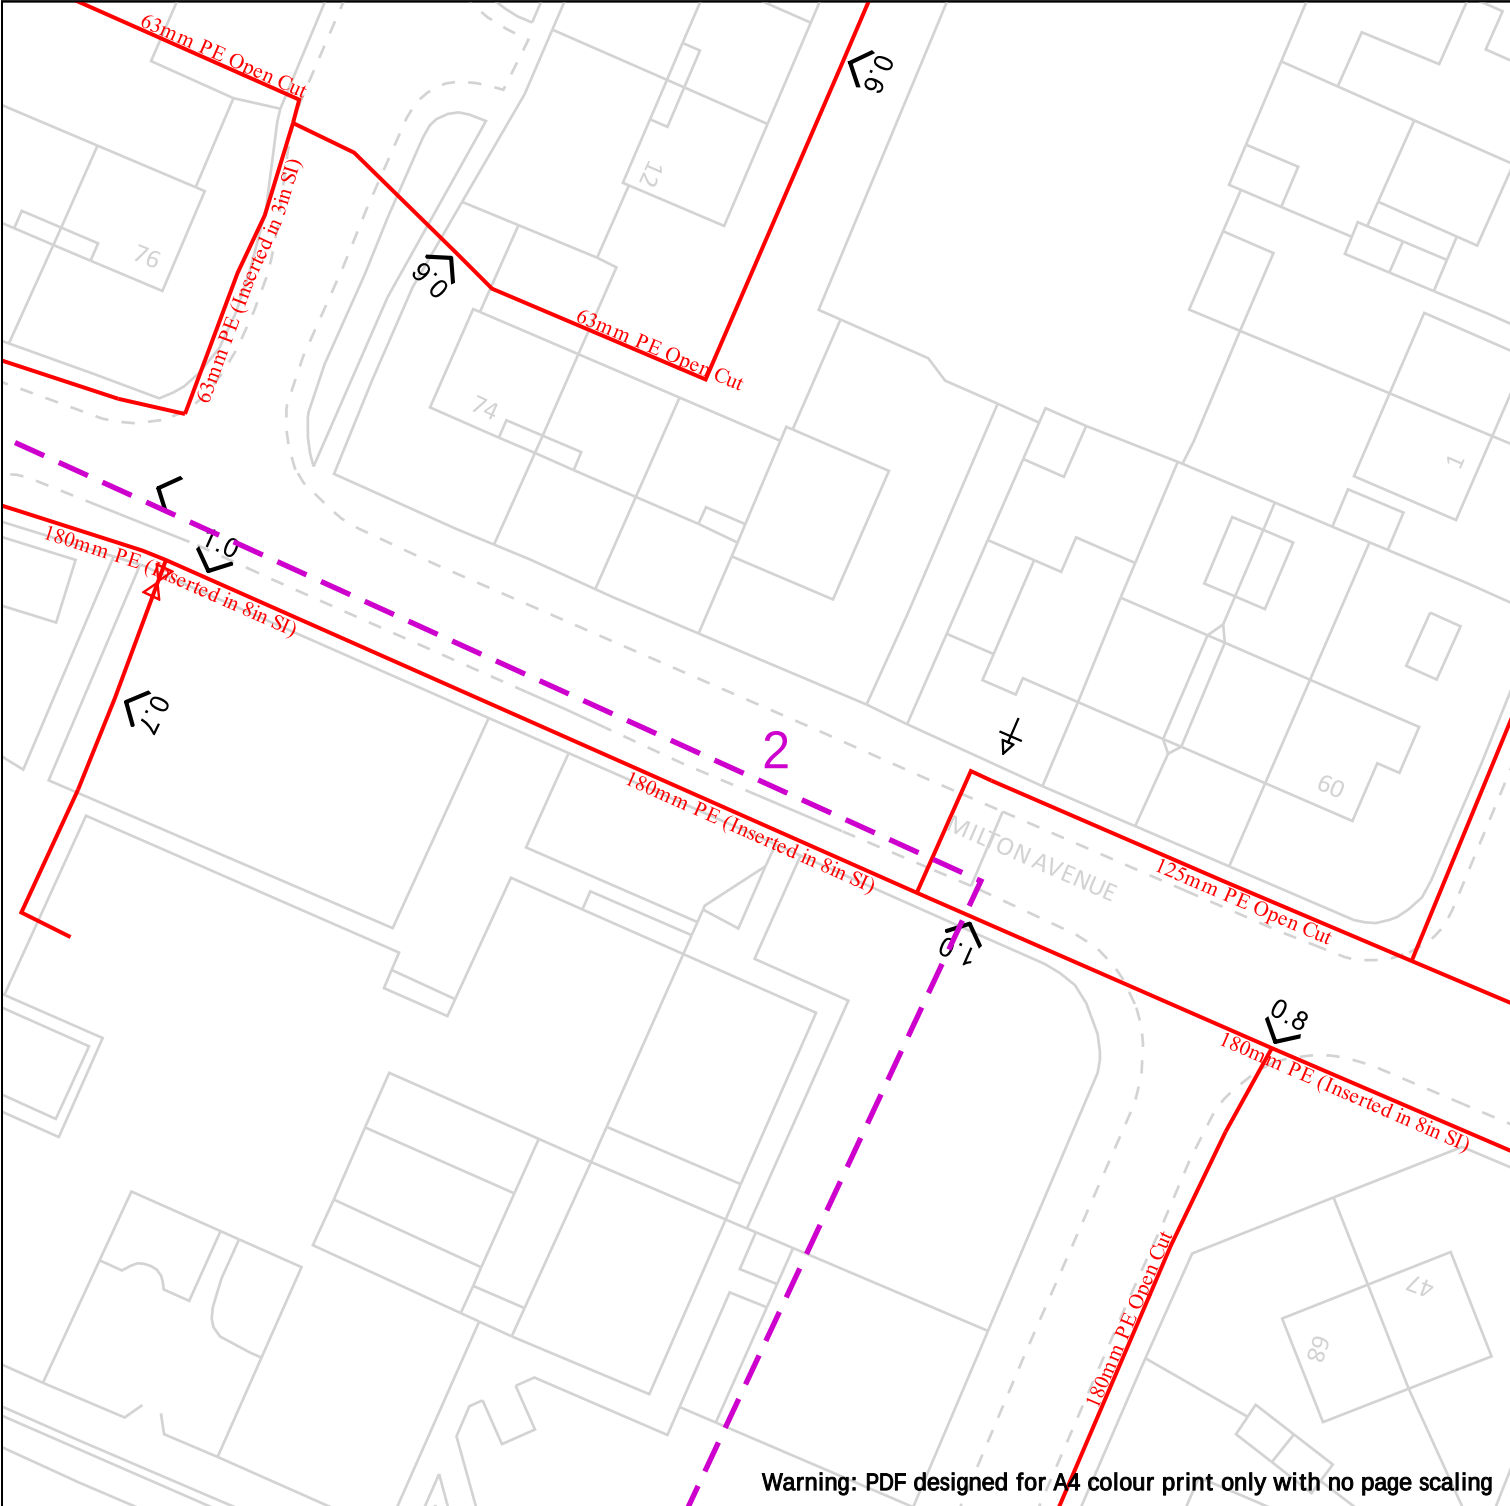



Cadent
Your Gas Network

Date Requested: 06/08/2025
Job Reference: 38262805
Site Location: 347324 391330
Requested by: Miss Dolapo Esan

Your Scheme/Reference:
25/00353/FUL (DE)

View extent: 100m, 100m

Dig Sites

Area:

Line:

LP Mains
MP Mains
IP Mains
LHP Mains

Valve
Depth of cover
Syphon

Diameter Change
Material Change
Out of Standard Service

Where an out-of-standard service is present please contact plant protection 0800 688 588 for further information.

Out-of-standard service symbology may be used to indicate one or more of the following:

- Identification of shallow services
- Identification of dual services
- Recording of non-perpendicular services


A perpendicular service/connection is laid in a straight line from the entry point at the property to the connection at the main – this includes a pipe that has a perpendicular connection and is not straight but does not deviate more than 1m off centre line.

IMPORTANT NOTICES

This plan shows these pipes owned by Cadent Gas Limited in its role as a Licensed Gas Transporter (GT). Gas pipes owned by other GT's or otherwise privately owned may be present in this area. Information with regards to such pipes should be obtained from the relevant owners. The information shown on this plan is given without warranty, the accuracy thereof cannot be guaranteed. Service pipes, valves, syphons, stub connections etc. are not shown but their presence should be anticipated. No liability of any kind whatsoever is accepted by Cadent Gas Limited or their agents, servants or contractors for any errors or omission. Safe digging practices, in accordance with HS(G)47, must be used to verify and establish the actual position of mains, pipes, services and other apparatus on site before any mechanical plant is used. It is your responsibility to ensure that this information is provided to all persons (either direct labour or contractors) working for you on or near gas apparatus. The information included on this plan should not be referred to beyond a period of 28 days from the date of issue.

In case of emergency call - 0800 111 999

Crown Copyright © - This plan is reproduced from or based on the OS map by Cadent Gas Limited, with the sanction of the controller of HM Stationary Office. Crown Copyright Reserved. Ordnance Survey Licence number 100024886

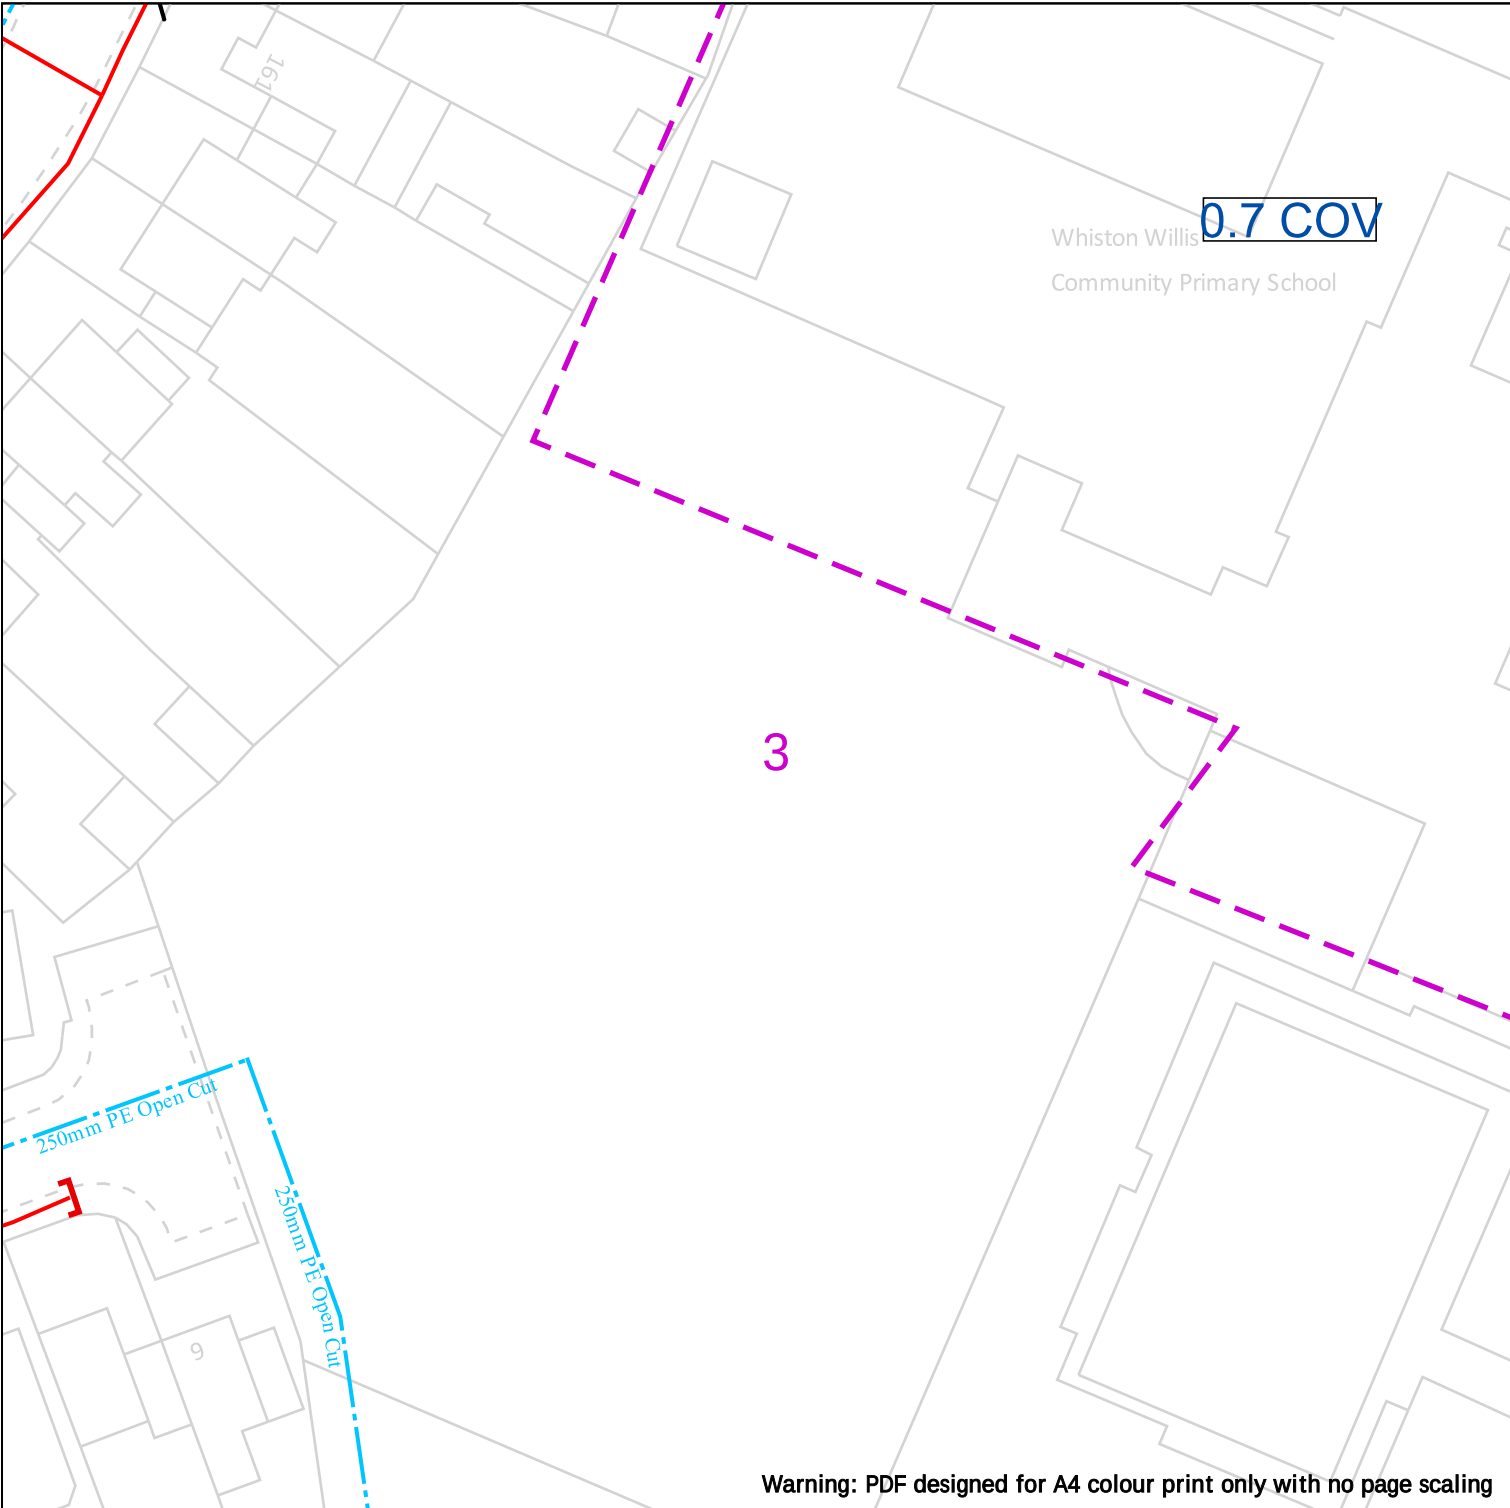

Warning: PDF designed for A4 colour print only with no page scaling


 Cadent Your Gas Network	 25m	Where an out-of-standard service is present please contact plant protection 0800 688 588 for further information. Out-of-standard service symbology may be used to indicate one or more of the following: • Identification of shallow services • Identification of dual services • Recording of non-perpendicular services A perpendicular service/connection is laid in a straight line from the entry point at the property to the connection at the main – this includes a pipe that has a perpendicular connection and is not straight but does not deviate more than 1m off centre line.																		
	<table><tr><td>Dig Sites</td><td>Area: </td><td>Line: </td></tr><tr><td></td><td>LP Mains</td><td> Valve</td><td> Diameter Change</td></tr><tr><td></td><td>MP Mains</td><td> Depth of cover</td><td> Material Change</td></tr><tr><td></td><td>IP Mains</td><td> Syphon</td><td> Out of Standard Service</td></tr><tr><td></td><td>LHP Mains</td><td></td><td></td></tr></table>	Dig Sites	Area: 	Line: 		LP Mains	 Valve	 Diameter Change		MP Mains	 Depth of cover	 Material Change		IP Mains	 Syphon	 Out of Standard Service		LHP Mains		
Dig Sites	Area: 	Line: 																		
	LP Mains	 Valve	 Diameter Change																	
	MP Mains	 Depth of cover	 Material Change																	
	IP Mains	 Syphon	 Out of Standard Service																	
	LHP Mains																			
In case of emergency call - 0800 111 999																				
Crown Copyright © - This plan is reproduced from or based on the OS map by Cadent Gas Limited, with the sanction of the controller of HM Stationary Office. Crown Copyright Reserved. Ordnance Survey Licence number 100024886																				

Date Requested: 06/08/2025
Job Reference: 38262805
Site Location: 347324 391330
Requested by: Miss Dolapo Esan

Your Scheme/Reference:
25/00353/FUL (DE)

View extent: 100m, 100m

Scale: 1:500 (When plotted at A4)

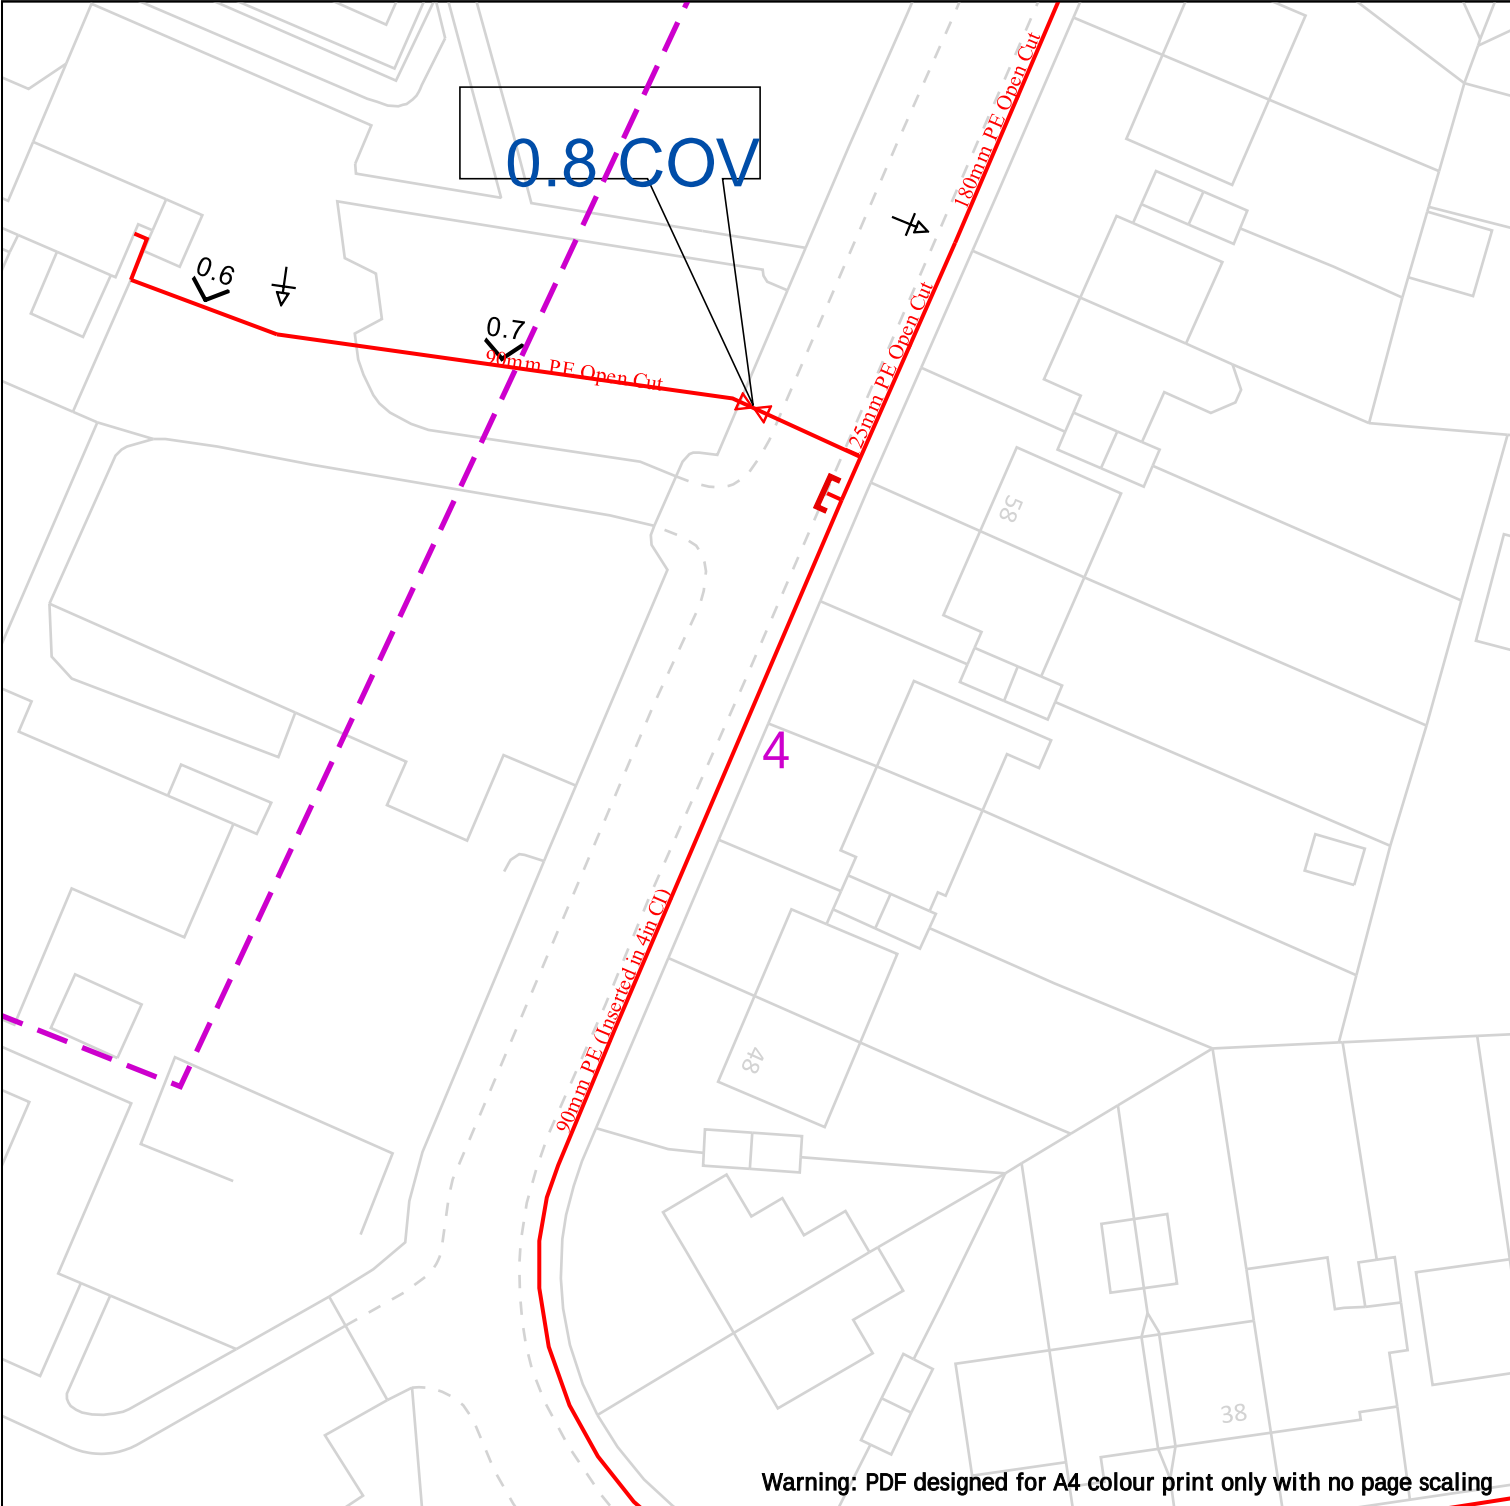

Warning: PDF designed for A4 colour print only with no page scaling



Cadent
Your Gas Network

Date Requested: 06/08/2025
Job Reference: 38262805
Site Location: 347324 391330
Requested by: Miss Dolapo Esan

Your Scheme/Reference:
25/00353/FUL (DE)

View extent: 100m, 100m



25m

Dig Sites	Area:	Line:

	Valve		Diameter Change
	Depth of cover		Material Change
	Syphon		Out of Standard Service

Where an out-of-standard service is present please contact plant protection 0800 688 588 for further information.

Out-of-standard service symbology may be used to indicate one or more of the following:

- Identification of shallow services
- Identification of dual services
- Recording of non-perpendicular services

A perpendicular service/connection is laid in a straight line from the entry point at the property to the connection at the main – this includes a pipe that has a perpendicular connection and is not straight but does not deviate more than 1m off centre line.

IMPORTANT NOTICES

This plan shows these pipes owned by Cadent Gas Limited in its role as a Licensed Gas Transporter (GT). Gas pipes owned by other GT's or otherwise privately owned may be present in this area. Information with regards to such pipes should be obtained from the relevant owners. The information shown on this plan is given without warranty, the accuracy thereof cannot be guaranteed. Service pipes, valves, syphons, stub connections etc. are not shown but their presence should be anticipated. No liability of any kind whatsoever is accepted by Cadent Gas Limited or their agents, servants or contractors for any errors or omission. Safe digging practices, in accordance with HS(G)47, must be used to verify and establish the actual position of mains, pipes, services and other apparatus on site before any mechanical plant is used. It is your responsibility to ensure that this information is provided to all persons (either direct labour or contractors) working for you on or near gas apparatus. The information included on this plan should not be referred to beyond a period of 28 days from the date of issue.

In case of emergency call - 0800 111 999

Crown Copyright © - This plan is reproduced from or based on the OS map by Cadent Gas Limited, with the sanction of the controller of HM Stationary Office. Crown Copyright Reserved. Ordnance Survey Licence number 100024886

Knowsley MBC
Planning Department
Municipal Buildings
Archway Road
Huyton
L36 9YU

**Merseyside Fire & Rescue Authority
Community Fire Protection**

Fire Engineering Team
Service Headquarters
Bridle Road
Bootle
Merseyside
L30 4YD

Email: dcconsultations@knowsley.gov.uk

Telephone: 0151 296 6590 (Calls may be recorded)
Inspecting Officer: David Shawcroft
Email: fireengineeringteam@merseyfire.gov.uk
web Site: www.merseyfire.gov.uk

Your ref: 25/00353/FUL Our ref: 00455935/1348449/DS/LM Date: 11th August 2025

Dear Sir/Madam,

THE TOWN AND COUNTRY PLANNING ACT 1990
PLANNING APPLICATION NUMBER REF: 25/00353/FUL
PROPOSAL: ERECTION OF A SINGLE STOREY EXTENSION TO EXISTING DINING
HALL AND ERECTION OF A MODULAR BUILDING TO THE NORTH OF THE SITE
ADDRESS: Whiston Willis Community Primary School Milton Avenue Whiston

The Fire Authority requests that any decision notice includes the following information;

The plans relating to the above application have been examined and below are the Fire Authority's observations:

Access for Fire Fighting

- Access for fire appliances should comply with the requirements of Section B5, Schedule 1 of the Building Regulations. Provisions for access will depend on the size and use of the building. The design of the access route, for example minimum road widths and maximum reversing distances, should also be considered (Appendix A, attached).
- In accordance with Section 55 of the County of Merseyside Act 1980, the position of the premises should not compromise or impede existing means of fire service access to a neighbouring building.

Water Provision

- Water supplies for firefighting purposes should be risk assessed in accordance with the undermentioned guidance in liaison with the water undertakers (United Utilities - 0161 907 7351) with suitable and sufficient fire hydrants supplied.
- Consideration should be given to the recommendations within the 'National guidance document on the provision of water for fire fighting', produced by the Local Government Association and Water UK, available for free download via: <https://www.water.org.uk/national-guidance-document-provision-water-firefighting>

Further information regarding access requirements can be found in the current version of Approved Document B, which is available for free download via:

<https://www.gov.uk/government/publications/fire-safety-approved-document-b>

Should you require any further information in respect of this correspondence please contact the Officer named above.

Yours faithfully,

David Shawcroft

Authorised Fire Safety Inspecting Officer
And on behalf of Merseyside Fire and Rescue Authority

Appendix A - Access and Facilities for the Fire Service as given in Section B5 of Approved Document B

Domestic Dwellings

For dwelling houses, access for a pumping appliance should be provided to within 45m of all points inside the dwelling house.

For flats, either: access for a pumping appliance should be provided to within 45m of all points inside each flat of a block, measured along the route of the hose; or fire mains should be provided.

Commercial Buildings

Small buildings (up to 2000m², with a top occupied storey a maximum of 11m above ground level), require access for a pump appliance to 15% of the perimeter, or within 45m of every point of the footprint of the building, whichever is the less onerous.

Larger buildings will require access to a percentage of the perimeter that increases incrementally with size of the total floor area and height of building – please see details in Approved Document B Volume 2 Section 15.

Elevations to which vehicle access is provided will require a door, to give access into the building. The maximum distance between doors, or between a door and the end of the elevation, is 60m (ie a 150m elevation would need a minimum of two doors).

All Buildings

Access routes and hardstanding should comply with Table 13.1 ADB Volume 1 / Table 15.2 ADB Volume 2. Please note: MFRS appliances are 17 tonnes (pump) and 26 tonnes (high reach).

Dead-end access routes longer than 20m require turning facilities (eg a turning circle or hammer head, or other turning point).

Where fire mains are fitted, access should be provided for a pumping appliance to within 18m of each fire main inlet connection point. Inlets should be on the face of the building and visible from the parking position of the appliance. The run of horizontal internal connecting pipe should be a maximum of 18m in length.

Buildings with a storey more than 18m above the fire service vehicle access level, or a basement more than 10m below, should have one or more firefighting shafts containing fire-fighting lifts and fire mains (a minimum of two fire-fighting shafts will be required for buildings with a floor area of 900 m² or more).

Buildings in the 'shop and commercial', 'assembly and recreation' or 'industrial' purpose groups (Groups 4, 5, or 6), with a storey area of 900m² or more and a storey height of 7.5m or more above fire service vehicle access level will require at least two firefighting shafts (firefighting lifts may not be needed).

Entry to a firefighting shaft at fire service access level should be available either directly from the open air or by way of a protected corridor not exceeding 18m in length. The corridor is deemed to be part of the firefighting shaft, and any access to it from the accommodation should be by way of protected lobbies.

Hydrants

Where a building has a compartment with an area of more than 280m² and is being erected more than 100m from an existing fire hydrant, additional hydrants are required as follows:

Buildings with fire main – hydrant within 90m of dry fire main inlet;

Buildings without fire main – hydrant within 90m of an entrance to the building; and a maximum of 90m apart.