


PROPOSED SITE AREA
(EXCLUDING ACCESS & EGRESS)
9726.24 SQFT
903.59 SQM

PROPOSED SITE AREA DEMISE
(EXCLUDING ACCESS & EGRESS)

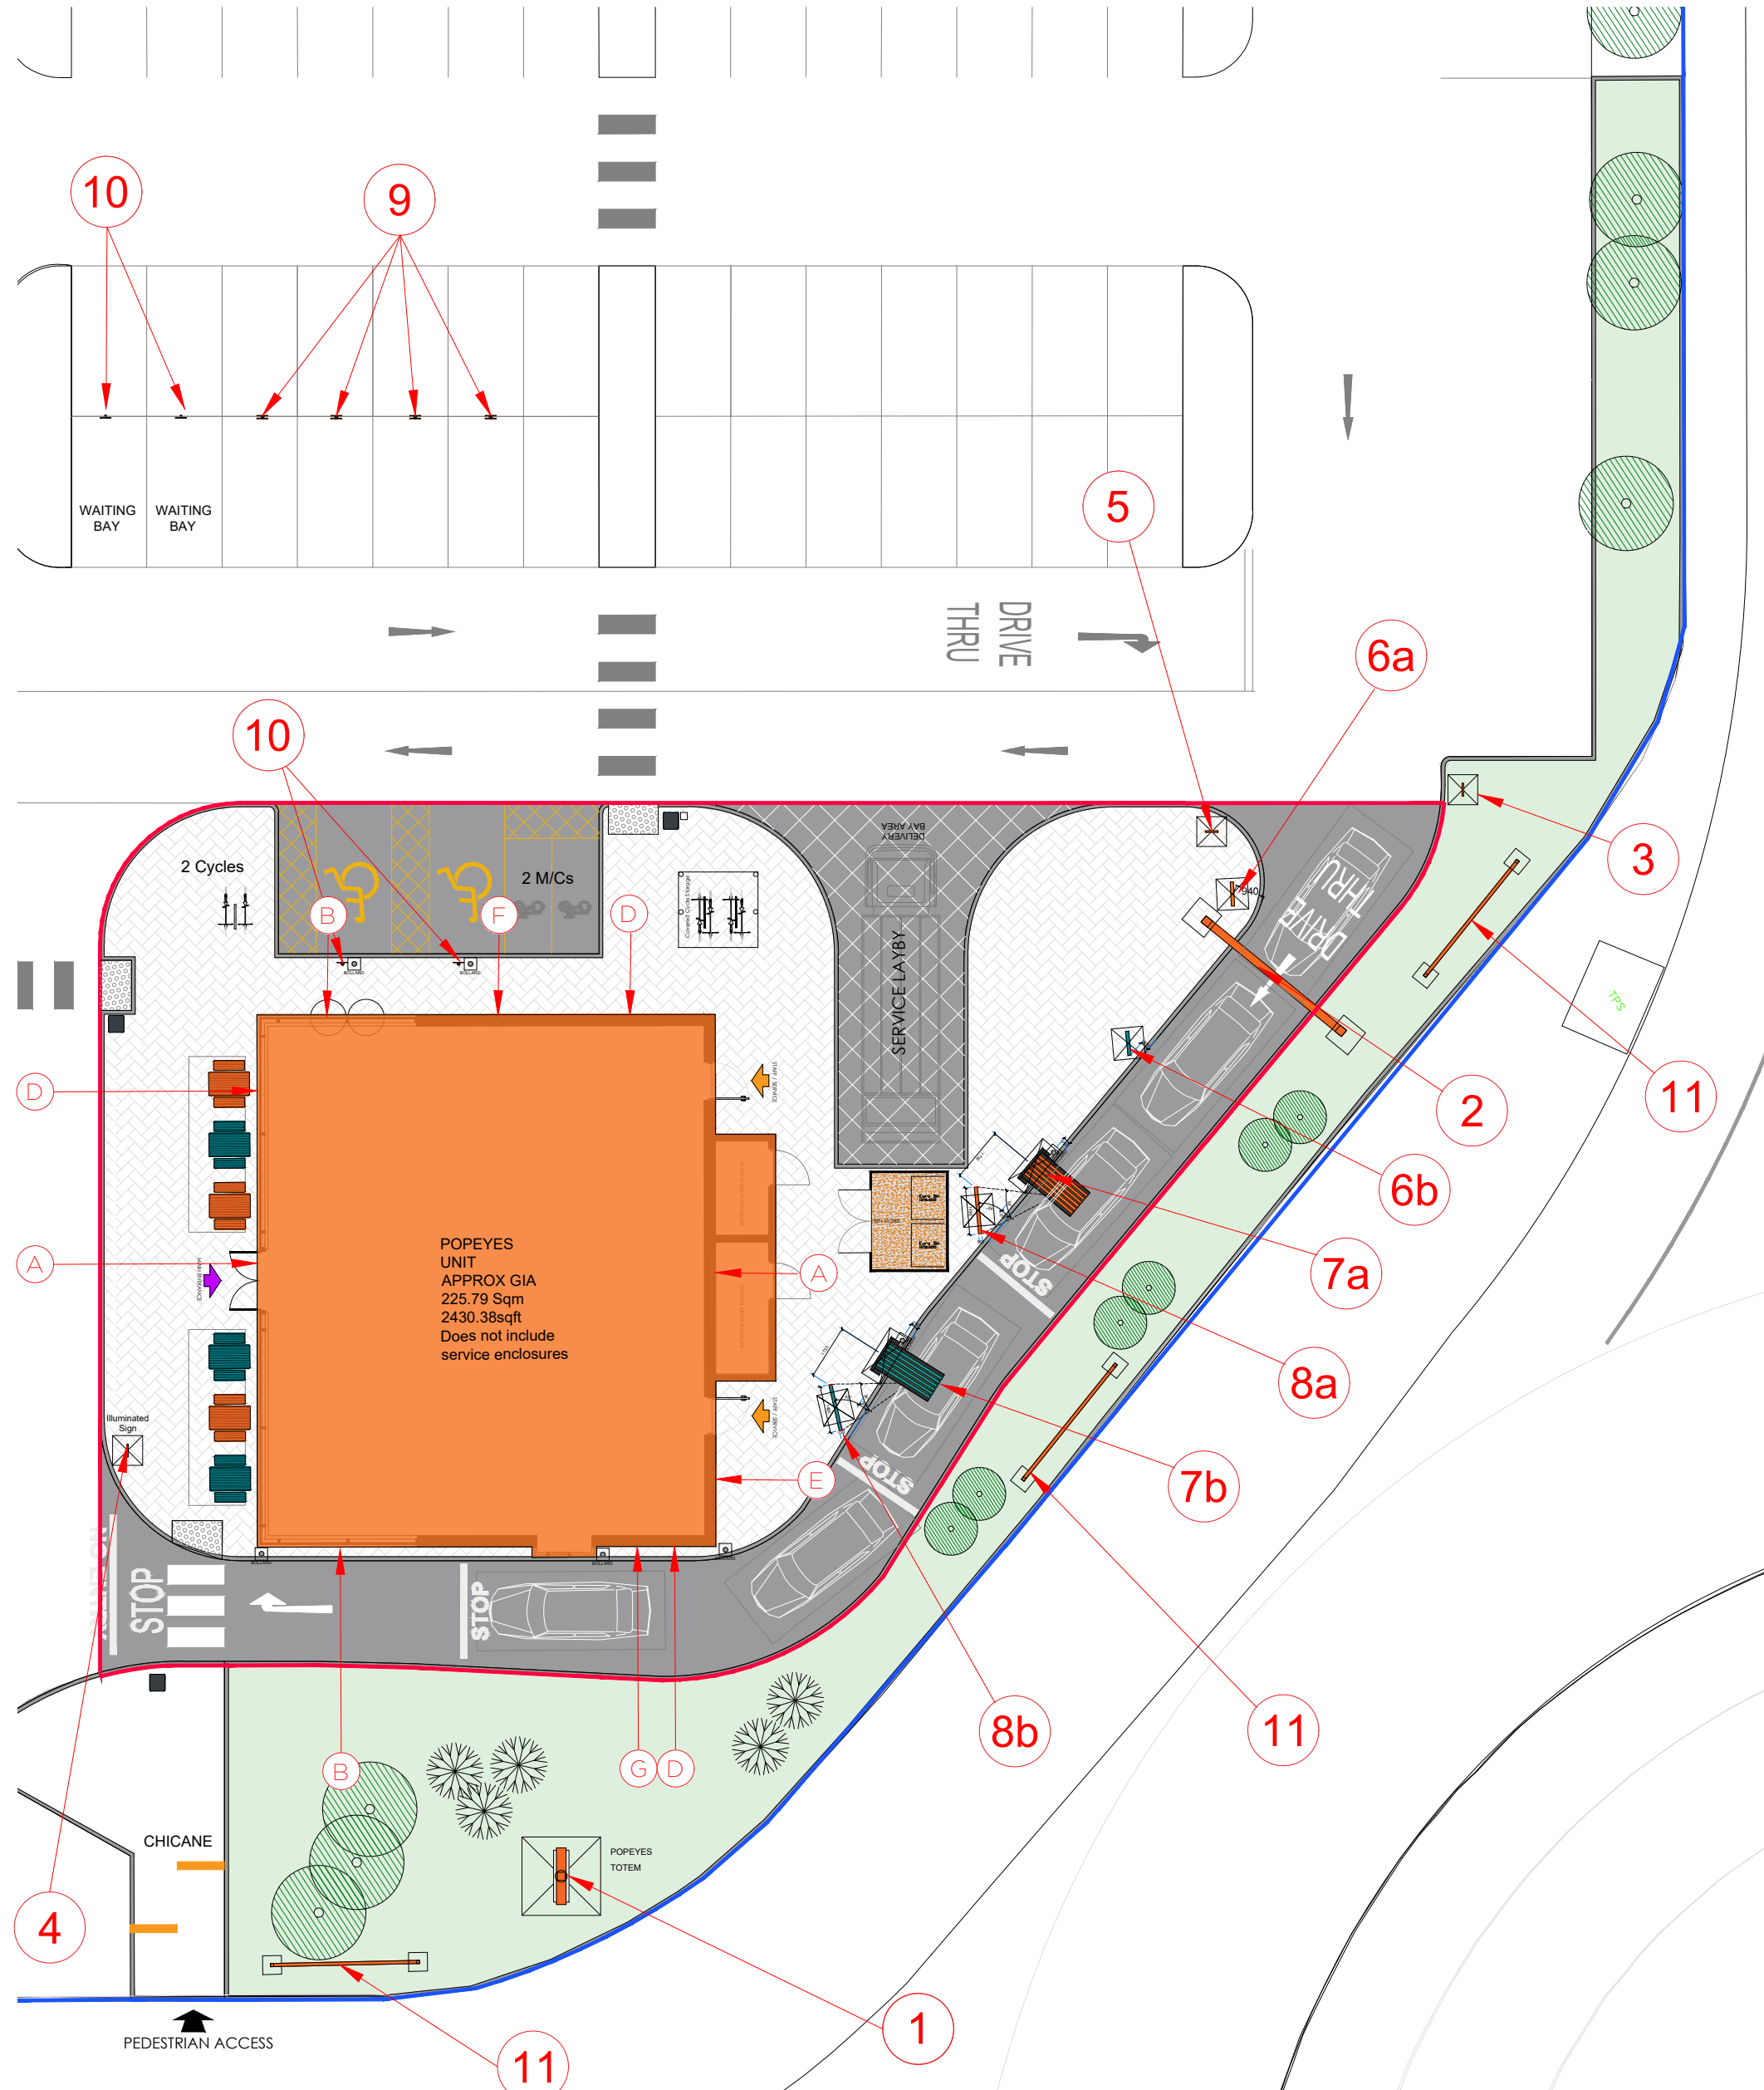

PROPOSED SITE PLAN
SCALE 1:200
0m 2 4 10 20

FACADE SIGNAGE SCHEDULE		
ITEM	EXAMPLE (NTS)	DESCRIPTION
A		POPEYES' LOGO Internally illuminated signage - 225 candelas per sqm Size: 4185 x 670 x 80 mm / 5640 x 900 x 80 mm Detail: Finish flex wording logo extruded aluminium sign comp system finished RAL 9016 illumination provided banks of LED. Flex face substrate is to be decorated with face applied 3M self adhesive films. Orange returns. Colour: RAL 9016 and RAL 2003
B		POPEYES' BRAND SEAL Internally illuminated signage - 225 candelas per sqm Size: 1600mm DIA x 120mm Detail: Finish flex logo extruded aluminium sign comp system finished Orange on white background, illumination provided banks of LED. Flex face substrate is to be decorated with face applied 3M self adhesive films. Colour: RAL 9016 / RAL 2003
C	OMITTED	OMITTED
D		'DRIVE THRU' LOGO Internally illuminated signage - 225 candelas per sqm Size: 2867mm x 810mm x 70mm Detail: Finish flex wording logo extruded aluminium sign comp system finished RAL 9016 illumination provided banks of LED. Flex face substrate is to be decorated with face applied 3M self adhesive films. Colour: RAL 9016
E		'BREAKFAST EVERYDAY' VINYL Non-illuminated vinyl signage Size: 2500mm x 1215mm Detail: Vinyl cut Graphic Colour: RAL 2003 & 5018 & 1018
F		'WELCOME TO LOUISIANA' VINYL Non-illuminated vinyl signage Size: 5071mm x 2400mm Detail: Vinyl cut Graphic Colour: RAL 2003 & 5018
G		'YA'LL READY FOR THIS' VINYL Non-illuminated vinyl signage Size: 2800mm x 695mm Detail: Vinyl cut Graphic Colour: RAL 2003
H		'POPPY MANIFESTATION' VINYL Non-illuminated frosted vinyl signage Size: 75mm x 65mm Detail: Vinyl cut Graphic Colour: As Shown
J	OMITTED	OMITTED

SIGNAGE SCHEDULE

INT.	IMAGE	DESCRIPTION
1.		POPEYES TOTEM - 8 METERS 1no. 8.0 meters high mild steel post finished turquoise blue, RAL 5018 with internally illuminated roundel, logo and DT boxes. LOUISIANA CHICKEN BOX 1360mm DIA, 30mm rim and return rings having carc. rim and return painted semi-gloss Pastel Orange RAL 2003. Orange translucent vinyl to the opal acrylic face & illuminated by cool white LED's within the back tray. POPEYES BOX & DT BOX 30mm rim and return rings having carc. rim and return painted semi-gloss Pastel Orange RAL 2003. Orange translucent vinyl to the opal acrylic face & illuminated by cool white LED's within the back tray. ADVERT BOX 30mm rim and return rings having carc. rim and return painted semi-gloss pastel orange RAL 2003 with rim to be removable to allow access to individual interchange letters mounted to opal acrylic face illuminated by cool white LEDs mounted internally around edge
2.		POPEYES HEIGHT RESTRICTIONS 1no. free standing Height Restrictor. Consisting of an internal folded aluminium box section frame work finished Pastel Orange RAL 2003. C/W cladding panels to the horizontal beam only, with backed up opal and internally illuminated LED's mounted within. Height Restrictor Bar, capped at both ends finished Traffic Red RAL 3020 with white reflective vinyl graphic strips. Hung by white chains and hooks attached to the framework.
3.		POPEYES WAYFINDING SIGNAGE 1no. free standing internally illuminated directional. Consisting of a box section internal framework with base plate to accept 2mm aluminium cladding panels. Fret cut panel finished Pastel Orange RAL 2003 & grey brown vinyl to match RAL 7016 with push through white opal and illuminated via LED's mounted within. Wording to be agreed
4.		POPEYES WAYFINDING SIGNAGE 1no. free standing internally illuminated directional. Consisting of a box section internal framework with base plate to accept 2mm aluminium cladding panels. Fret cut panel finished Pastel Orange RAL 2003 & grey brown vinyl to match RAL 7016 with push through white opal and illuminated via LED's mounted within.
5.		POPEYES WAYFINDING SIGNAGE 1no. free standing internally illuminated directional. Consisting of a box section internal framework with base plate to accept 2mm thick folded aluminium cladding panels. Fret cut panel finished Pastel Orange RAL 2003 & grey brown vinyl to match RAL 7016 with push through white opal and illuminated via LED's mounted within.
6.		POPEYES SINGLE MENU BOARD 2no. free standing Menu Boards (Digital) 6a - 1no. Pastel Orange RAL 2003 6b - 1no. Turquoise RAL 5018 Based / cover plate Anthracite grey brown RAL 7016.
7.		POPEYES ORDER CANOPY 2no. free standing Order Canopy. Consisting of a box section internal framework with base plate to accept 2mm thick folded aluminium cladding panels finished Paste Orange RAL 2003. 'ORDER HERE' in face applied internally illuminated. 'L' shaped vertical fins finished Paste Orange RAL 2003, with base/cover plate grey brown RAL 7016. Fabricated turquoise aluminium rain panels mounted and set between the horizontal beams at slight angles so water falls in one direction (as indicated). 7a - 1no. Pastel Orange RAL 2003 main colour as above. 7b - 1no. Turquoise RAL 5018 main colour.
8.		POPEYES DOUBLE MENU BOARD 2no. free standing Menu Boards (Digital) 8a - 1no. Pastel Orange RAL 2003 8b - 1no. Turquoise RAL 5018 Panels to be finished in Pastel Orange RAL 2003 Panels to be finished in Pastel Turquoise RAL 5018 Based / cover plate grey brown RAL 7016
9.		POPEYES BAY SIGNS 4no. 3mm Aluminium panel c/w a digitally printed graphic onto white reflective vinyl applied to the panel face and on the rear, channel for fixing to post finished semi gloss Traffic White, RAL 9016, panel fitter to 76mm post with clips with post finished semi-gloss Anthracite Grey RAL 5018. - 4no. Double Sided Kerbside Pick Up Bay Signs
10.		POPEYES BAY SIGNS 4no. 3mm Aluminium panel c/w a digitally printed graphic onto white reflective vinyl applied to the panel face and on the rear, channel for fixing to post finished semi gloss Traffic White, RAL 9016, panel fitter to 76mm post with clips with post finished semi-gloss Anthracite Grey RAL 5018. 10A - 2no. Waiting Bay Signs 10B - 2no. Disabled Bay Signs
11.		POPEYES BANNER SIGNS 3no. 1016mm x 50.8mm x 3.2mm Aluminium U channel with pre-drilled 10mm diameter fixing holes finished RAL 2003 Pastel Orange. Channel installed back to back with sandwich aluminium panel inside to form crossbar and posts. Bolted together using m8 bolts and nuts finish in RAL 2003 Pastel Orange. 3660mm x 1292mm x 3mm cnc cut aluminium panel finished in RAL 2003 Pastel Orange with White s/a vinyl logo Non illuminated.

- NOTES**
- ALL DIMENSIONS IN MILLIMETRES (mm) AND LEVELS IN METRES (m) ABOVE NATIONAL DATUM. ALL DIMENSIONS TO BE CHECKED ON SITE AND AGREED ON SITE WITH APPOINTED BUILDING CONTRACTOR/SHOPFITTER.
 - THIS DRAWING IS TO BE READ IN CONJUNCTION WITH ALL RELEVANT ARCHITECTURAL DRAWINGS AND SPECIFICATIONS AS WELL AS ALL RELEVANT INFORMATION FROM THE STRUCTURAL, MEP AND CIVIL ENGINEERS.
 - THIS DRAWING HAS BEEN PREPARED IN ACCORDANCE WITH THE SCOPE OF APPOINTMENT WITH THE CLIENT AND IS SUBJECT TO THE TERMS OF THAT APPOINTMENT AND SHOULD ONLY BE USED FOR THE PURPOSE FOR WHICH IT IS INTENDED.
 - ALL NEW CONSTRUCTION AND MATERIALS ARE TO CONFORM TO LOCAL BY LAWS, CURRENT BUILDING REGULATIONS AND BRITISH STANDARDS.
 - THIS DRAWING AND ALL OF THE INFORMATION SHOWN IS THE PROPERTY OF @ ARCHITECT (UK) LTD AND SHALL NOT BE COPIED WHOLE OR IN ANY PART, OR USED FOR ANY OTHER PURPOSE WITHOUT WRITTEN PERMISSION OF THE COMPANY.

A	08.94.2025	Signs updated to reflect as built locations and sizes	NS
REV.	DATE	DESCRIPTION	BY

POPEYES

@ ARCHITECT

© Architect (UK) Ltd
Suite 2, Clocktower
House, Station Road
West Horndon, Essex
CM13 3XL

01708 477899
office@architect.ltd.uk
www.architect.ltd.uk

CLIENT
POPEYES

PROJECT
LIVERPOOL DT

UNIT 9, ACADEMY BUSINESS PARK
COUNTY ROAD, KIRKBY
L33 7AN

DRAWING TITLE
PROPOSED
SITE SIGNAGE PLAN

SCALE @ A1
1:200

DRAWN
LW

CHECKED
@

PURPOSE OF ISSUE
PLANNING

STATUS
SO

DRAWING No
23.0233-A-DR-PL-01-200

REV
A