




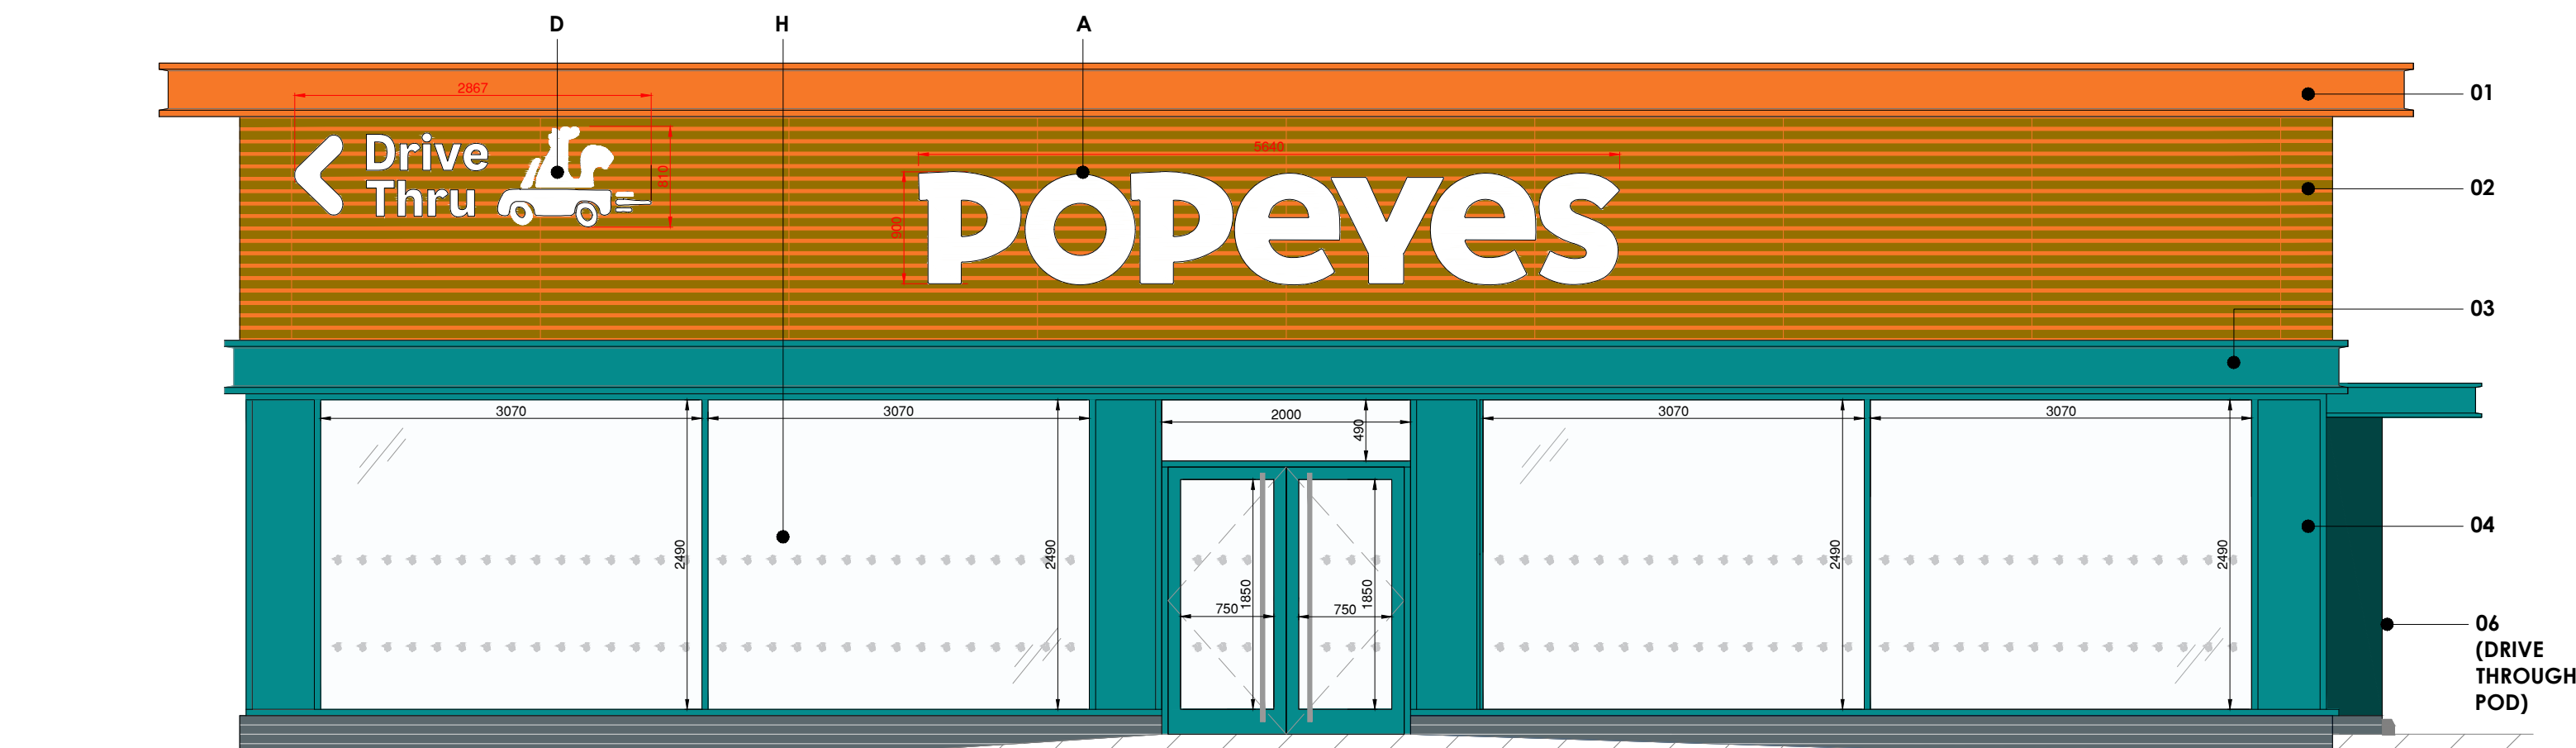

PROPOSED SOUTH ELEVATION

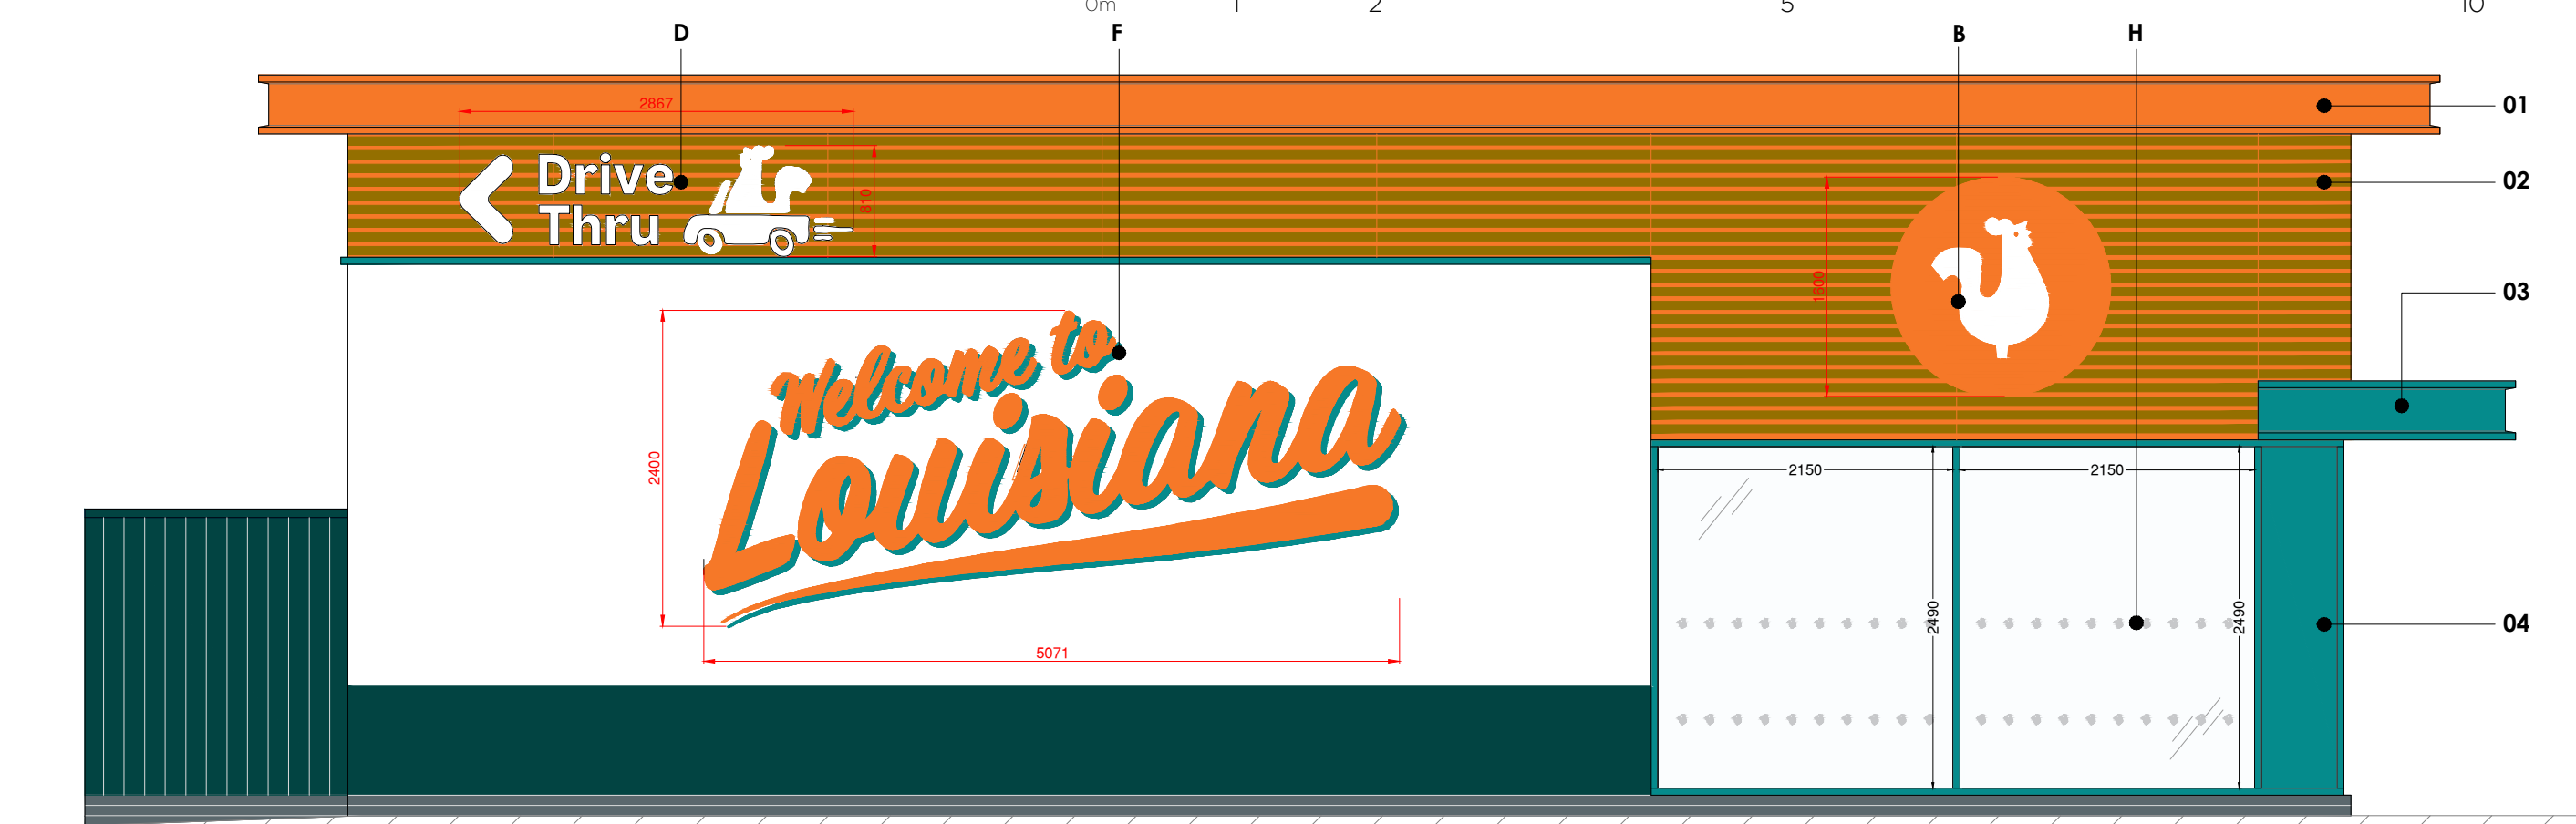


PROPOSED WEST ELEVATION

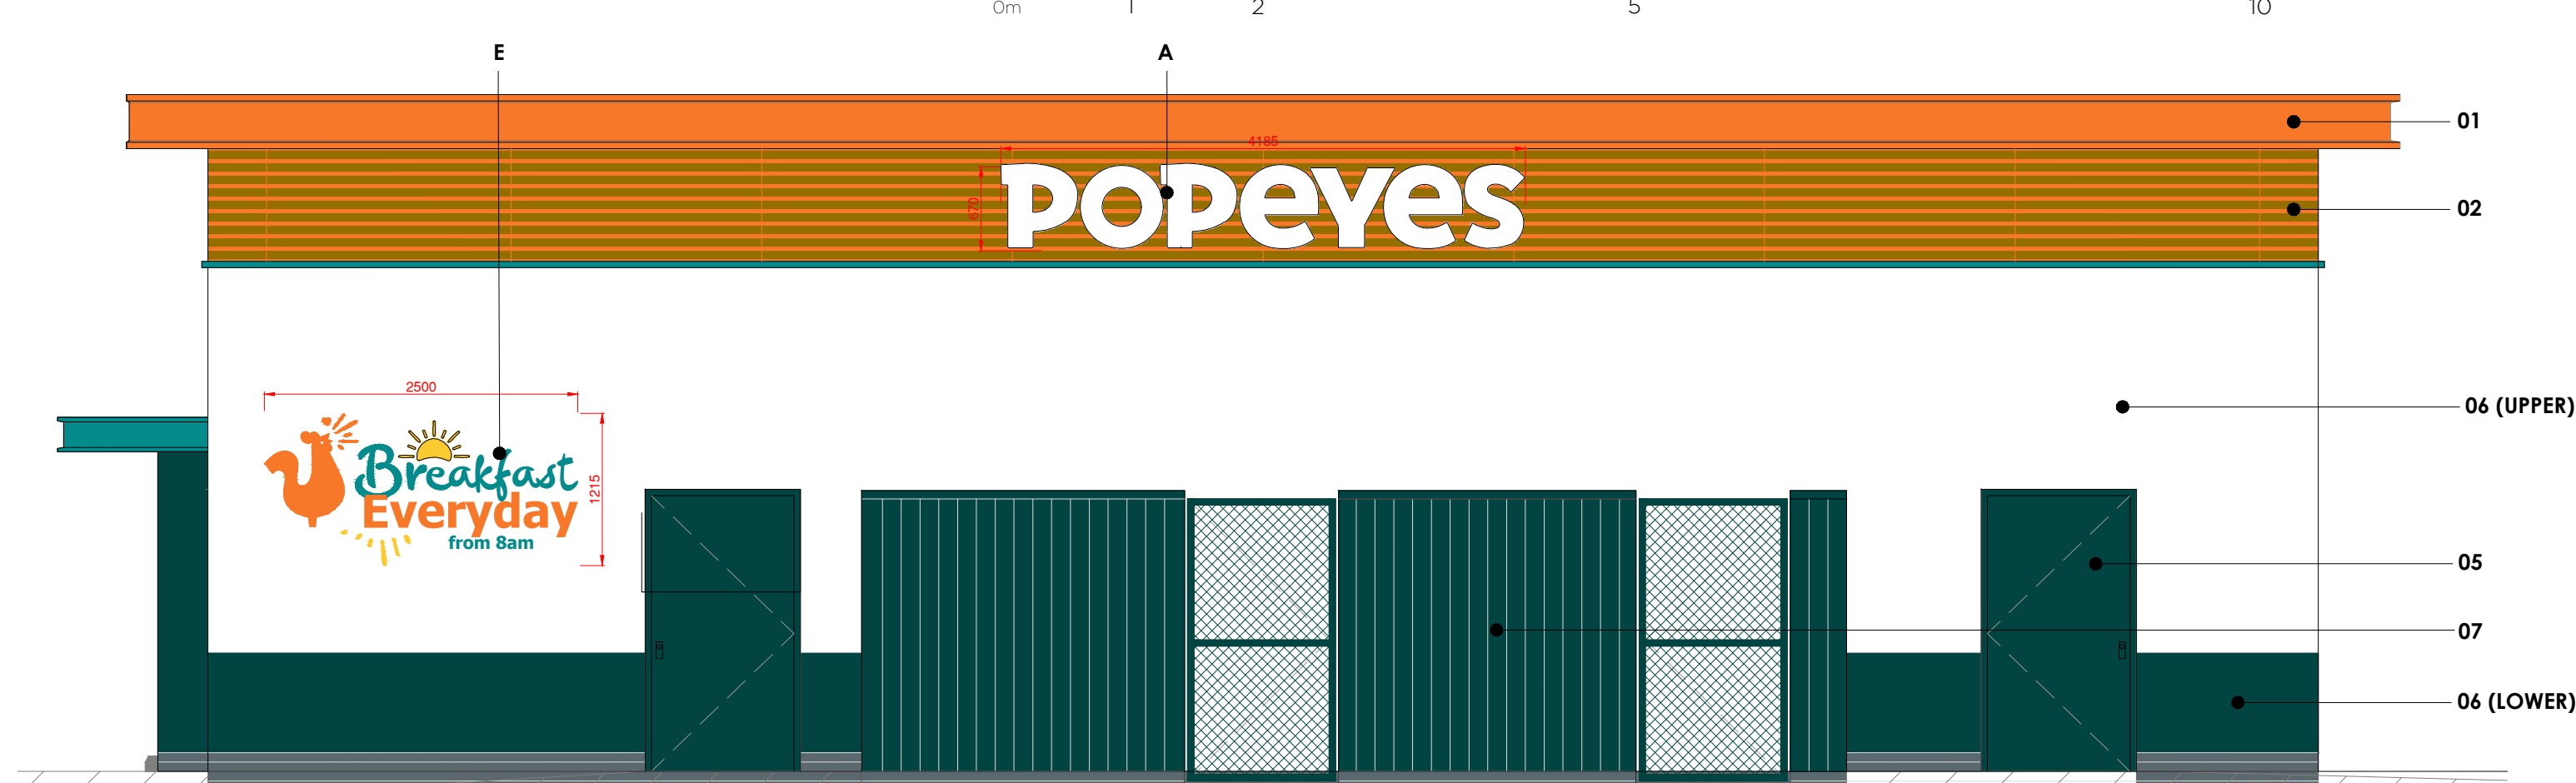


PROPOSED NORTH ELEVATION




PROPOSED EAST ELEVATION

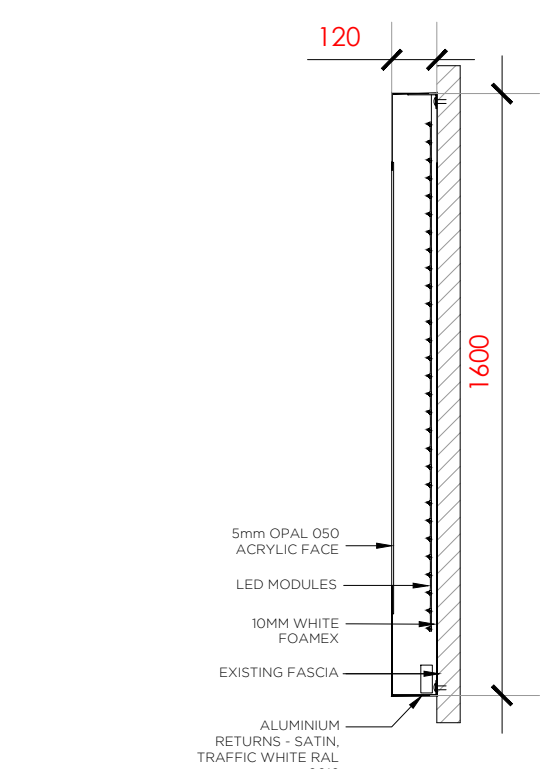


DETAIL 1 TYPICAL BRAND SEAL & NEW FASCIA SIGN SECTION (ITEM B) SCALE 1:20

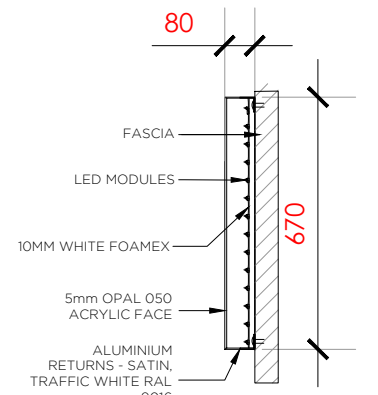

DETAIL 2 TYPICAL LETTERING & NEW FASCIA SIGN SECTION (ITEM A) SCALE 1:20

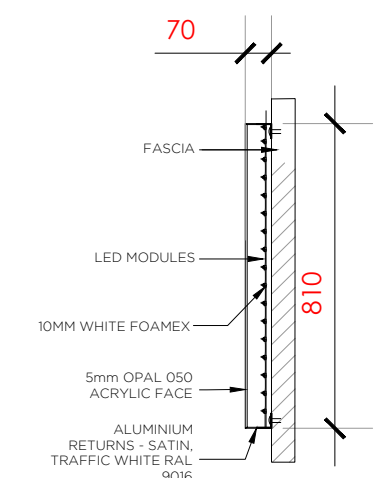

DETAIL 3 TYPICAL DRIVE THROUGH LOGO & NEW FASCIA SIGN SECTION (ITEM D) SCALE 1:20

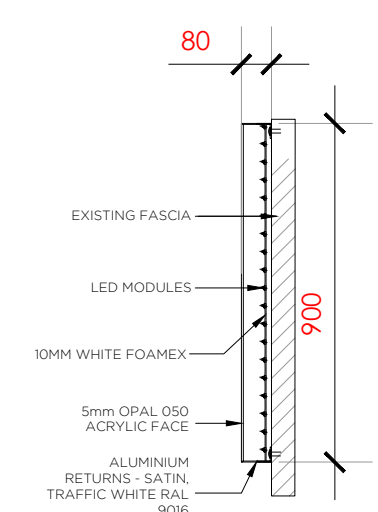


DETAIL 4 TYPICAL LETTERING & NEW FASCIA SIGN SECTION (ITEM A) SCALE 1:20

FACADE MATERIAL SCHEDULE	
ITEM	DESCRIPTION
01	FASCIA BAND POWDER COATED ALUMINIUM Finish Colour: RAL 2003
02	FASCIA PANEL SYSTEM SULCADO CLADDING SYSTEM MOUNTED ON VENTED SUBFRAME FIXED TO SUBSTRATE Finish Colour: RAL 2003
03	CANOPY POWDER COATED ALUMINIUM Finish Colour: RAL 5018
04	SHOPFRONT FRAME / DRIVE THROUGH WINDOW FRAME POWDER COATED ALUMINIUM Finish Colour: RAL 5018
05	STEEL SERVICE DOOR SPRAY PAINTED Finish Colour: RAL 6004
06	UPPER RENDER SPRAYED/ PAINTED Finish Colour: RAL 9016 LOWER RENDER / DRIVE THROUGH POD RENDER SPRAYED/ PAINTED Finish Colour: RAL 6004
07	COMOUND SPRAYED/ PAINTED TIMBER Finish Colour: RAL 6004

FACADE SIGNAGE SCHEDULE		
ITEM	EXAMPLE (NTS)	DESCRIPTION
A		'POPEYES' LOGO Internally illuminated signage - 225 candelae per sqm Size: 4185 x 470 x 80 mm / 5640 x 900 x 80 mm Detail: Finish flex wording logo extruded aluminium sign comp system finished RAL 9016 illumination provided banks of LED. Flex face substrate is to be decorated with face applied 3M self adhesive films. Orange returns Colour: RAL 9016 & RAL 2003
B		'POPEYES' BRAND SEAL Internally illuminated signage - 225 candelae per sqm Size: 1600mm DIA x 120mm Detail: Finish flex logo extruded aluminium sign comp system finished Orange on white background, illumination provided banks of LED. Flex face substrate is to be decorated with face applied 3M self adhesive films. Colour: RAL 9016 / RAL 2003
C	OMITTED	OMITTED
D		'DRIVE THRU' LOGO Internally illuminated signage - 225 candelae per sqm Size: 2867mm x 810mm x 70mm Detail: Finish flex wording logo extruded aluminium sign comp system finished RAL 9016 illumination provided banks of LED. Flex face substrate is to be decorated with face applied 3M self adhesive films. Colour: RAL 9016
E		'BREAKFAST EVERYDAY' VINYL Non-illuminated vinyl signage Size: 2500mm x 1215mm Detail: Vinyl cut Graphic Colour: RAL 2003 & 5018 & 1018
F		'WELCOME TO LOUISIANA' VINYL Non-illuminated vinyl signage Size: 5071mm x 2400mm Detail: Vinyl cut Graphic Colour: RAL 2003 & 5018
G		'Y'ALL READY FOR THIS' VINYL Non-illuminated vinyl signage Size: 2800mm x 695mm Detail: Vinyl cut Graphic Colour: RAL 2003
H		'POPPY MANIFESTION' VINYL Non-illuminated frosted vinyl signage Size: 75mm x 65mm Detail: Vinyl cut Graphic Colour: As Shown
J	OMITTED	OMITTED

SCALE 1:20
0mm 200 400 1000 2000

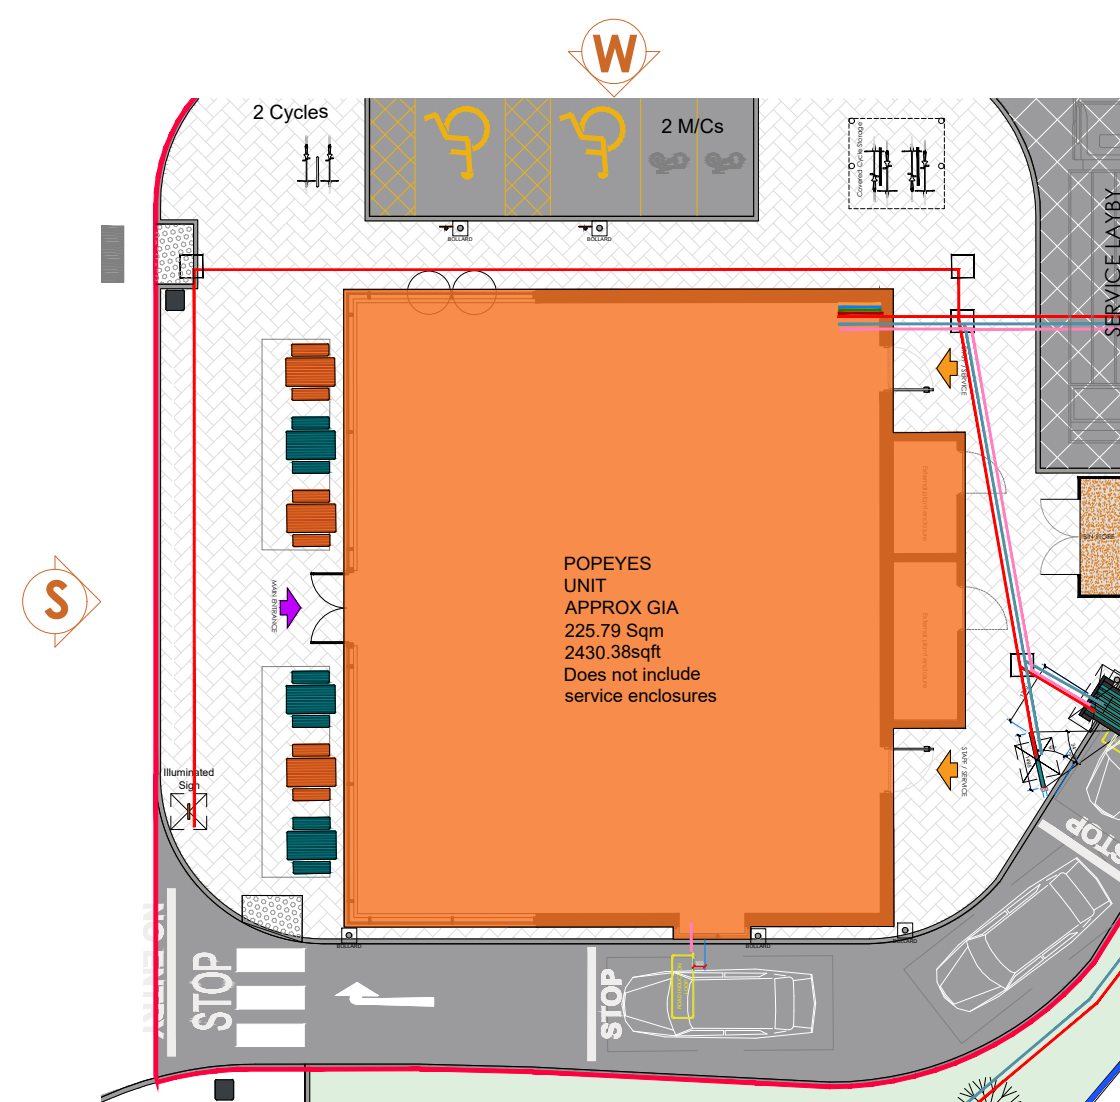

PROPOSED KEY PLAN

SCALE 1:200
0m 2 4 10 20

- NOTES**
1. ALL DIMENSIONS IN MILLIMETRES (mm) AND LEVELS IN METRES (m) ABOVE NATIONAL DATUM. ALL DIMENSIONS TO BE CHECKED ON SITE AND AGREED ON SITE WITH APPOINTED BUILDING CONTRACTOR/SHOPFITTER.
 2. THIS DRAWING IS TO BE READ IN CONJUNCTION WITH ALL RELEVANT ARCHITECTURAL DRAWINGS AND SPECIFICATIONS AS WELL AS ALL RELEVANT INFORMATION FROM THE STRUCTURAL MEP AND CIVIL ENGINEERS.
 3. THIS DRAWING HAS BEEN PREPARED IN ACCORDANCE WITH THE SCOPE OF APPOINTMENT WITH THE CLIENT AND IS SUBJECT TO THE TERMS OF THAT APPOINTMENT AND SHOULD ONLY BE USED FOR THE PURPOSE FOR WHICH IT IS INTENDED.
 4. ALL NEW CONSTRUCTION AND MATERIALS ARE TO CONFORM TO LOCAL BY LAWS, CURRENT BUILDING REGULATIONS AND BRITISH STANDARDS.
 5. THIS DRAWING AND ALL OF THE INFORMATION SHOWN IS THE PROPERTY OF @ ARCHITECT (UK) LTD AND SHALL NOT BE COPIED WHOLE, OR IN ANY PART, OR USED FOR ANY OTHER PURPOSE WITHOUT WRITTEN PERMISSION OF THE COMPANY.

A	08.94.2025	Signs updated to reflect as built locations and sizes	NS
---	------------	---	----

REV.	DATE	DESCRIPTION	BY
------	------	-------------	----

POPEYES

@ ARCHITECT

@ Architect (UK) Ltd
Suite 2, Clocktower
House, Station Road
West Horndon, Essex
CM13 3XL
01708 477899
office@architect.ltd.uk
www.architect.ltd.uk

CLIENT
POPEYES

PROJECT
LIVERPOOL DT

UNIT 9, ACADEMY BUSINESS PARK
COUNTY ROAD, KIRKBY
L33 7AN

DRAWING TITLE
PROPOSED
EXTERNAL ELEVATIONS

SCALE @ A1
1:50 / 1:200

DRAWN
LW

CHECKED
@

PURPOSE OF ISSUE
PLANNING

STATUS
SO

DRAWING No
23.0233-A-DR-PL-20-250

REV
A