



**Knowsley Council**

**REGENERATION AND ECONOMIC DEVELOPMENT  
DEPARTMENT**

**TOWN AND COUNTRY PLANNING ACT 1990**

**PLANNING PERMISSION**

**Application No: 25/00205/FUL**

**Name and address of applicant**

Linden Hill Capital Management  
C/o Agent  
Landmark  
1 Oxford Street  
Manchester  
M1 4PB

**Name and address of agent**

JLL  
Landmark  
1 Oxford Street  
Manchester  
M1 4PB

**Date of Receipt:** 27 March 2025

**Date Valid:** 27 March 2025

**Address/Location Of Development:**

**John Mason International Ltd  
35 Wilson Road  
Huyton  
Knowsley  
L36 6AE**

**Description of Development:**

**VARIATION OF CONDITIONS 3 & 4 ATTACHED TO PLANNING PERMISSION  
24/00427/FUL (VARIATION OF CONDITION 3 ATTACHED TO OUTLINE  
PLANNING PERMISSION 22/00284/OUT) TO ALLOW FOR A SECOND  
VEHICULAR ACCESS POINT TO BE PROVIDED FROM WILSON ROAD.**

The Council of the Metropolitan Borough of Knowsley hereby give notice in pursuance of the above Act(s) that Planning Permission has been **granted** for the carrying out of the development referred to above in accordance with the application and plans submitted subject to the following condition(s):

1. Before any part of the development hereby granted permission is commenced, approval shall be obtained from the Local Planning Authority with respect to the reserved matters, namely (the layout, scale, appearance, and landscaping). The reserved matters applications in respect of appearance and scale shall follow the principles set out in the Design Code document ref 12156-AEW-RP-A-0520 REV P2 received 08/02/23.

Reason: The application is in outline form only.

2. Application for approval of reserved matters must be made not later than the expiration of three years from 23.03.2023 (the date the outline planning permission

was granted) and the development must be begun no later than the expiration of two years from the final approval of the reserved matters or, in the case of approval on different dates, the final approval of the last such matter to be approved.

Reason: In order to comply with the requirements of Section 92 of the Town and Country Planning Act 1990 (as amended).

3. The development hereby permitted shall be carried out in accordance with the approved plans and documents listed in Schedule 1.

Reason: For the avoidance of doubt.

4. The maximum ridge height of any building sited in the area shaded orange on the submitted Parameters Plan Drg No 12156-AEW-XX-XX-DR-A-0503- REV P08 shall be determined in accordance with section AA on the parameters plan.

Reason: For the avoidance of doubt and in the interests of visual amenity in accordance with Policy CS19 of the Knowsley Local Plan Core Strategy, adopted January 2016

5. No part of the development hereby permitted shall be occupied until a scheme for the design and layout of the site access junctions has been submitted to and approved in writing by the Local Planning Authority. The site access junctions shall be implemented in accordance with the approved details and shall be available for use prior to occupation. The site access points shall be kept available for use at all times.

Reason: To ensure the provision of safe and adequate means of access to the development in the interests of highway safety and amenity and to comply with Policy CS19 of the Knowsley Local Plan Core Strategy, adopted January 2016.

6. Within six months of the building coming into occupation a Travel Plan shall be submitted to and approved in writing by the Local Planning Authority. The Plan shall include immediate, continuing and long-term measures to promote and encourage alternative modes of transport to the single-occupancy car. For the avoidance of doubt, the Travel Plan shall include, but not be limited to:

- Involvement of employees.
- Information on existing transport policies, services and facilities, travel behaviours and attitudes.
- Access for all modes of transport.
- Targets for mode share.
- Resource allocation including Travel Plan Co-ordinator and budget.
- A parking and management strategy.
- A marketing and communications strategy.
- Appropriate measures and actions to reduce car dependence and encourage sustainable travel.
- An action plan, including a timetable for the implementation of each of the above.
- Mechanisms for monitoring, reviewing and implementing the Travel Plan.

The approved Travel Plan shall be implemented in accordance with the timetable contained therein and shall continue to be implemented as long as any part of the development is occupied and in use.

An annual report shall be submitted to the Council no later than 1 month following the anniversary of the first occupation of the development for a period of 5 years.

The report shall include a review of the Travel Plan measures, monitoring data and updated action plan.

Reason: To maximise opportunities for travel by modes of transport other than the private car, and to ensure that the development is sustainable and to ensure compliance with saved policy T9 in the Knowsley Replacement Unitary Development Plan, adopted 2006.

7. Any gate or other form of barrier across the access shall be positioned at least 17 metres back from the highway boundary of Wilson Road and shall be constructed to open into the site only.

Reason: To permit vehicles to pull clear of the Highway when entering the site, in the interests of highway and pedestrian safety and to comply with Policy CS19 of the Knowsley Local Plan Core Strategy, adopted January 2016

8. No part of the development hereby permitted shall be occupied until details of the number and location of bat boxes to be incorporated into the scheme have been submitted to and approved in writing by the Local Planning Authority. The bat boxes shall be installed in accordance with the approved details prior to the first occupation of the building and shall be retained at all times thereafter.

Reason: In the interests of biodiversity conservation and to comply with Policy CS8 of the Knowsley Local Plan Core Strategy, adopted January 2016.

9. Prior to the first occupation of the development hereby permitted a scheme for the provision of lighting for the site shall be submitted to, approved in writing by the Local Planning Authority and fully implemented accordingly.

For the avoidance of doubt, the scheme shall include drawings of the lighting and lighting columns, a site layout indicating positions of the lighting, isolux and luminosity details and manufactures specifications.

Reason: In the interests of amenity, security and ecology and to comply with the National Planning Policy Framework; Policies CS2, CS8 and CS19 of the Knowsley Local Plan Core Strategy, adopted January 2016.

10. No part of the development hereby permitted, including any works of demolition, shall be commenced until a Construction Environmental Management Plan that details the means of mitigation of construction effects has been submitted and agreed in writing by the Local Planning Authority. This shall include the following:
  - a. Methods for the mitigation of noise and vibration from building works, including a method statement for any piling works, and also from the operation of any temporary power generation or pumping plant which will operate overnight.
  - b. Methods for dust control and suppression.
  - c. Control of transfer of mud out of the site - details of wheel washing facilities including location and type.
  - d. The areas for the storage of plant and materials.
  - e. A programme of works, including phasing
  - f. Location of site compound, including any loading/unloading areas, turning areas for delivery vehicles and construction staff parking arrangements.
  - g. Scheme for recycling/disposal of waste resulting from demolition and construction works.
  - h. Adequate provision for addressing any abnormal wear and tear to the highway.

- i. Proposed hours of construction (the following is usually acceptable: 0800 to 1800 Monday to Friday, 0800 to 1300 Saturday and not at all on Sundays/Public Holidays).
- j. Pollution prevention measures to prevent impacts to Logwood Mill Brook (in line with paragraph 5.6 of the submitted Ecological Appraisal).
- k. A five-metre buffer zone to be marked out and maintained along Logwood Mill Brook to prevent impacts to water vole.
- l. Reasonable Avoidance Measures for protection of hedgehog, in line with paragraph 5.13 of the submitted Ecological Appraisal.
- m. Measures to prevent invasive species being spread on and off site including a validation report confirming the treatment carried out and that the site has been free of the invasive species for 12 consecutive months.

All site works shall then proceed only in accordance with the approved management plan unless otherwise agreed in writing beforehand with the Local Planning Authority.

Reason: To ensure the satisfactory development of the site and in the interests of protecting the amenity of neighbouring occupiers and to comply with the National Planning Policy Framework; Policies CS2 and CS19 of the Knowsley Local Plan Core Strategy adopted January 2016; Policy WM9 of the Merseyside and Halton Joint Waste Local Plan 2013 and saved Policy ENV2 of the Knowsley Replacement Unitary Development Plan adopted June 2006

11. No development or demolition shall take place until the applicant or their agents, has secured the implementation and submission of a report on a programme of archaeological works. That programme of archaeological works should be undertaken in accordance with a Written Scheme of Investigation (WSI) which has been submitted to and approved in writing by the local planning authority prior to works taking place. The WSI must include:

- A phased programme and methodology of site investigation and recording;
- A programme for post-investigation reporting to include production of a final report of the significance of the below-ground archaeological interest;
- Provision for appropriate publication and dissemination of the archaeology and history of the site;
- Provision for archive deposition of the report, finds and records of the site investigation; and
- Nomination of a competent person or persons / organisation to undertake the works set out within the approved WSI.

Reason: In the interests of archaeological investigation or recording and to comply with Policy CS20 of the Knowsley Local Plan Core Strategy, adopted January 2016, and the National Planning Policy Framework.

12. The reserved matters applications relating to appearance and layout shall include full details of commercial and industrial waste storage and collection arrangements.

Reason: To ensure adequate waste storage and collection arrangements are provided on the site in accordance with Policy WM9 of the Merseyside and Halton Waste Local Plan.

13. The reserved matters applications shall include full details of the low carbon/ carbon neutral energy technologies which are being installed to power the site.

Reason: To ensure the provision of low carbon and renewable energy technologies in compliance with Policy CS22 in the Knowsley Local Plan Core Strategy.

14. The reserved matters applications relating to landscaping shall include a scheme for replacement tree planting. The submitted scheme shall include tree replacement for individual and groups of trees on a 2:1 basis at a minimum of 12-14cm. The scheme should include the location, size and species of the replacement trees.

The tree planting and landscaping shall be wholly implemented in its finally approved form in accordance with the approved scheme within the first available planting season following the substantial completion of development. Any tree or other planting, which is lost, felled, removed, becomes diseased, or is substantially damaged within a period of five years thereafter shall be replaced in kind during the first available planting season following the date of loss or damage.

Reason: In the interests of visual amenity and to ensure the development complies with Saved Policy DQ4 of the Knowsley Replacement Unitary Development Plan adopted June 2006.

15. Prior to the commencement of development hereby submitted an arboricultural method statement shall be submitted to and approved in writing by the Local Planning Authority. The method statement shall include: -

Details of all protective measures required to retain the health and stability of all retained trees and/or hedges on or adjacent the site including fencing, designated washing and mixing areas, designated site cabin areas, access in and out the site, special surfaces and site supervision.

All works identified in the method statement shall be in accordance with British Standard documents No's 3998:2010 and 5837:2012.

Reason: To ensure that the proper protection of trees has been carried out in the interests of visual amenity and to comply with Policies CS2 and CS19 of the Knowsley Local Plan Core Strategy, adopted January 2016 and saved Policy DQ4 of the Knowsley Replacement Unitary Development Plan, adopted June 2006.

16. The development shall be carried out in accordance with the submitted flood risk assessment (Farrow Walsh Consulting/April 2022/ref: FW2197\_FRA\_001 V1) and the following mitigation measures it details:

- As stated in section 7.1.2, the design and placement of the development will be confined to the Flood Zone 1 outline.
- As stated in section 7.1.3, mitigation measures mentioned in this section are to be included within the design of the development.
- As stated in section 7.3.1, finished floor levels shall be set no lower than 300mm above existing site levels.

These mitigation measures shall be fully implemented prior to occupation and subsequently in accordance with the scheme's timing/phasing arrangements. The measures detailed above shall be retained and maintained thereafter throughout the lifetime of the development.

Reason: To reduce the risk of flooding to the proposed development and future occupants and to ensure compliance with Policy CS24 Local Plan Core Strategy adopted June 2016.

17. The development hereby permitted (excluding demolition) shall not be commenced until a scheme for the provision and implementation of a surface water regulation system to manage the risk of flooding from both overland flow and from the sewer

network, has been submitted to and approved in writing by the Local Planning Authority. The agreed scheme shall be implemented prior to the first occupation of the development.

The surface water drainage scheme should be consistent with the Non-Statutory Technical Standards for Sustainable Drainage Systems (March 2015) or any subsequent replacement national standards.

Reason: To prevent increased risk of flooding by ensuring the satisfactory storage of / disposal of surface water from the site and to comply with saved Policies CS2 and CS24 of the Knowsley Local Plan: Core Strategy, adopted January 2016.

18. A Management and Maintenance Plan for the sustainable drainage system relating to the lifetime of the development through an appropriate legally binding agreement shall be submitted to and approved in writing by the Local Planning Authority. This shall include:

- i. The arrangements for adoption by an appropriate public body or statutory undertaker or details of provision for management and maintenance by a management company.
- ii. Arrangements for inspection and ongoing maintenance of all elements of the sustainable drainage system to secure the operation of the surface water drainage scheme throughout its lifetime.
- iii. Details for planned maintenance and a mechanism for remedial and urgent repair works.
- iv. Means of access for inspection and maintenance purposes.
- v. The plan shall be implemented in accordance with the timeframes contained within it.

Reason: To ensure effectiveness of the flood risk measures during the lifetime of the development policies CS2 and CS24 of the Knowsley Local Plan: Core Strategy (adopted 2016)

19. Contaminated Land

#### A. Risk Assessment

No development (excluding demolition works) shall take place until an assessment of the risks posed by any contamination has been submitted to and approved in writing by the Local Planning Authority. This assessment must be undertaken by a suitably qualified contaminated land practitioner, in accordance with authoritative guidance (CLR 11), and shall assess any contamination on the site, whether or not it originates on the site. Moreover, it must include (were relevant):

- i. a survey of the extent, scale and nature of contamination.
- ii. an assessment of the potential risks to:
  - human health,
  - property (existing or proposed) including buildings, crops, livestock, pets, woodland and service lines and pipes,
  - adjoining land,
  - groundwaters and surface waters,
  - ecological systems,
  - archaeological sites and ancient monuments.

## B. Submission of Remediation Scheme

Where land affected by contamination is found which poses unacceptable risks, no development shall take place until a detailed remediation scheme has been submitted to and approved in writing by the Local Planning Authority. The scheme must include an appraisal of remediation options, identification of the preferred option(s), the proposed remediation objectives and remediation criteria, and a description and programme of the works to be undertaken including the verification plan. As a minimum, the scheme must ensure that the site will not qualify as contaminated land under Part 2A of the Environmental Protection Act 1990 in relation to its intended use.

## C. Implementation of Approved Remediation Scheme

The approved remediation scheme shall be implemented, and a verification report submitted to and approved in writing by the Local Planning Authority, prior to the development (or relevant phase of development) being brought into use.

## D. Reporting of Unexpected Contamination

In the event that contamination is found at any time when carrying out the approved development that was not previously identified it must be reported immediately to the Local Planning Authority. Development on the part of the site affected must be halted and a risk assessment carried out and submitted to and approved in writing by the Local Planning Authority. Where unacceptable risks are found remediation and verification schemes shall be submitted to and approved in writing by the Local Planning Authority. These shall be implemented prior to the development (or relevant phase of development) being brought into use.

## E. Importation of Soil/Material

No soil is to be imported to the site until it has been tested for contamination and assessed for its suitability for the proposed development, a suitable methodology for testing this material should be submitted to and agreed by the Local Planning Authority prior to the soils being imported onto site. The methodology should include the sampling frequency, testing schedules, criteria against which the analytical results will be assessed (as determined by the risk assessment) and source material information. The analysis shall then be carried out and evidence submitted to and approved in writing to by the Local Planning Authority.

Reason: In the interests of safety, to prevent pollution of the water environment and to comply with Policy ENV5 of the Knowsley Replacement Unitary Development Plan adopted June 2006.

20. No development shall commence (excluding the demolition of existing structures and site clearance) until.
- a. a scheme of intrusive investigations shall be submitted to and approved in writing by the Local Planning Authority to establish the risks posed to the development by past coal mining activity; and
  - b. any remediation works and/or mitigation measures to address land instability arising from coal mining legacy, as may be necessary, have been implemented on site in full in order to ensure that the site is made safe and stable for the development proposed.

The intrusive site investigations and remedial works shall be carried out in accordance with authoritative UK guidance.

Reason: To ensure satisfactory investigations are undertaken and appropriate mitigation measures are undertaken due to the coal mining legacy of the site in accordance with paragraphs 183 and 184 of the National Planning Policy Framework.

21. Prior to the first occupation of the development hereby permitted a signed statement or declaration prepared by a suitably competent person confirming that the site is, or has been made, safe and stable for the approved development shall be submitted to and approved in writing by the Local Planning Authority. This document shall confirm the methods and findings of the intrusive site investigations and the completion of any remedial works and/or mitigation necessary to address the risks posed by past coal mining activity.

Reason: To ensure the safety and stability of the development in accordance with paragraphs 183 and 184 of the National Planning Policy Framework

22. Prior to the first occupation of the development hereby permitted a scheme shall be submitted to and approved in writing by the Local Planning Authority which specifies the provisions to be made for the control of noise emanating from the site. The scheme shall be based on the results of a noise assessment which suitably characterises the noise climate at nearby residential dwellings both prior to and following the first operation of the development permitted.

All works which form part of the scheme shall be implemented in full in accordance with the scheme as agreed. Documentary evidence of the works shall be submitted to and approved in writing by the Local Planning Authority prior to first use of the development.

Reason: To safeguard local residents from noise and disturbance, and to comply with Saved Policy ENV2 of the Knowsley Replacement Unitary Development Plan adopted June 2006.

23. Prior to the installation of any external plant or machinery full scheme details, including the acoustic specification should be submitted to and approved in writing by the local planning authority. The information should also include the results of a noise assessment to confirm that any fixed plant or machinery associated with the development achieves a level that is at least 5dB(A) below the existing LA90 background noise level as measured during the relevant time period. Any tonal, impulsive and/or irregular noise would be addressed by imposing a penalty as per the methodology set out in BS 4142:2014+A1:2019, Methods for Rating and Assessing Industrial and Commercial Sound. Noise limits for fixed plant are to apply at the boundary of the closest dwellings in Holland Grove, Rudgate Road and Logwood Road.

Reason: To safeguard local residents from noise and disturbance, and to comply with Saved Policy ENV2 of the Knowsley Replacement Unitary Development Plan adopted June 2006.

## **SCHEDULE 1**

| <b>Date Received</b> | <b>Ref. No</b>                 | <b>Version</b> | <b>Drawing/Document Title</b> |
|----------------------|--------------------------------|----------------|-------------------------------|
| <b>09/05/2022</b>    | <b>12156-AEW-XXXXDR-A-0502</b> | <b>-</b>       | <b>SITE LOCATION PLAN</b>     |
| <b>09/05/2022</b>    | <b>12156-AEW-XXXXDR-A-0007</b> | <b>-</b>       | <b>DEMOLITION PLAN</b>        |

|            |                                     |        |                                 |
|------------|-------------------------------------|--------|---------------------------------|
| 09/05/2022 | 12156-AEW-XXXXSK-A-0001             | -      | TREE FELLING PLAN               |
| 08/02/2023 | 12156-AEW-RPA0520                   | -      | DESIGN CODE                     |
| 09/05/2022 | 12156-AEW-XXXXSK-A-0003             | -      | TREE CONSTRAINTS PLAN           |
| 22/11/2022 | 22036-MA-XXXXRP-D-TN03              | -      | TECHNICAL NOTE TRIP GENERATION  |
| 09/05/2022 | TA01 REV C                          | -      | TRANSPORT ASSESSMENT            |
| 09/05/2022 | FW2197_FRA_0                        | -      | FLOOD RISK ASSESSMENT           |
| 09/05/2022 | MARCH 2022                          | -      | TREE CONSTRAINTS REPORT         |
| 23/05/2022 | VERSION 2                           | -      | ARBORICULTURE IMPACT DOCUMENT   |
| 15/04/2025 | 12156-AEW-XX-XX-DR-A-0518<br>REV P4 | -      | ACCESS PLAN SHOWING TREES       |
| 27/03/2025 | P812156-AEW-XX-XX-DR-A-0503         | REV P8 | Parameters Plan                 |
| 27/03/2025 | 12156-AEW-XX-XX-DR-A-0518           | REV P3 | ACCESS PLAN                     |
| 27/03/2025 | TN01                                | -      | Transport Assessment Addendum   |
| 27/03/2025 | 25132-MA-XX-XX-SK-C-0001            | REV 02 | SWEPT PATH ANALYSIS SITE ACCESS |

### **REASON(S) FOR THE GRANTING OF PLANNING PERMISSION**

The decision to grant planning permission has also been taken having regard to the policies and proposals as set out below, and to all relevant material considerations including supplementary planning guidance:-

### **SAVED POLICIES - KNOWSLEY REPLACEMENT UNITARY DEVELOPMENT PLAN (ADOPTED JUNE 2006)**

EC3 - Primarily Industrial Areas  
 ENV2 - Noise and Vibration  
 ENV5 - Contaminated Land  
 DQ4 - Trees and Development  
 T5 - Location of Major Traffic Generating New Development  
 T8 - Transport Assessments  
 T9 - Travel Plans

### **KNOWSLEY LOCAL PLAN: CORE STRATEGY**

CS2 - Development Principles  
 CS4 - Economy and Employment  
 CS7 - Transport Networks  
 CS19 - Design Quality and Accessibility in New Development  
 CS20 - Managing the Borough's Historic Environment  
 CS22 - Sustainable and Low Carbon Development  
 CS24 - Managing Flood Risk  
 CS27 - Planning and Paying for New Infrastructure  
 National Planning Policy Framework

This informative is only intended as a summary of the reason(s) for the granting of planning permission. Should you require any further details relating to the decision please contact the relevant case officer (Mark Quinn on 0151 443 2223)

## **ARTICLE 35 STATEMENT**

The Local Planning Authority has acted positively and proactively in determining this application by assessing the proposal against all material considerations, including planning policies and any representations that may have been received and subsequently determining to grant planning permission in accordance with the presumption in favour of sustainable development, as set out within the National Planning Policy Framework.

### **NOTE FOR APPLICANT:**

**IMPORTANT - PLEASE READ CAREFULLY THE NOTES BELOW AS FAILURE TO COMPLY COULD MAKE THE DEVELOPMENT HEREBY PERMITTED UNAUTHORISED**

- 1) This planning permission is granted in strict accordance with the approved plans. It should be noted however that:
  - a) Any variation from the approved plans following commencement of the development, irrespective of the degree of variation, will constitute unauthorised development and may be liable to enforcement action.
  - b) You or your agent or any other person responsible for implementing this permission should inform Planning Services immediately of any proposed variation from the approved plans and ask to be advised as to the best method to resolve the matter. Most proposals for variation to the approved plans will require the submission of a new planning application.
- 2) This permission is granted subject to conditions and it is the owner of the property and the person responsible for the implementation of the development who will be fully responsible for their compliance throughout the development and beyond.
- 3) If there is a condition that requires work to be carried out or details to be approved prior to the commencement of the development this is called a "condition precedent". The following should be noted with regards to conditions precedent.
  - a) If a condition precedent is not complied with prior to the start of development, the whole of the development will be unauthorised and you may be liable to enforcement action.
  - b) In addition, if the requirements of a condition precedent are subsequently not complied with, the development is unauthorised and the only way to rectify the development is the submission of a new application.

If any other type of condition is breached, then you will be liable to a breach of condition notice.

### **Informatives**

1. The proposed development lies within an area that has been defined by the Mining Remediation Authority as containing coal mining features at surface or shallow depth. These features may include mine entries (shafts and adits); shallow coal workings; geological features (fissures and break lines); mine gas and former surface mining sites. Although such features are seldom readily visible, they can often be present and problems can occur, particularly as a result of new development taking place.

Any form of development over or within the influencing distance of a mine entry can be dangerous and raises significant land stability and public safety risks. As a general precautionary principle, the Mining Remediation Authority considers that the building over or within the influencing distance of a mine entry should be avoided. In exceptional circumstance where this is unavoidable, expert advice must be sought to ensure a suitable engineering design which takes account of all relevant safety and environmental risk factors, including mine gas and mine-water. Your attention is drawn to the Mining Remediation Authority Policy in relation to new development and mine entries available at:  
Building on or within the influencing distance of mine entries - GOV.UK

Any intrusive activities which disturb or enter any coal seams, coal mine workings or coal mine entries (shafts and adits) requires a Mining Remediation Authority Permit. Such activities could include site investigation boreholes, excavations for foundations, piling activities, other ground works and any subsequent treatment of coal mine workings and coal mine entries for ground stability purposes. Application forms for Mining Remediation Authority permission and further guidance can be obtained from The Mining Remediation Authority's website at: [www.gov.uk/get-a-permit-to-deal-with-a-coal-mine-on-your-property](http://www.gov.uk/get-a-permit-to-deal-with-a-coal-mine-on-your-property)

What is a permit and how to get one? - GOV.UK ([www.gov.uk](http://www.gov.uk))

In areas where shallow coal seams are present caution should be taken when carrying out any on site burning or heat focused activities.

If any future development has the potential to encounter coal seams which require excavating, for example excavation of building foundations, service trenches, development platforms, earthworks, non-coal mineral operations, an Incidental Coal Agreement will be required. Further information regarding Incidental Coal Agreements can be found here - [https:// www.gov.uk/government/publications/incidental-coal-agreement/guidance-notes-for-applicants-for-incidental-coal-agreements](https://www.gov.uk/government/publications/incidental-coal-agreement/guidance-notes-for-applicants-for-incidental-coal-agreements)

If any coal mining features are unexpectedly encountered during development, this should be reported immediately to the Mining Remediation Authority on 0800 288 4242. Further information is available on the Mining Remediation Authority website at: Mining Remediation Authority - GOV.UK

Informative Note valid from 1st January 2025 until 31st December 2026

2. It is an offence to carry out any works within the public highway without the permission of the Highway Authority. The grant of planning permission will require the developer to enter into an agreement under s278 of the Highways Act 1980 with the Council. The applicant is advised to contact the Site Development Team at [SiteDevelopment@knowsley.gov.uk](mailto:SiteDevelopment@knowsley.gov.uk) to discuss the matter further.
3. Breeding birds are protected under the general provision of Section 1 of the Wildlife and Countryside Act 1981 as amended. Whilst the nest is being built or is in use, the eggs, young and nest are protected against intentional and reckless taking, damage and destruction. No tree, scrub or hedgerow felling, management and/or cutting operations should take place during the period 1 March to 31 August inclusive to protect breeding birds.
4. In relation to condition 10 the following details are required in relation to the invasive species.
  - Toolbox talk so that contractors are aware of the locations of the Japanese knotweed and how to correctly identify the plant (see Appendix F of Ecological Appraisal);
  - Marking off all stands of the plant with hi-visibility fencing, including a buffer zone of 7 metres;
  - Access to infected areas should be avoided until the plant has been successfully eradicated from the area in line with best practice; and
  - Biosecurity measures to be implemented whilst on site to prevent cross contamination. This involves the cleaning of footwear and machinery, prior to, and on completion of each working window to ensure that Japanese knotweed is not taken off site.

A validation report is then required confirming the remediation treatment carried out and that the site has been free of the invasive species for 12 consecutive months for approval in writing by the Local Planning Authority.

5. Environmental permit - advice to applicant  
The site location is within 8 metres of Logwood Mill Brook which is designated a statutory main river. The Environmental Permitting (England and Wales) Regulations 2016 require a permit or exemption to be obtained for any activities which will take place:
  - on or within 8 metres of a main river (16 metres if tidal)
  - on or within 8 metres of a flood defence structure or culverted main river (16

- metres if tidal)
  - on or within 16 metres of a sea defence
  - involving quarrying or excavation within 16 metres of any main river, flood
  - defence (including a remote defence) or culvert in a floodplain more than 8 metres from the river bank, culvert or flood defence structure (16 metres if it's a tidal main river) and you don't already have planning permission For further guidance please visit <https://www.gov.uk/guidance/flood-riskactivitiesenvironmental-permits> or contact our National Customer Contact Centre on 03708 506 506 (Monday to Friday, 8am to 6pm) or by emailing [enquiries@environmentagency.gov.uk](mailto:enquiries@environmentagency.gov.uk).
6. Please see attached consultation response from Cadent GAS & Merseyside Fire Authority (from 22/00284/OUT)
7. Pursuant to condition No 17 the submitted drainage scheme shall include the following:
- i. Evidence and justification will be required to demonstrate that in selecting drainage features for post-development situation the surface water drainage discharge hierarchy taking into account the site geological and topographical characteristics has been followed. As requested by National Planning Practice Guidance applications should aim to discharge surface water runoff as high up the following hierarchy of drainage options as reasonably practicable:
    - into the ground (infiltration)
    - to a surface water body
    - to a surface water sewer, highway drain, or another drainage system, and
    - to a combined sewer.

To assess the feasibility of infiltration techniques, evidence must be provided to show that a suitable number of soakaway tests have been completed across the whole site within different geology and to a suitable depth (i.e. a similar depth to the proposed infiltration devices). The tests should be completed according to the BRE 365 method and their results should be submitted with the full application.

(ii) A SuDS aims to minimise the impacts from a proposed development on water quantity and quality and maximise amenity and biodiversity. In designing an appropriate set of SuDS techniques for a development site, the LLFA will therefore be expecting above ground, green SuDS to be prioritised to promote water quality, amenity and biodiversity. In the outline planning application, no above ground and green SuDS have been considered.

(iii) The existing drainage system on the site has not been surveyed and it is not clear whether or not it will/can be used for post development situation. As part of the survey, the existing connection points to public sewer system(s) or outfall(s) to the Logwood Mill Brook should be determined.

(iv) Should the surface water from the proposal is to connect to the public sewer system or the Logwood Mill Brook, provision of evidence that the site has an agreed discharge point and rate for post-development situation from responsible authorities (United Utilities and Environment Agency respectively) will be required.

(v) At a number of points the site is crossed by public sewers, the developer is advised that they will need to consult United Utilities and obtain agreement for building over, easement width, or diversion of the public sewer.

(vi) The proposed greenfield Qbar runoff rate from the post development site is acceptable. Where the post development maximum discharge rate is set to the greenfield Qbar, the attenuation storage must be estimated using the 1 in 100 6 h duration plus 40% CC event. Depending on the infiltration feasibility on the site and taking the 1 in 100 6 h duration plus 40% CC event for the estimation of attenuation storage, the type, size and placement of attenuation storage adopted may alter.

(vii) Drainage system network proposals should be designed to cope with events up to

the 1 in 100 plus 40% CC events. We note that the 1 in 30 event has been considered in designing the surface water drainage network, should this event magnitude is considered for the final design, the proposed system should be simulated using the 1 in 100 plus 40% CC event and results should be able to demonstrate that at what points surcharges and floodings occur, what would be the volume of flood water, where the flood water flows and/or pools, and what is maximum flood water depth and velocity during such an event. It should be demonstrated that the flood water during the 1 in 100 plus 40% CC event will be retained within the site boundary, and not affect the buildings, and the site will be operational at such a time.

viii) Water quality should be taken into account as part of the proposed drainage design. It will be required to demonstrate that adequate water quality of the off-site surface water flows (draining into a sewer, watercourse and ground) in accordance with the Simplified Index Approach as set out within Section 26 of the SUDS Manual (C753) can be achieved. In this case that an industrial yard is proposed, water quality risk to surface water bodies and groundwater should be assessed (screening risk or detailed risk assessment) and mitigation measures to be adopted to ensure that risk to both surface water bodies, and groundwater are effectively managed (see Table 26.1 of the SUDS Manual).

(ix) In Section 5.6.2 of the FRA report, it has stated "Leicestershire". To be amended.

(x) In Sections 5.6.6 and 5.6.7 of the FRA report, features of catchpits, filter drains, Type C permeable paving, treatment trenches and cellular crates have been mentioned. If they are retained in the final design at the full planning application, their full construction details will be required.

(xi) Exceedance routes of surface water should be provided for the post development situation. It is recommended that based on the exceedance routes and flow depth produced, finished floor levels for proposed building, access roads and car parking to be set. A 1 in 200 years plus 40% event would normally be considered as the Exceedance event and expected that where manholes are surcharged to be identified, and volume and maximum depth of flood water and where the flood water pools or flows to be determined.

(xii) An evaluation of impact of potential failure of the drainage system should be provided. The risk assessment should include for blockage of pipes, blockage of outlet structures and risk of impediments across planned flood routing paths. The drainage design should be supported by a designer's risk assessment that identifies key points of failure of the system and what means have been considered to limit risk of failure. This will also inform the maintenance plan with regards to corrective actions needed should a failure occurs.

(xiii) An updated Model Information (Micro Drainage or similar approved) considering above points will be required. Results showing all the modelling criteria and summary network results including attenuation mechanism for 1 in 2 years, 1 in 30 years and 1 in 100 years plus 40% CC storm events at critical durations along with maximum water level, flow and velocity and details of any surface flooding anticipated will be required.

(xiv) Detailed Drainage Scheme Plan will be required showing the layout of the proposed drainage network, post development impermeable area, post development catchment areas to each SUD feature, SUDs features adopted for interception of first 5mm of rainfall, the location of the storage within the proposed development, connection points and how these relate to the submitted calculations, including any chamber, pipe numbers, direction of flow, invert and cover levels, gradients diameters and dimensions.

(xv) Summary Drainage Report setting out the Drainage Strategy and results of the calculations demonstrating compliance with the above.

(xvi) A timetable for implementation of the drainage works including an assessment of any phasing of the development if applies.

8. Pursuant to condition 10 the method statement for any piling works shall include the following: -
- a. Details of the method of piling
  - b. Days / hours of work
  - c. Duration of the pile driving operations (expected start date and completion date)
  - d. Vibration monitoring details, including the number of monitors and the monitoring location(s).

A handwritten signature in black ink, appearing to read 'D. L. Smith'.

**Executive Director - Regeneration and Economic Development**

**Date: 5 June 2025**

### **IMPORTANT NOTES FOR YOUR ATTENTION:**

1. This permission refers only to that required under the Town and Country Planning Acts and does not include any consent or approval under any other enactment, bylaw, order or regulation.
2. This permission refers only to those plans submitted as part of the Planning Application a copy of which is retained by the Local Planning Authority. The Local Planning Authority should be contacted in writing if it is proposed to amend these plans in any way as a further permission, may be required.
3. You should ensure that you understand the requirements of all planning conditions and that you fully comply with their requirements. If you are in any doubt about what a condition requires of you, please ask us for assistance. Planning conditions may require you to submit further information to us and await our approval before you can start your development. A failure to do so could result in your development being unlawful and necessitate the submission of a further planning application. A failure to comply with the conditions of the permission/consent may result in the taking of enforcement and potentially legal action, against you to remedy the breach of planning control.
4. A fee is normally payable to discharge planning conditions in accordance with government regulations.
5. This permission does not convey any rights or approval to build on, or develop, any land that is not fully owned or controlled by you, including on party boundaries. You should satisfy yourself that the agreement of any adjoining landowners has been given prior to commencing any building works.
6. If a Building Regulations Consent is required for these works it is your responsibility to ensure that the plans submitted for both the Building Regulations Consent and Planning Permission are the same in all respects. Should the plans relating to one consent vary from the other, it will be necessary for you to submit amended plans to this Department and obtain the relevant approval(s) prior to commencing any works. Knowsley Council's Building Control team are contactable on (0151)-443 2342 and they would be pleased to assist you.

### **Appeals to the Secretary of State**

- If you are aggrieved by the decision of your local planning authority to refuse permission for the proposed development or to grant it subject to conditions, then you can appeal to the Secretary of State under section 78 of the Town and Country Planning Act 1990.
- If you want to appeal against your local planning authority's decision then you must do so within 6 months of the date of this notice.
- Appeals can be made online at: <https://www.gov.uk/planning-inspectorate>.  
If you are unable to access the online appeal form, please contact the Planning Inspectorate to obtain a paper copy of the appeal form on tel: 0303 444 5000.
- The Secretary of State can allow a longer period for giving notice of an appeal but will not normally be prepared to use this power unless there are special circumstances which excuse the delay in giving notice of appeal.
- The Secretary of State need not consider an appeal if it seems to the Secretary of State that the local planning authority could not have granted planning permission for the proposed development or could not have granted it without the conditions they imposed, having regard to the statutory requirements, to the provisions of any development order and to any directions given under a development order.

Date: 13/09/2022  
LinesearchbeforeUdig ref: 26909179  
Your ref: 22/00284/OUT (CB)

Dear Sir/Madam,

**Your planning application – No objection, informative note required**

We have received a notification from the LinesearchbeforeUdig (LSBUD) platform regarding a planning application that has been submitted which is in close proximity to our medium and low pressure assets. We have no objection to this proposal from a planning perspective, however we need you to take the following action.

**What you need to do**

To prevent damage to our assets or interference with our rights, please add the following **Informative Note** into the **Decision Notice**:

*Cadent Gas Ltd own and operate the gas infrastructure within the area of your development. There may be a legal interest (easements and other rights) in the land that restrict activity in proximity to Cadent assets in private land. The applicant must ensure that the proposed works do not infringe on legal rights of access and or restrictive covenants that exist.*

*If buildings or structures are proposed directly above the apparatus the development may only take place following diversion of the apparatus. The applicant should apply online to have apparatus diverted in advance of any works, by visiting [cadentgas.com/diversions](https://cadentgas.com/diversions)*

*Prior to carrying out works, including the construction of access points, please register on [www.linesearchbeforeudig.co.uk](https://www.linesearchbeforeudig.co.uk) to submit details of the planned works for review, ensuring requirements are adhered to.*

**Your responsibilities and obligations**

Cadent may have a Deed of Easement on the pipeline, which provides us with a right of access for a number of functions and prevents change to existing ground levels, storage of materials. It also prevents the erection of permanent/temporary buildings, or structures. If necessary Cadent will take action to legally enforce the terms of the easement.

This letter does not constitute any formal agreement or consent for any proposed development work either generally or related to Cadent's easements or other rights, or any planning or building regulations applications.

Cadent Gas Ltd or their agents, servants or contractors do not accept any liability for any losses arising under or in connection with this information. This limit on liability applies to all and any claims in contract, tort (including negligence), misrepresentation (excluding fraudulent misrepresentation), breach of statutory duty or otherwise. This limit on liability does not exclude or restrict liability where prohibited by the law nor does it supersede the express terms of any related agreements.

If you need any further information or have any questions about the outcome, please contact us at [plantprotection@cadentgas.com](mailto:plantprotection@cadentgas.com) or on 0800 688 588 quoting your reference at the top of this letter.


**Kind Regards,**

Plant Protection Team


T: 0800 688 588

[plantprotection@cadentgas.com](mailto:plantprotection@cadentgas.com)

[cadentgas.com](https://cadentgas.com)

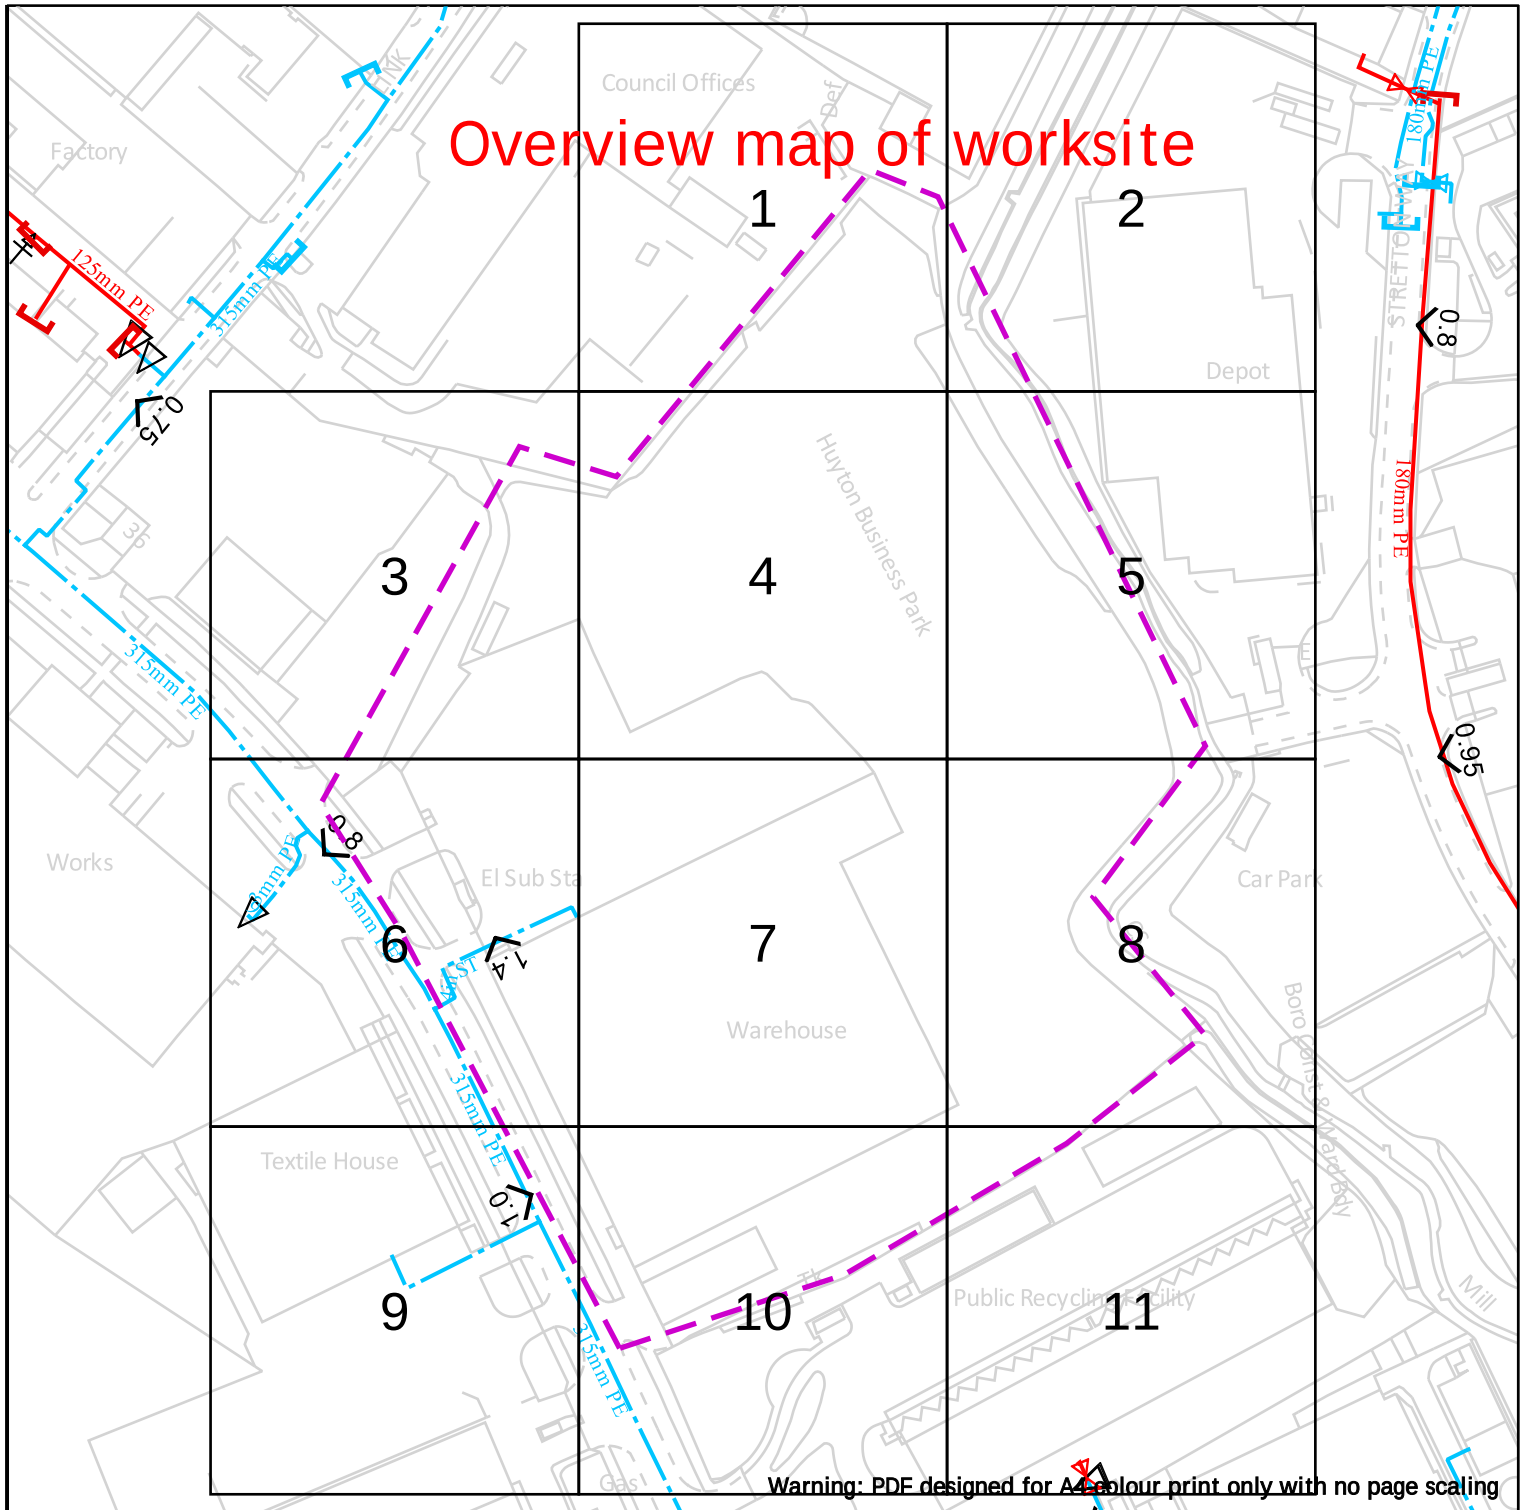

|   |   |
|---|---|
|  <p><b>Cadent</b><br/>Your Gas Network</p>   | <div> <div>Dig Sites</div> <div> <div>Area: <span style="color: magenta;">----</span></div> <div>Line: <span style="color: magenta;">----</span></div> </div> <div> <div><span style="color: red;">----</span> LP Mains</div> <div><span style="color: blue;">----</span> MP Mains</div> <div><span style="color: green;">----</span> IP Mains</div> <div><span style="color: orange;">----</span> LHP Mains</div> </div> <div> <div><span style="color: black;">X</span> Valve</div> <div><span style="color: black;">V</span> Depth of cover</div> <div><span style="color: black;">O</span> Syphon</div> </div> <div> <div><span style="color: black;">T</span> Diameter Change</div> <div><span style="color: black;"> </span> Material Change</div> <div><span style="color: red;">!</span> Out of Standard Service</div> </div> </div>   |
| <p>Date Requested: 13/09/2022<br/>Job Reference: 26909179<br/>Site Location: 345749 389975<br/>Requested by: Ms Carly Bower</p> <p>Your Scheme/Reference:<br/>22/00284/OUT (CB)</p> <p>View extent: 100m, 100m</p> <p>Scale: 1:2050 (When plotted at A4)</p> | <p><b>IMPORTANT NOTICES</b></p> <p>This plan shows these pipes owned by Cadent Gas Limited in its role as a Licensed Gas Transporter (GT). Gas pipes owned by other GT's or otherwise privately owned may be present in this area. Information with regards to such pipes should be obtained from the relevant owners. The information shown on this plan is given without warranty, the accuracy thereof cannot be guaranteed. Service pipes, valves, syphons, stub connections etc. are not shown but their presence should be anticipated. No liability of any kind whatsoever is accepted by Cadent Gas Limited or their agents, servants or contractors for any errors or omission. Safe digging practices, in accordance with HS(G)47, must be used to verify and establish the actual position of mains, pipes, services and other apparatus on site before any mechanical plant is used. It is your responsibility to ensure that this information is provided to all persons (either direct labour or contractors) working for you on or near gas apparatus. The information included on this plan should not be referred to beyond a period of 28 days from the date of issue.</p> <p style="text-align: center; color: red; font-weight: bold;">In case of emergency call - 0800 111 999</p> <p style="font-size: small;">Crown Copyright © - This plan is reproduced from or based on the OS map by Cadent Gas Limited, with the sanction of the controller of HM Stationary Office. Crown Copyright Reserved. Ordnance Survey Licence number 100024886</p> |

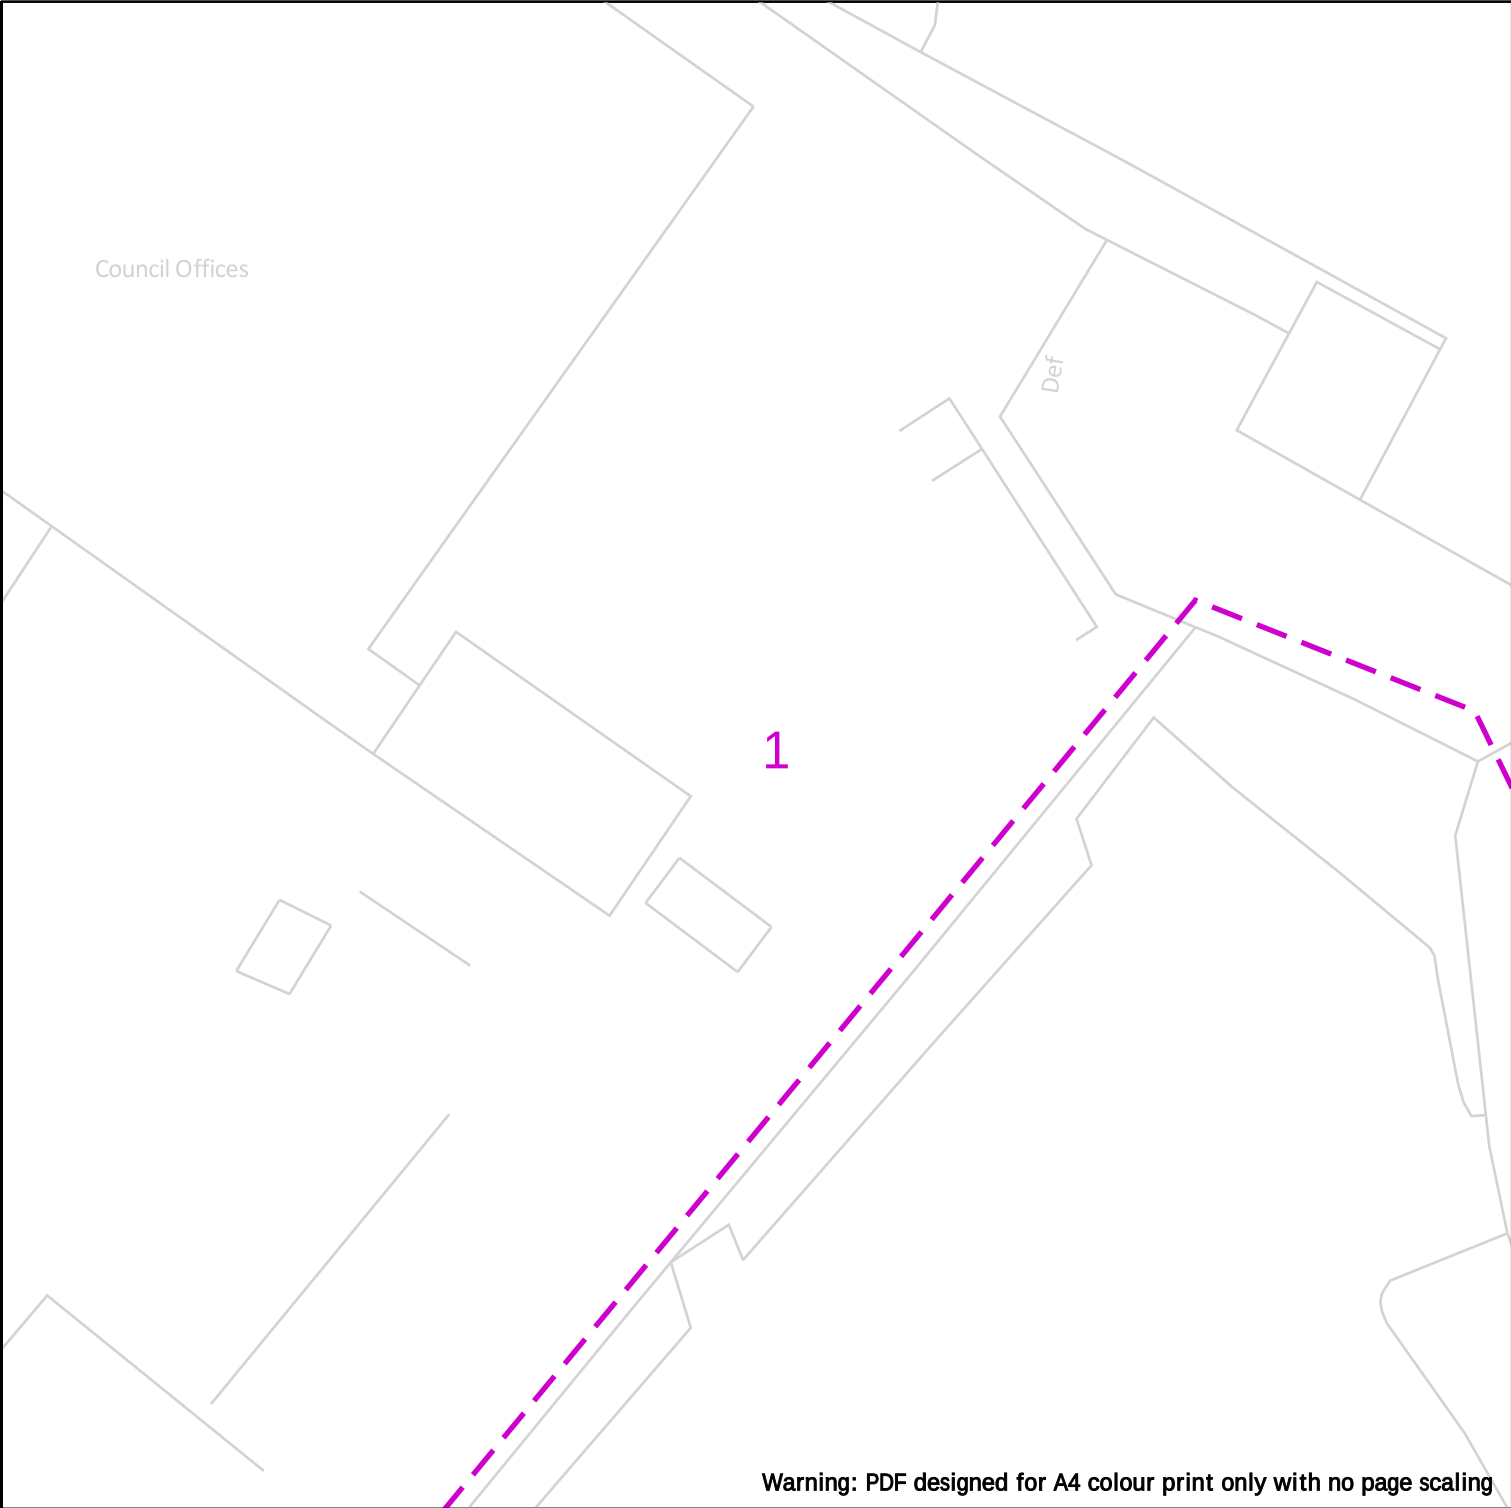

Warning: PDF designed for A4 colour print only with no page scaling



**Cadent**  
Your Gas Network

**Dig Sites**

|  |           |
|--|-----------|
|  | LP Mains  |
|  | MP Mains  |
|  | IP Mains  |
|  | LHP Mains |

**Area:**

**Line:**

|  |                |
|--|----------------|
|  | Valve          |
|  | Depth of cover |
|  | Syphon         |

|  |                         |
|--|-------------------------|
|  | Diameter Change         |
|  | Material Change         |
|  | Out of Standard Service |

Date Requested: 13/09/2022  
Job Reference: 26909179  
Site Location: 345749 389975  
Requested by: Ms Carly Bower

Your Scheme/Reference:  
22/00284/OUT (CB)

View extent: 100m, 100m


**IMPORTANT NOTICES**

This plan shows these pipes owned by Cadent Gas Limited in its role as a Licensed Gas Transporter (GT). Gas pipes owned by other GT's or otherwise privately owned may be present in this area. Information with regards to such pipes should be obtained from the relevant owners. The information shown on this plan is given without warranty, the accuracy thereof cannot be guaranteed. Service pipes, valves, syphons, stub connections etc. are not shown but their presence should be anticipated. No liability of any kind whatsoever is accepted by Cadent Gas Limited or their agents, servants or contractors for any errors or omission. Safe digging practices, in accordance with HS(G)47, must be used to verify and establish the actual position of mains, pipes, services and other apparatus on site before any mechanical plant is used. It is your responsibility to ensure that this information is provided to all persons (either direct labour or contractors) working for you on or near gas apparatus. The information included on this plan should not be referred to beyond a period of 28 days from the date of issue.


**In case of emergency call - 0800 111 999**

Scale: 1:500 (When plotted at A4)

Crown Copyright © - This plan is reproduced from or based on the OS map by Cadent Gas Limited, with the sanction of the controller of HM Stationary Office. Crown Copyright Reserved. Ordnance Survey Licence number 100024886

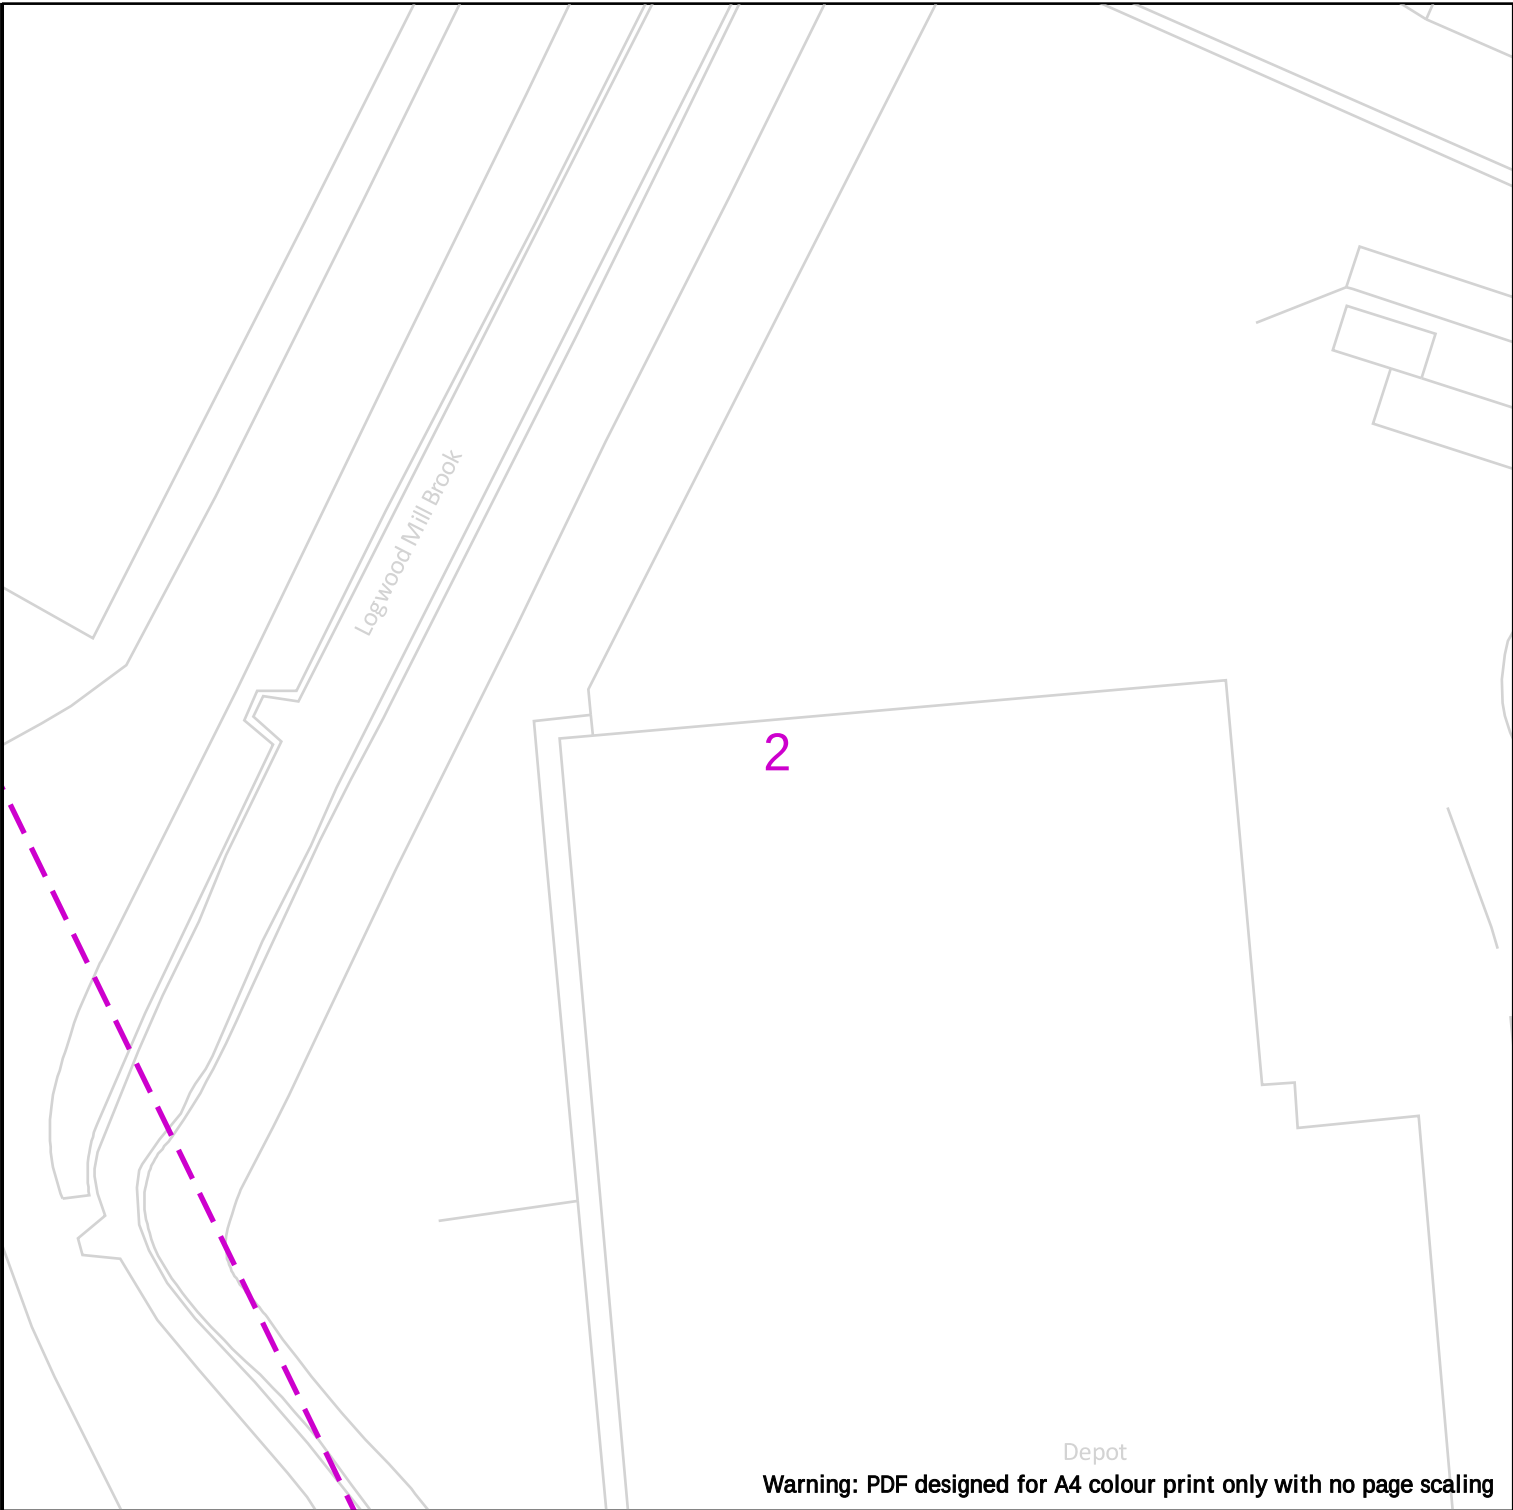




|   | <table border="0"> <tr> <td><b>Dig Sites</b></td> <td><b>Area:</b> </td> <td><b>Line:</b> </td> </tr> <tr> <td></td> <td>LP Mains</td> <td> Valve</td> </tr> <tr> <td></td> <td>MP Mains</td> <td> Depth of cover</td> </tr> <tr> <td></td> <td>IP Mains</td> <td> Syphon</td> </tr> <tr> <td></td> <td>LHP Mains</td> <td> Diameter Change</td> </tr> <tr> <td></td> <td></td> <td> Material Change</td> </tr> <tr> <td></td> <td></td> <td> Out of Standard Service</td> </tr> </table> | <b>Dig Sites</b>                                                                                              | <b>Area:</b>  | <b>Line:</b>  |  | LP Mains |  Valve |  | MP Mains |  Depth of cover |  | IP Mains |  Syphon |  | LHP Mains |  Diameter Change |  |  |  Material Change |  |  |  Out of Standard Service |
| <b>Dig Sites</b>   | <b>Area:</b>   | <b>Line:</b>               |                                                                                                  |                                                                                                  
|   | LP Mains   |  Valve                   |                                                                                                  |                                                                                                  
|   | MP Mains   |  Depth of cover          |                                                                                                  |                                                                                                  
|   | IP Mains   |  Syphon                  |                                                                                                  |                                                                                                  
|   | LHP Mains   |  Diameter Change         |                                                                                                  |                                                                                                  
|   |   |  Material Change         |                                                                                                  |                                                                                                  
|   |   |  Out of Standard Service |                                                                                                  |                                                                                                  
| <p>Date Requested: 13/09/2022<br/>         Job Reference: 26909179<br/>         Site Location: 345749 389975<br/>         Requested by: Ms Carly Bower</p> <p>Your Scheme/Reference:<br/>         22/00284/OUT (CB)</p> <p>View extent: 100m, 100m</p> | <p><b>IMPORTANT NOTICES</b></p> <p>This plan shows these pipes owned by Cadent Gas Limited in its role as a Licensed Gas Transporter (GT). Gas pipes owned by other GT's or otherwise privately owned may be present in this area. Information with regards to such pipes should be obtained from the relevant owners. The information shown on this plan is given without warranty, the accuracy thereof cannot be guaranteed. Service pipes, valves, syphons, stub connections etc. are not shown but their presence should be anticipated. No liability of any kind whatsoever is accepted by Cadent Gas Limited or their agents, servants or contractors for any errors or omission. Safe digging practices, in accordance with HS(G)47, must be used to verify and establish the actual position of mains, pipes, services and other apparatus on site before any mechanical plant is used. It is your responsibility to ensure that this information is provided to all persons (either direct labour or contractors) working for you on or near gas apparatus. The information included on this plan should not be referred to beyond a period of 28 days from the date of issue.</p> <p style="text-align: center;"><b>In case of emergency call - 0800 111 999</b></p> <p><small>Crown Copyright © - This plan is reproduced from or based on the OS map by Cadent Gas Limited, with the sanction of the controller of HM Stationary Office. Crown Copyright Reserved. Ordnance Survey Licence number 100024886</small></p>      |   |                                                                                                  

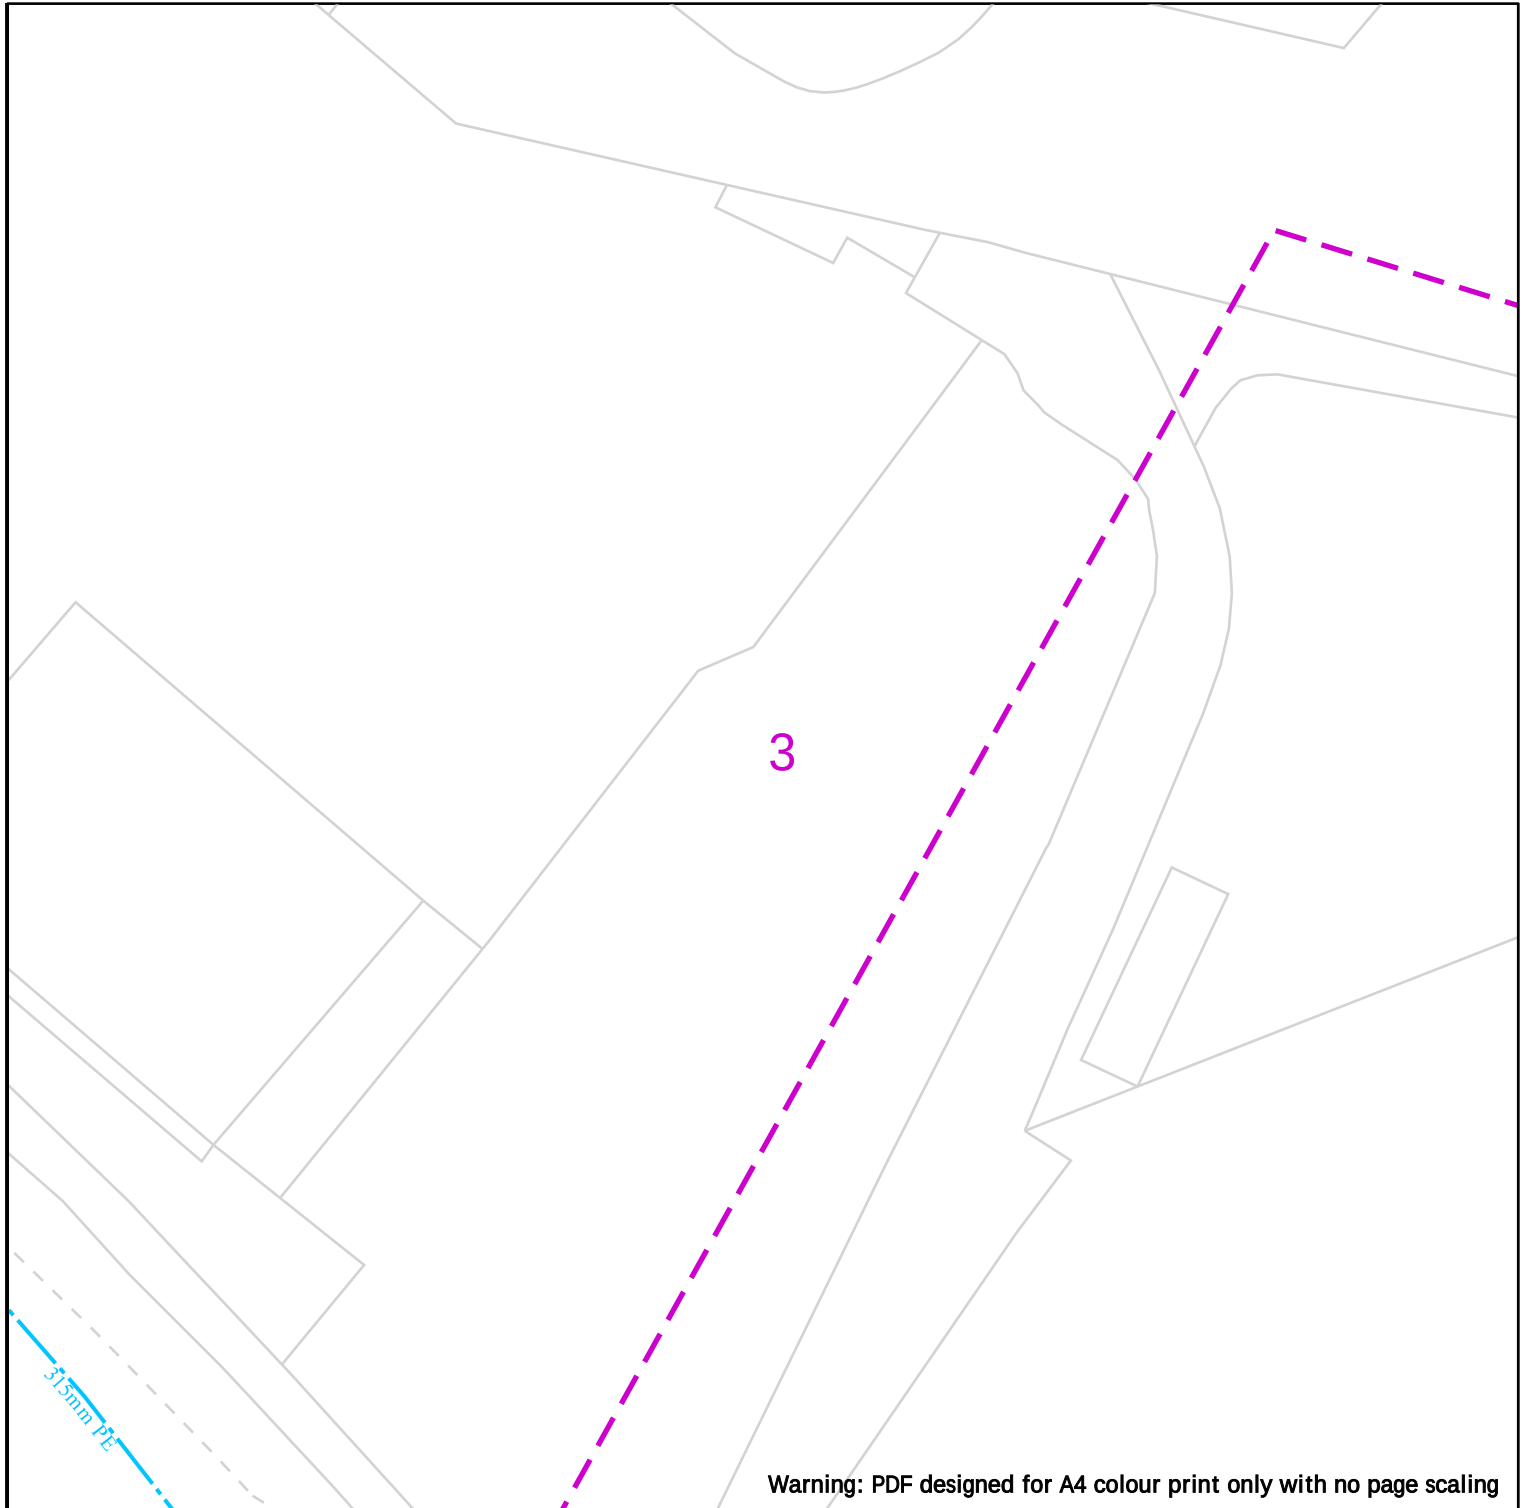

Warning: PDF designed for A4 colour print only with no page scaling

 25m

Dig Sites

Area: 

Line: 

**Cadent**  
Your Gas Network



LP Mains



MP Mains



IP Mains



LHP Mains



Valve



Depth of cover



Syphon



Diameter Change



Material Change



Out of Standard Service

Date Requested: 13/09/2022  
Job Reference: 26909179  
Site Location: 345749 389975  
Requested by: Ms Carly Bower

Your Scheme/Reference:  
22/00284/OUT (CB)

View extent: 100m, 100m

#### IMPORTANT NOTICES

This plan shows these pipes owned by Cadent Gas Limited in its role as a Licensed Gas Transporter (GT). Gas pipes owned by other GT's or otherwise privately owned may be present in this area. Information with regards to such pipes should be obtained from the relevant owners. The information shown on this plan is given without warranty, the accuracy thereof cannot be guaranteed. Service pipes, valves, syphons, stub connections etc. are not shown but their presence should be anticipated. No liability of any kind whatsoever is accepted by Cadent Gas Limited or their agents, servants or contractors for any errors or omission. Safe digging practices, in accordance with HS(G)47, must be used to verify and establish the actual position of mains, pipes, services and other apparatus on site before any mechanical plant is used. It is your responsibility to ensure that this information is provided to all persons (either direct labour or contractors) working for you on or near gas apparatus. The information included on this plan should not be referred to beyond a period of 28 days from the date of issue.

**In case of emergency call - 0800 111 999**

Crown Copyright © - This plan is reproduced from or based on the OS map by Cadent Gas Limited, with the sanction of the controller of HM Stationary Office. Crown Copyright Reserved. Ordnance Survey Licence number 100024886

Scale: 1:500 (When plotted at A4)

Huyton Business Park

4

Warning: PDF designed for A4 colour print only with no page scaling

 25m

Dig Sites

Area:



Line:



**Cadent**  
Your Gas Network



LP Mains



MP Mains



IP Mains



LHP Mains



Valve



Depth of cover



Syphon



Diameter Change



Material Change



Out of Standard Service

Date Requested: 13/09/2022  
Job Reference: 26909179  
Site Location: 345749 389975  
Requested by: Ms Carly Bower

Your Scheme/Reference:  
22/00284/OUT (CB)

View extent: 100m, 100m

#### IMPORTANT NOTICES

This plan shows these pipes owned by Cadent Gas Limited in its role as a Licensed Gas Transporter (GT). Gas pipes owned by other GT's or otherwise privately owned may be present in this area. Information with regards to such pipes should be obtained from the relevant owners. The information shown on this plan is given without warranty, the accuracy thereof cannot be guaranteed. Service pipes, valves, syphons, stub connections etc. are not shown but their presence should be anticipated. No liability of any kind whatsoever is accepted by Cadent Gas Limited or their agents, servants or contractors for any errors or omission. Safe digging practices, in accordance with HS(G)47, must be used to verify and establish the actual position of mains, pipes, services and other apparatus on site before any mechanical plant is used. It is your responsibility to ensure that this information is provided to all persons (either direct labour or contractors) working for you on or near gas apparatus. The information included on this plan should not be referred to beyond a period of 28 days from the date of issue.

**In case of emergency call - 0800 111 999**

Scale: 1:500 (When plotted at A4)

Crown Copyright © - This plan is reproduced from or based on the OS map by Cadent Gas Limited, with the sanction of the controller of HM Stationary Office. Crown Copyright Reserved. Ordnance Survey Licence number 100024886



Warning: PDF designed for A4 colour print only with no page scaling



Dig Sites

Area: 

Line: 



-  LP Mains
-  MP Mains
-  IP Mains
-  LHP Mains



Valve



Depth of cover



Syphon



Diameter Change



Material Change



Out of Standard Service

Date Requested: 13/09/2022  
Job Reference: 26909179  
Site Location: 345749 389975  
Requested by: Ms Carly Bower

Your Scheme/Reference:  
22/00284/OUT (CB)


View extent: 100m, 100m

IMPORTANT NOTICES

This plan shows these pipes owned by Cadent Gas Limited in its role as a Licensed Gas Transporter (GT). Gas pipes owned by other GT's or otherwise privately owned may be present in this area. Information with regards to such pipes should be obtained from the relevant owners. The information shown on this plan is given without warranty, the accuracy thereof cannot be guaranteed. Service pipes, valves, syphons, stub connections etc. are not shown but their presence should be anticipated. No liability of any kind whatsoever is accepted by Cadent Gas Limited or their agents, servants or contractors for any errors or omission. Safe digging practices, in accordance with HS(G)47, must be used to verify and establish the actual position of mains, pipes, services and other apparatus on site before any mechanical plant is used. It is your responsibility to ensure that this information is provided to all persons (either direct labour or contractors) working for you on or near gas apparatus. The information included on this plan should not be referred to beyond a period of 28 days from the date of issue.

**In case of emergency call - 0800 111 999**

Scale: 1:500 (When plotted at A4)

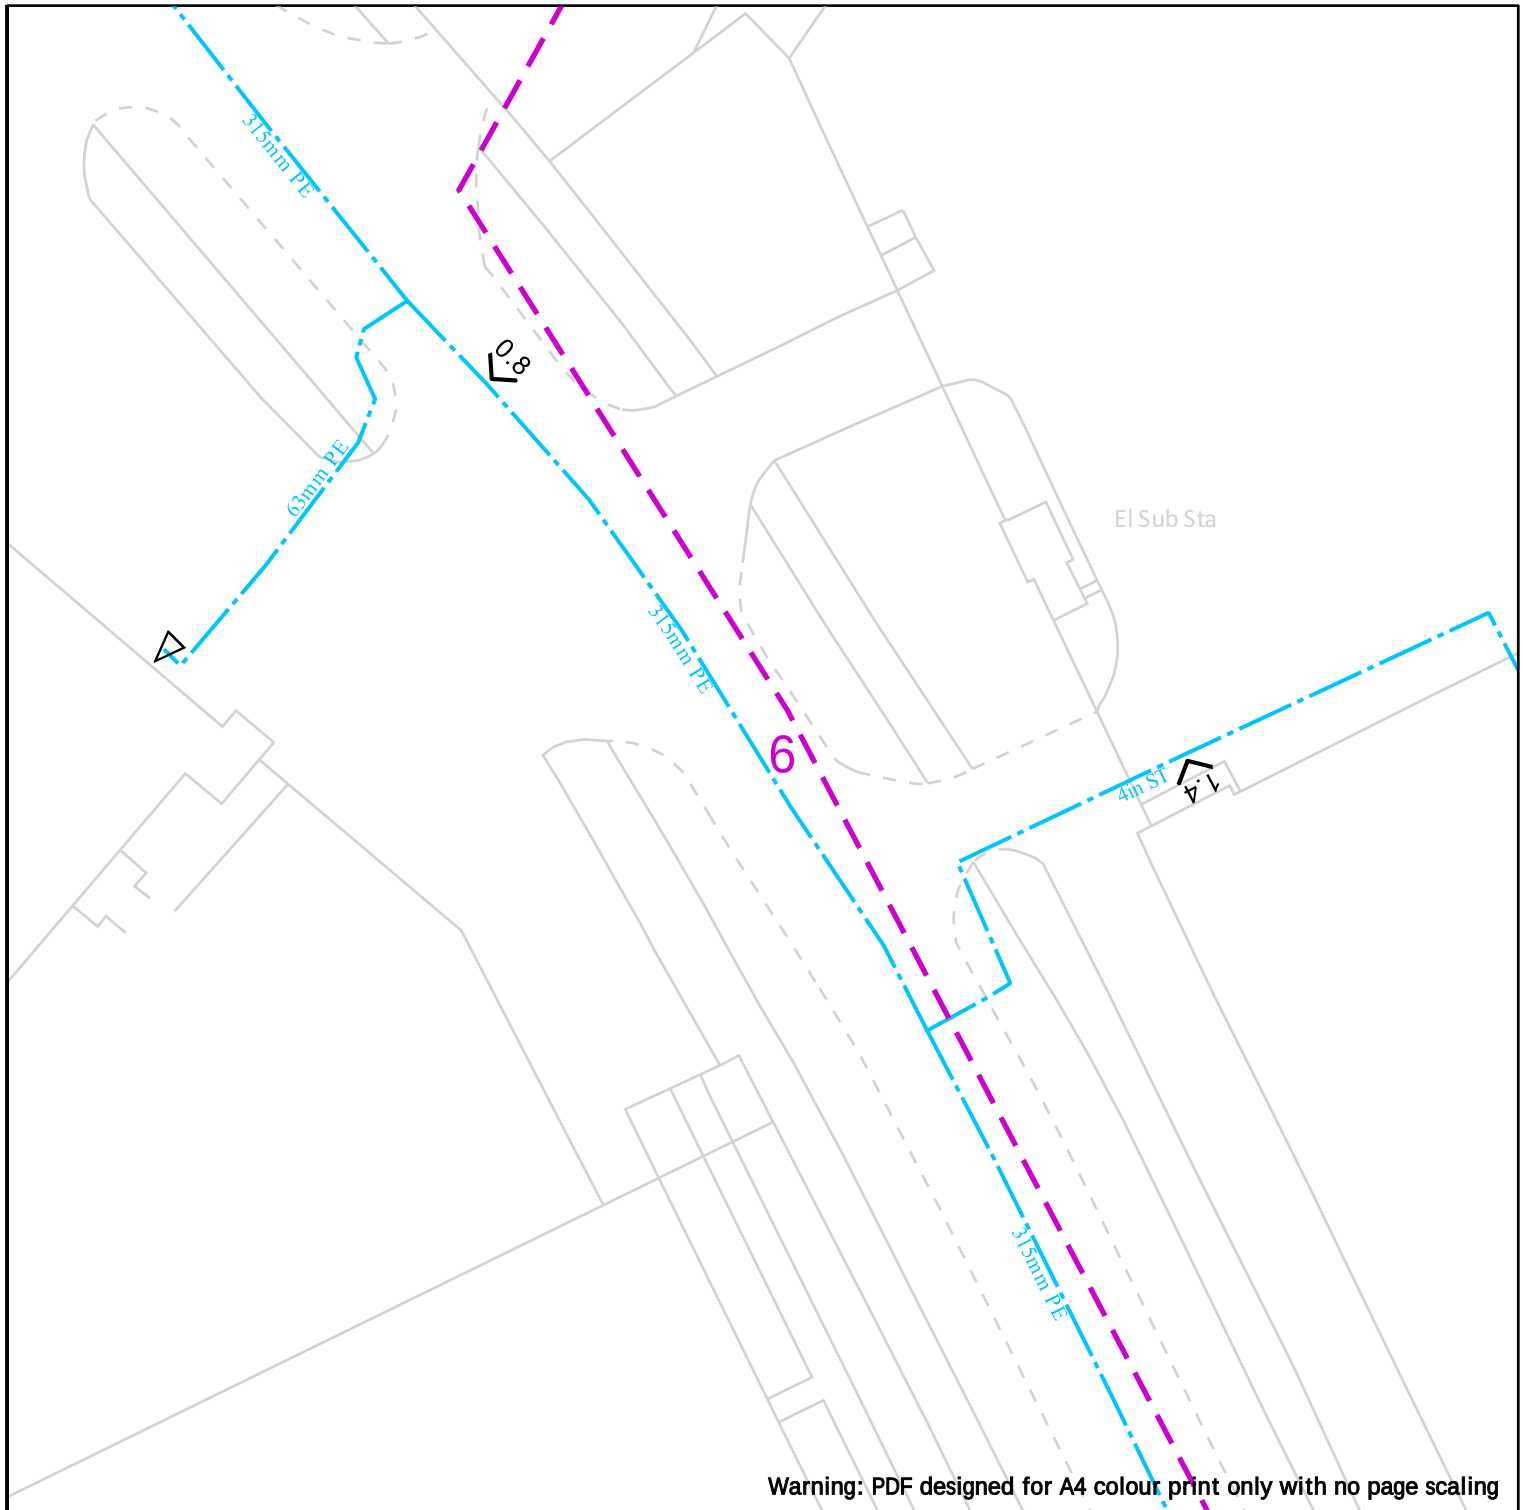

|   |   |
|---|---|
|   | <div><div></div><div>25m</div></div>   |
| <div><div>Cadent</div><div>Your Gas Network</div></div>   | <div><div><div>Dig Sites</div><div><div><div></div></div><div><div></div></div><div><div></div></div><div><div></div></div></div><div><div>LP Mains</div><div>MP Mains</div><div>IP Mains</div><div>LHP Mains</div></div></div><div><div>Area: <div><div></div><div></div><div></div><div></div></div></div><div>Line: <div><div></div><div></div><div></div><div></div></div></div></div><div><div><div><div></div></div><div>Valve</div></div><div><div><div></div></div><div>Depth of cover</div></div><div><div><div></div></div><div>Syphon</div></div></div><div><div><div><div></div></div><div>Diameter Change</div></div><div><div><div></div></div><div>Material Change</div></div><div><div><div></div></div><div>Out of Standard Service</div></div></div></div>   |
| <div><div>Date Requested: 13/09/2022</div><div>Job Reference: 26909179</div><div>Site Location: 345749 389975</div><div>Requested by: Ms Carly Bower</div><div><div>Your Scheme/Reference: 22/00284/OUT (CB)</div></div><div><div>View extent: 100m, 100m</div></div></div> | <div><div>IMPORTANT NOTICES</div><div><div>This plan shows these pipes owned by Cadent Gas Limited in its role as a Licensed Gas Transporter (GT). Gas pipes owned by other GT's or otherwise privately owned may be present in this area. Information with regards to such pipes should be obtained from the relevant owners. The information shown on this plan is given without warranty, the accuracy thereof cannot be guaranteed. Service pipes, valves, syphons, stub connections etc. are not shown but their presence should be anticipated. No liability of any kind whatsoever is accepted by Cadent Gas Limited or their agents, servants or contractors for any errors or omission. Safe digging practices, in accordance with HS(G)47, must be used to verify and establish the actual position of mains, pipes, services and other apparatus on site before any mechanical plant is used. It is your responsibility to ensure that this information is provided to all persons (either direct labour or contractors) working for you on or near gas apparatus. The information included on this plan should not be referred to beyond a period of 28 days from the date of issue.</div></div></div> |
|   | <div><div>In case of emergency call - 0800 111 999</div></div>   |
| <div><div>Scale: 1:500 (When plotted at A4)</div></div>   | <div><div>Crown Copyright © - This plan is reproduced from or based on the OS map by Cadent Gas Limited, with the sanction of the controller of HM Stationary Office. Crown Copyright Reserved. Ordnance Survey Licence number 100024886</div></div>   |

7

Warehouse

Warning: PDF designed for A4 colour print only with no page scaling



**Cadent**  
Your Gas Network

Dig Sites

Area:



Line:



LP Mains



MP Mains



IP Mains



LHP Mains



Valve



Depth of cover



Syphon



Diameter Change



Material Change



Out of Standard Service

Date Requested: 13/09/2022  
Job Reference: 26909179  
Site Location: 345749 389975  
Requested by: Ms Carly Bower

Your Scheme/Reference:  
22/00284/OUT (CB)

View extent: 100m, 100m


#### IMPORTANT NOTICES

This plan shows these pipes owned by Cadent Gas Limited in its role as a Licensed Gas Transporter (GT). Gas pipes owned by other GT's or otherwise privately owned may be present in this area. Information with regards to such pipes should be obtained from the relevant owners. The information shown on this plan is given without warranty, the accuracy thereof cannot be guaranteed. Service pipes, valves, syphons, stub connections etc. are not shown but their presence should be anticipated. No liability of any kind whatsoever is accepted by Cadent Gas Limited or their agents, servants or contractors for any errors or omission. Safe digging practices, in accordance with HS(G)47, must be used to verify and establish the actual position of mains, pipes, services and other apparatus on site before any mechanical plant is used. It is your responsibility to ensure that this information is provided to all persons (either direct labour or contractors) working for you on or near gas apparatus. The information included on this plan should not be referred to beyond a period of 28 days from the date of issue.

**In case of emergency call - 0800 111 999**

Scale: 1:500 (When plotted at A4)

Crown Copyright © - This plan is reproduced from or based on the OS map by Cadent Gas Limited, with the sanction of the controller of HM Stationary Office. Crown Copyright Reserved. Ordnance Survey Licence number 100024886

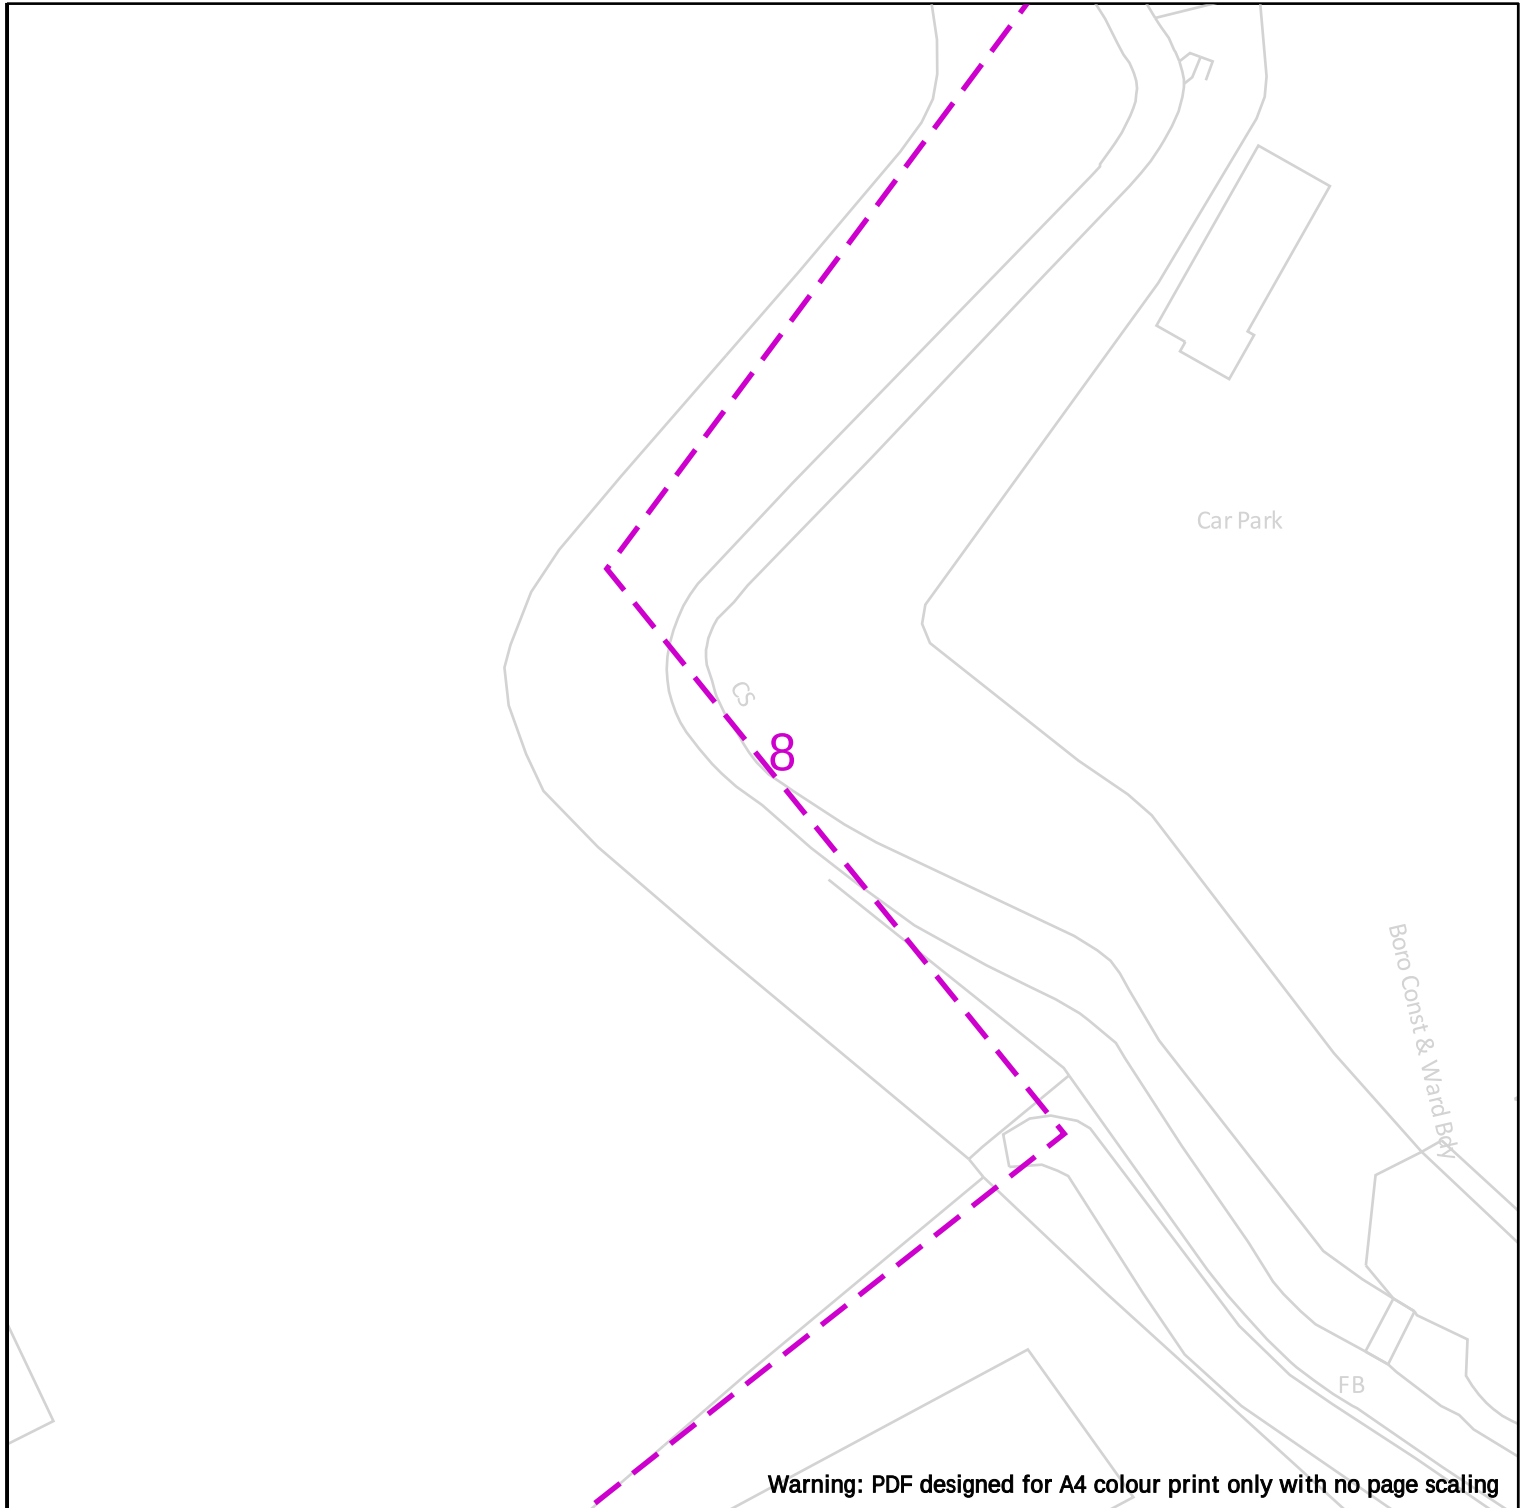

|   |   |
|---|---|
| <div><br/>Your Gas Network</div> | <div><div><div><div><div></div><div></div><div></div><div></div><div></div><div></div><div></div><div></div><div></div><div></div><div></div><div></div><div></div><div></div><div></div><div></div><div></div><div></div><div></div><div></div><div></div><div></div><div></div><div></div><div></div><div></div><div></div><div></div><div></div><div></div><div></div><dWarning: PDF designed for A4 colour print only with no page scaling

25m

Dig Sites

Area:



Line:



**Cadent**  
Your Gas Network



LP Mains



MP Mains



IP Mains



LHP Mains



Valve



Depth of cover



Syphon



Diameter Change



Material Change



Out of Standard Service

Date Requested: 13/09/2022  
Job Reference: 26909179  
Site Location: 345749 389975  
Requested by: Ms Carly Bower

Your Scheme/Reference:  
22/00284/OUT (CB)

View extent: 100m, 100m


#### IMPORTANT NOTICES

This plan shows these pipes owned by Cadent Gas Limited in its role as a Licensed Gas Transporter (GT). Gas pipes owned by other GT's or otherwise privately owned may be present in this area. Information with regards to such pipes should be obtained from the relevant owners. The information shown on this plan is given without warranty, the accuracy thereof cannot be guaranteed. Service pipes, valves, syphons, stub connections etc. are not shown but their presence should be anticipated. No liability of any kind whatsoever is accepted by Cadent Gas Limited or their agents, servants or contractors for any errors or omission. Safe digging practices, in accordance with HS(G)47, must be used to verify and establish the actual position of mains, pipes, services and other apparatus on site before any mechanical plant is used. It is your responsibility to ensure that this information is provided to all persons (either direct labour or contractors) working for you on or near gas apparatus. The information included on this plan should not be referred to beyond a period of 28 days from the date of issue.

**In case of emergency call - 0800 111 999**

Scale: 1:500 (When plotted at A4)

Crown Copyright © - This plan is reproduced from or based on the OS map by Cadent Gas Limited, with the sanction of the controller of HM Stationary Office. Crown Copyright Reserved. Ordnance Survey Licence number 100024886

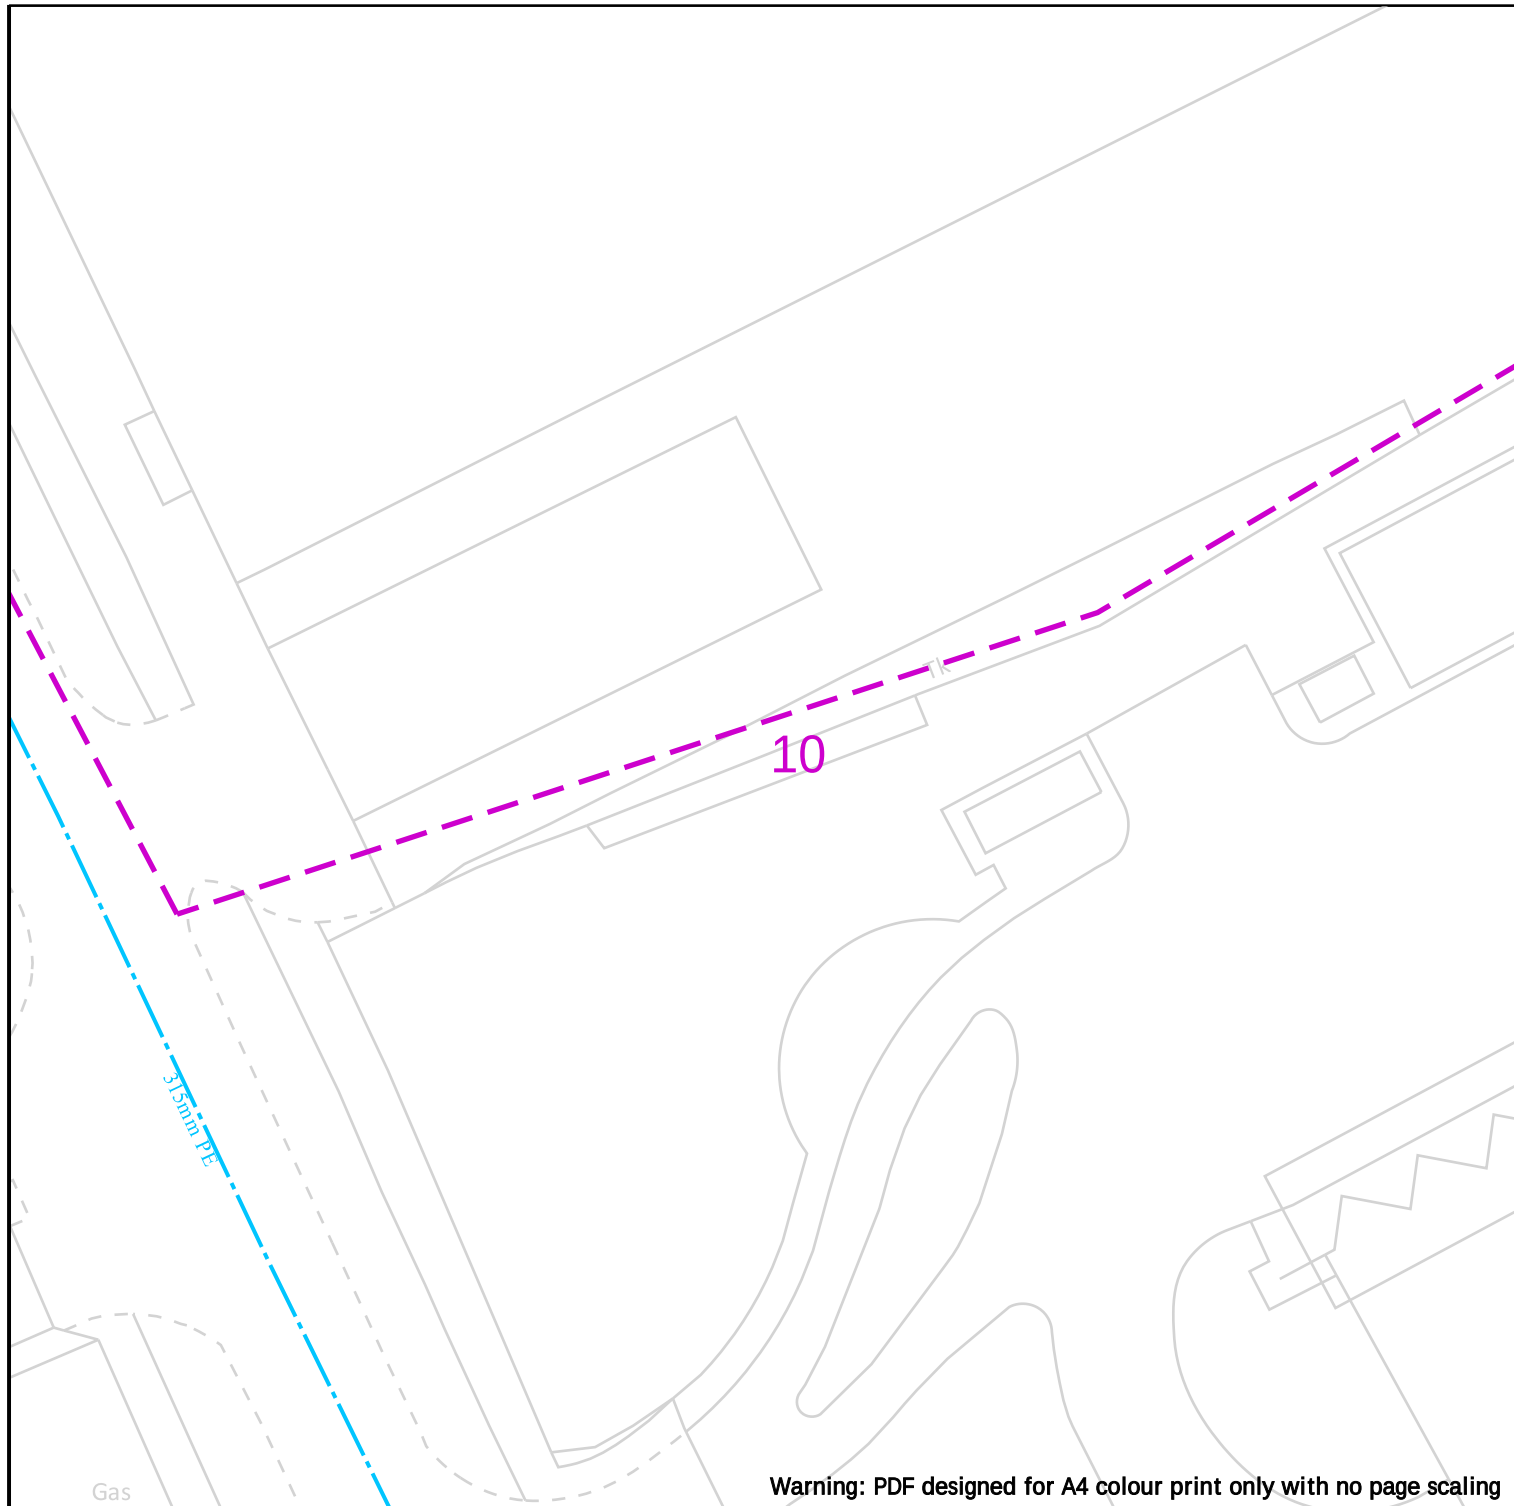

Warning: PDF designed for A4 colour print only with no page scaling

 25m

#### Dig Sites

Area:



Line:



**Cadent**  
Your Gas Network



LP Mains



MP Mains



IP Mains



LHP Mains



Valve



Depth of cover



Syphon



Diameter Change



Material Change



Out of Standard Service

Date Requested: 13/09/2022  
Job Reference: 26909179  
Site Location: 345749 389975  
Requested by: Ms Carly Bower

Your Scheme/Reference:  
22/00284/OUT (CB)

View extent: 100m, 100m


#### IMPORTANT NOTICES

This plan shows these pipes owned by Cadent Gas Limited in its role as a Licensed Gas Transporter (GT). Gas pipes owned by other GT's or otherwise privately owned may be present in this area. Information with regards to such pipes should be obtained from the relevant owners. The information shown on this plan is given without warranty, the accuracy thereof cannot be guaranteed. Service pipes, valves, syphons, stub connections etc. are not shown but their presence should be anticipated. No liability of any kind whatsoever is accepted by Cadent Gas Limited or their agents, servants or contractors for any errors or omission. Safe digging practices, in accordance with HS(G)47, must be used to verify and establish the actual position of mains, pipes, services and other apparatus on site before any mechanical plant is used. It is your responsibility to ensure that this information is provided to all persons (either direct labour or contractors) working for you on or near gas apparatus. The information included on this plan should not be referred to beyond a period of 28 days from the date of issue.

**In case of emergency call - 0800 111 999**

Scale: 1:500 (When plotted at A4)

Crown Copyright © - This plan is reproduced from or based on the OS map by Cadent Gas Limited, with the sanction of the controller of HM Stationary Office. Crown Copyright Reserved. Ordnance Survey Licence number 100024886

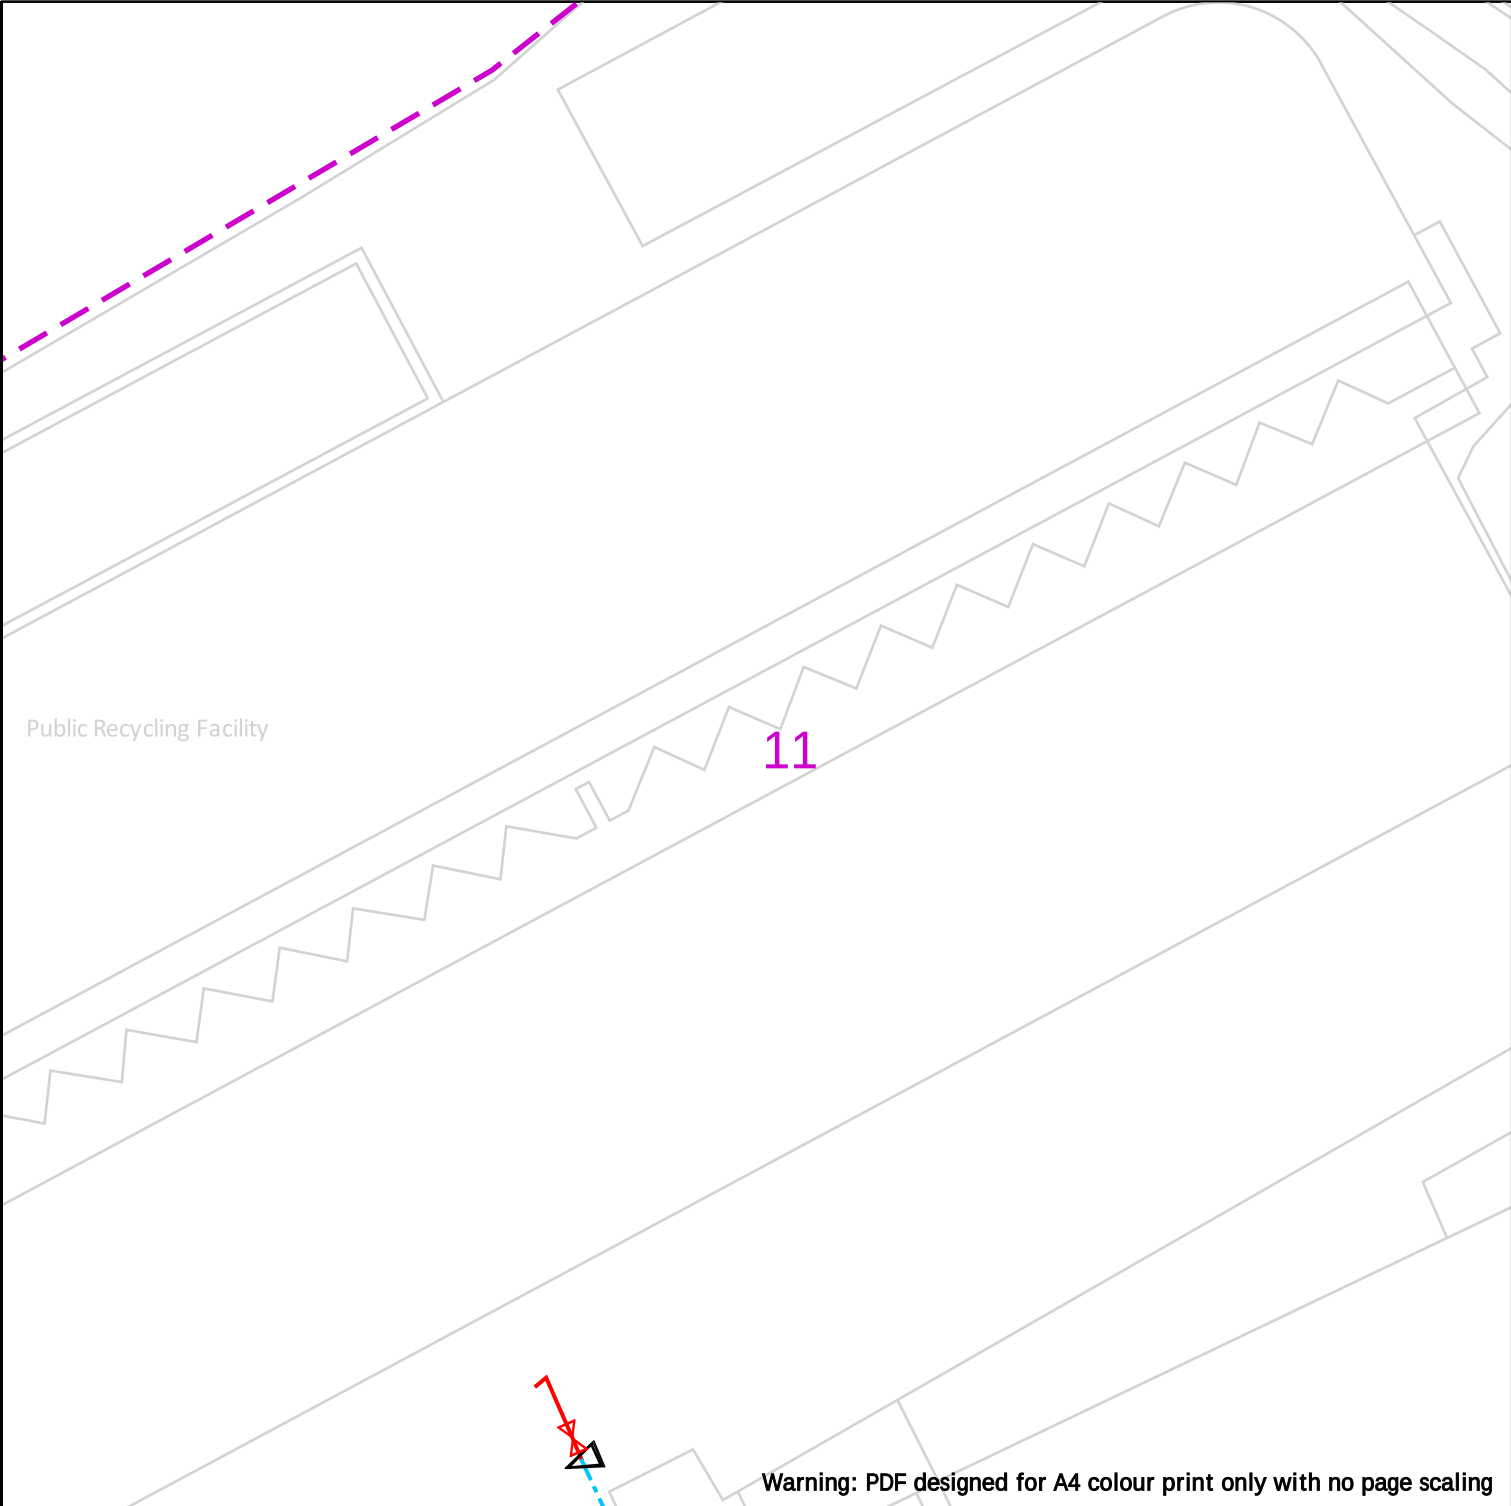

Warning: PDF designed for A4 colour print only with no page scaling



Date Requested: 13/09/2022  
Job Reference: 26909179  
Site Location: 345749 389975  
Requested by: Ms Carly Bower  
  
Your Scheme/Reference:  
22/00284/OUT (CB)  
  
View extent: 100m, 100m  
  
Scale: 1:500 (When plotted at A4)

| Dig Sites | Area:     | Line: |  |                         |
|-----------|-----------|-------|--|-------------------------|
|           | LP Mains  |       |  | Valve                   |
|           | MP Mains  |       |  | Depth of cover          |
|           | IP Mains  |       |  | Syphon                  |
|           | LHP Mains |       |  | Diameter Change         |
|           |           |       |  | Material Change         |
|           |           |       |  | Out of Standard Service |

**IMPORTANT NOTICES**

This plan shows these pipes owned by Cadent Gas Limited in its role as a Licensed Gas Transporter (GT). Gas pipes owned by other GT's or otherwise privately owned may be present in this area. Information with regards to such pipes should be obtained from the relevant owners. The information shown on this plan is given without warranty, the accuracy thereof cannot be guaranteed. Service pipes, valves, syphons, stub connections etc. are not shown but their presence should be anticipated. No liability of any kind whatsoever is accepted by Cadent Gas Limited or their agents, servants or contractors for any errors or omission. Safe digging practices, in accordance with HS(G)47, must be used to verify and establish the actual position of mains, pipes, services and other apparatus on site before any mechanical plant is used. It is your responsibility to ensure that this information is provided to all persons (either direct labour or contractors) working for you on or near gas apparatus. The information included on this plan should not be referred to beyond a period of 28 days from the date of issue.

**In case of emergency call - 0800 111 999**

Crown Copyright © - This plan is reproduced from or based on the OS map by Cadent Gas Limited, with the sanction of the controller of HM Stationary Office. Crown Copyright Reserved. Ordnance Survey Licence number 100024886